

## **ELEVATION REFERENCE MONUMENT**

**ERM:** 264  
**Panel:** 1455

**Elevation (NAVD88):** 4075.00  
**Elevation (NGVD29):** 4072.38

**Latitude:** 34°50'40" N  
**Longitude:** 111°52'09" W

**Description:** 0.5-inch diameter rebar, approximately 190 feet southeast of the corner of Pine Drive and Juniper Drive.

1455

**NATIONAL FLOOD INSURANCE PROGRAM**

**FIRM**  
**FLOOD INSURANCE RATE MAP**

**YAVAPAI COUNTY,  
ARIZONA AND  
INCORPORATED AREAS**

**PANEL 1455 OF 3925**  
(SEE MAP INDEX FOR PANELS NOT PRINTED)

<u>CONTAINS</u> <u>COMMUNITY</u>	<u>NUMBER</u>	<u>PANEL</u>	<u>SUFFIX</u>
SEDONA, CITY OF	040030	1455	F
YAVAPAI COUNTY UNINCORPORATED AREAS	040033	1455	F

**MAP NUMBER**  
**04025C1455 F**

**EFFECTIVE DATE:**  
**JUNE 6, 2001**



Federal Emergency Management Agency

A

B

111°52'30"  
34°52'30"

ELEVATION REFERENCE MARKS


REFERENCE MARK	ELEVATION (FEET NGVD)	DESCRIPTION OF LOCATION
----------------	-----------------------	-------------------------

RM263	3819.14	Aerial Mapping Company chiseled X at angle point in west edge of Cross Creek Ranch ford which crosses Oak Creek, approximately 2,400 feet west and approximately 500 feet south of the northeast corner of Section 33, T17N, R5E.
RM264	4072.38	0.5-inch diameter rebar, approximately 190 feet southeast of the corner of Pine Drive and Juniper Drive.

1

2


18

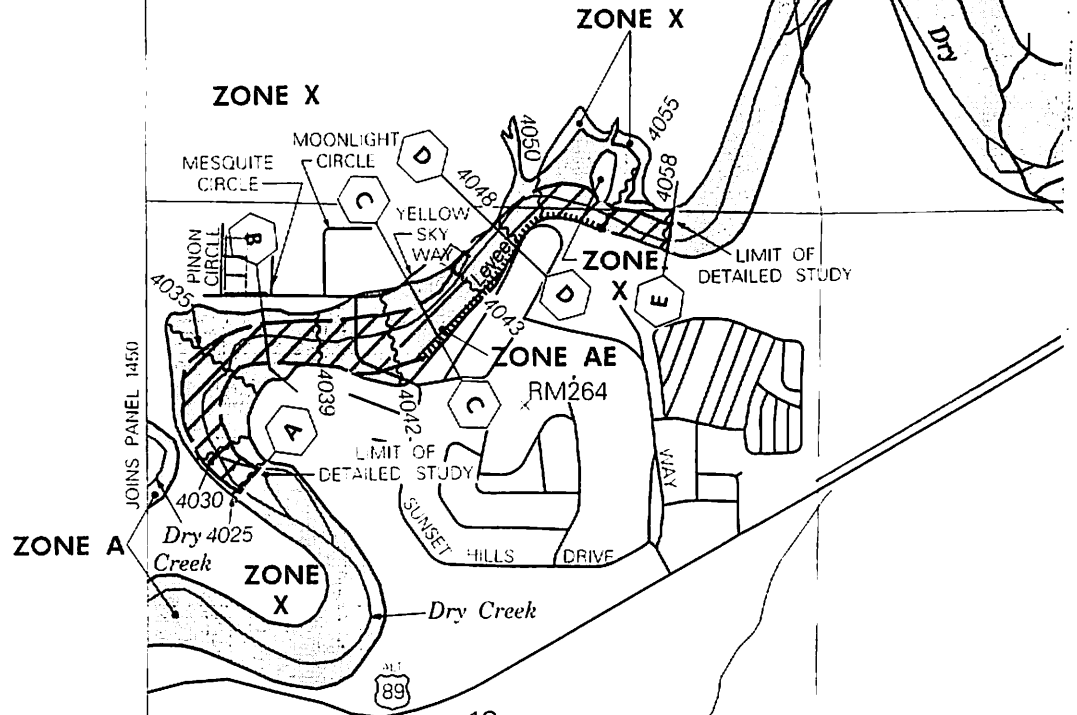

ZONE A

89

19

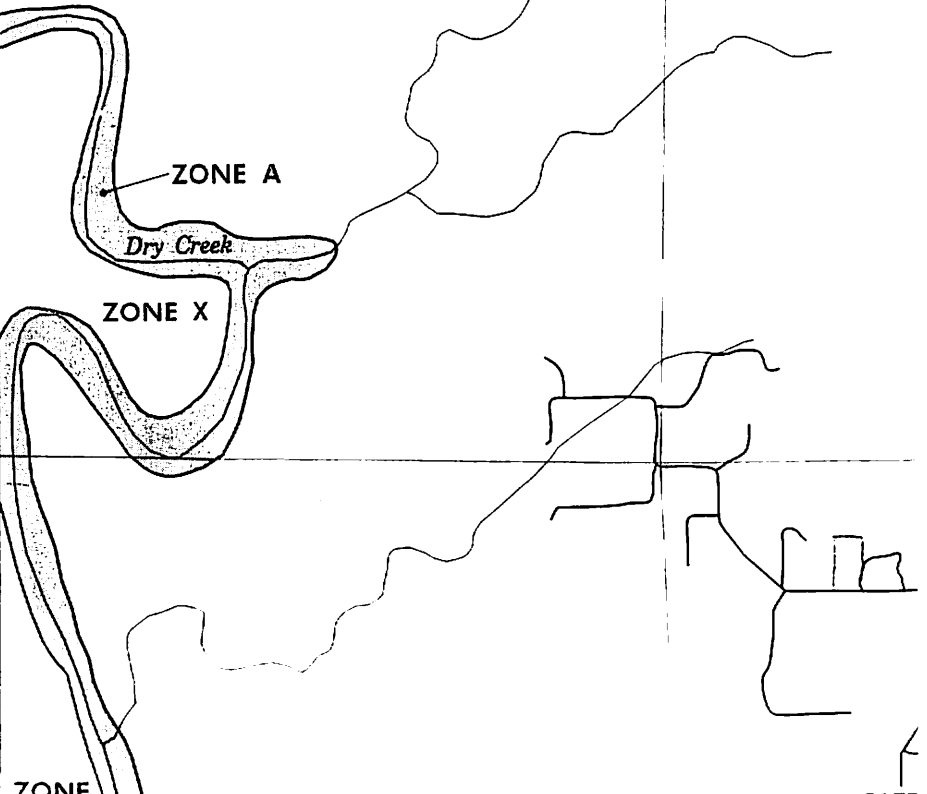

ZONE X

NOTE: MAP AREA SHOWN ON THIS PANEL IS LOCATED TOWNSHIP 17 NORTH RANGE 5 EAST

RED ROCK WAY

RM 264

Latitude: 34 50 39.055  
Longitude: -111 52 10.2213



1 in. = 100 ft.

December 20, 2008

04025C1455F

LOOP DR


PINE DR

JUNIPER DR

YUCCA DR

SUNSET HILLS DR

SUNSET HILLS CR

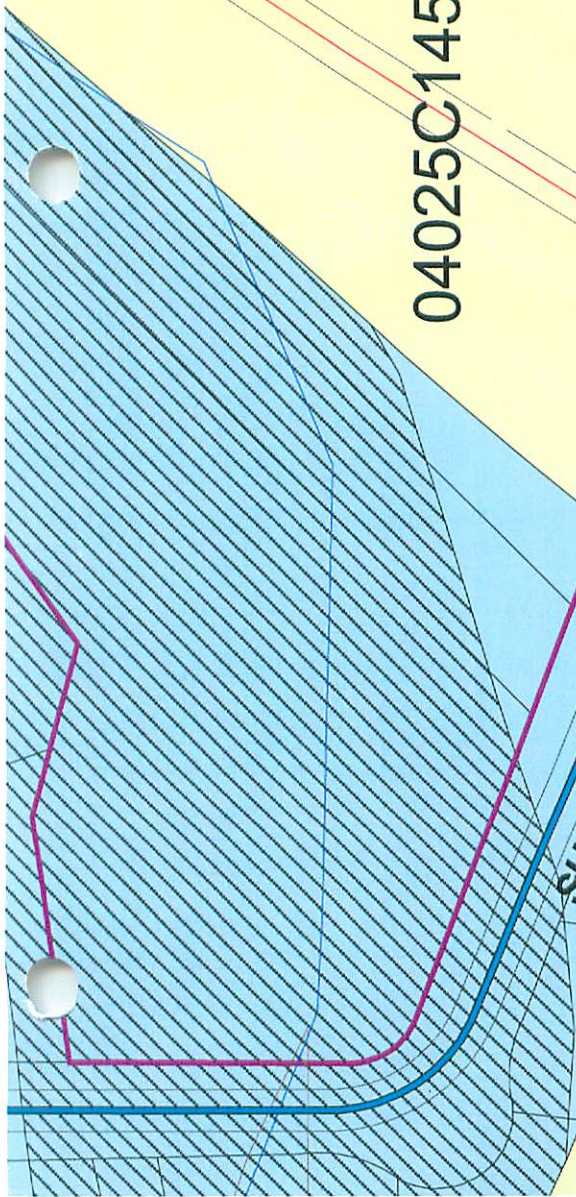

YCFC RM #	FEMA Map #	Suffix	Sec, T, R	County	Latitude	Longitude	1929 NGVD	1983 NAVD	NOTES
263	04025C1455	F	33 17 5 E	Yavapai	34 48.99574	111 50.34232	3,819.140	3,819.140	chisled X on W edge of Cross Cr Ranch ford
264	04025C1455	F	19 17 5 E	Yavapai	34 4.65092	111 52.17036	4,072.380	4,072.380	190' SE corner of Pine & Juniper Dr
493 B	04025C1455	F	20 17 5 E	Yavapai	34 50.66666	111 50.93333	4,177.632	4,180.250	disk set in rock outcrop stamped B 493 1982