

ELEVATION REFERENCE MONUMENT

ERM: 127

Panel: 1840

Elevation (NAVD88): 3369.10

Elevation (NGVD29): 3366.71

Latitude: 34°37'43" N

Longitude: 111°49'15" W

Description: Aerial Mapping Company 1/2-inch rebar with aluminum cap, approximately 135 feet southeast of Y intersection of dirt roads, approximately 65 feet east of upper road, approximately 110 feet northeast of gate, approximately 127 feet north of wire fence, approximately 160 feet northeast of flowline of small wash, approximately 200 feet north and approximately 1,300 feet west of approximate southeast corner of Section 4, T14N, R5E.

1870

NATIONAL FLOOD INSURANCE PROGRAM

ORIGINAL

**FIRM
FLOOD INSURANCE RATE MAP**

**YAVAPAI COUNTY,
ARIZONA AND
INCORPORATED AREAS**

PANEL 1840 OF 3925
(SEE MAP INDEX FOR PANELS NOT PRINTED)

<u>CONTAINS COMMUNITY</u>	<u>NUMBER</u>	<u>PANEL</u>	<u>SUFFIX</u>
CAMP VERDE TOWN OF YAVAPAI COUNTY	040193	1840	F
UNINCORPORATED AREAS	040193	1840	F

**MAP NUMBER
04025C1840 F**

**EFFECTIVE DATE:
JUNE 6, 2001**




Federal Emergency Management Agency

ELEVATION REFERENCE MARKS
 REFERENCE ELEVATION
 MARK (FEET NGVD) DESCRIPTION OF LOCATION

REFERENCE MARK	ELEVATION (FEET NGVD)	DESCRIPTION OF LOCATION
RM104	3257.07	Aerial Mapping Company 1/2-inch rebar with aluminum cap stamped WBC-BM 101 located 1/2 foot north of the north corner of the southeast end abutment of the footbridge over Wet Beaver Creek, approximately 2,200 feet east and approximately 1,100 feet north of the southwest corner of Section 4, T14N, R5E.
RM127	3366.71	Aerial Mapping Company 1/2-inch rebar with aluminum cap, approximately 135 feet southeast of Y intersection of dirt roads, approximately 65 feet east of upper road, approximately 110 feet northeast of gate, approximately 127 feet north of wire fence, approximately 160 feet northeast of flowline of small wash, approximately 200 feet north and approximately 1,300 feet west of approximate southeast corner of Section 4, T14N, R5E.


111°52'30"
 34°41'15"

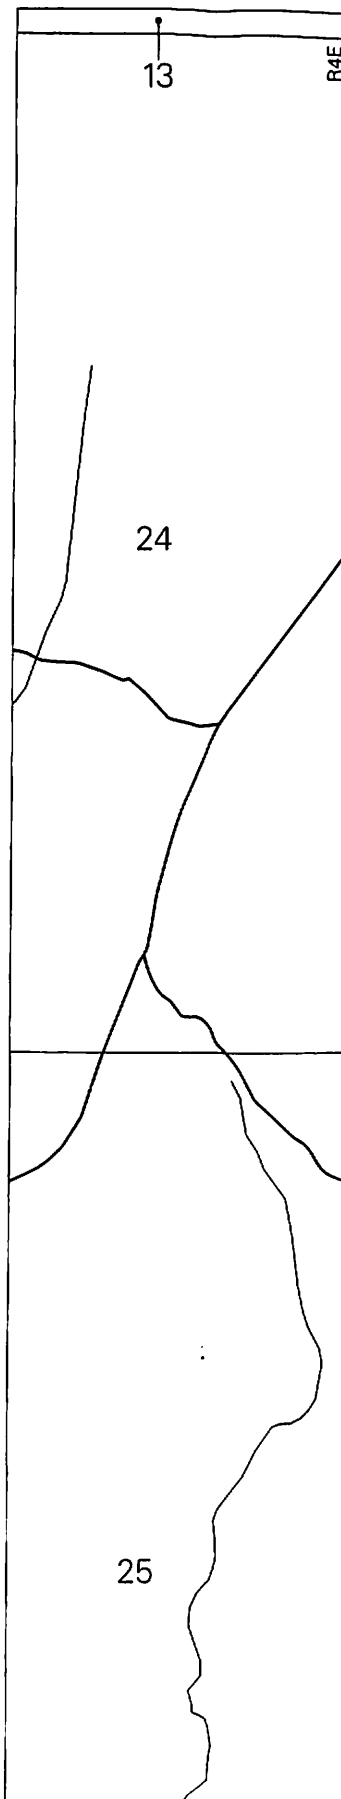

1

2

3

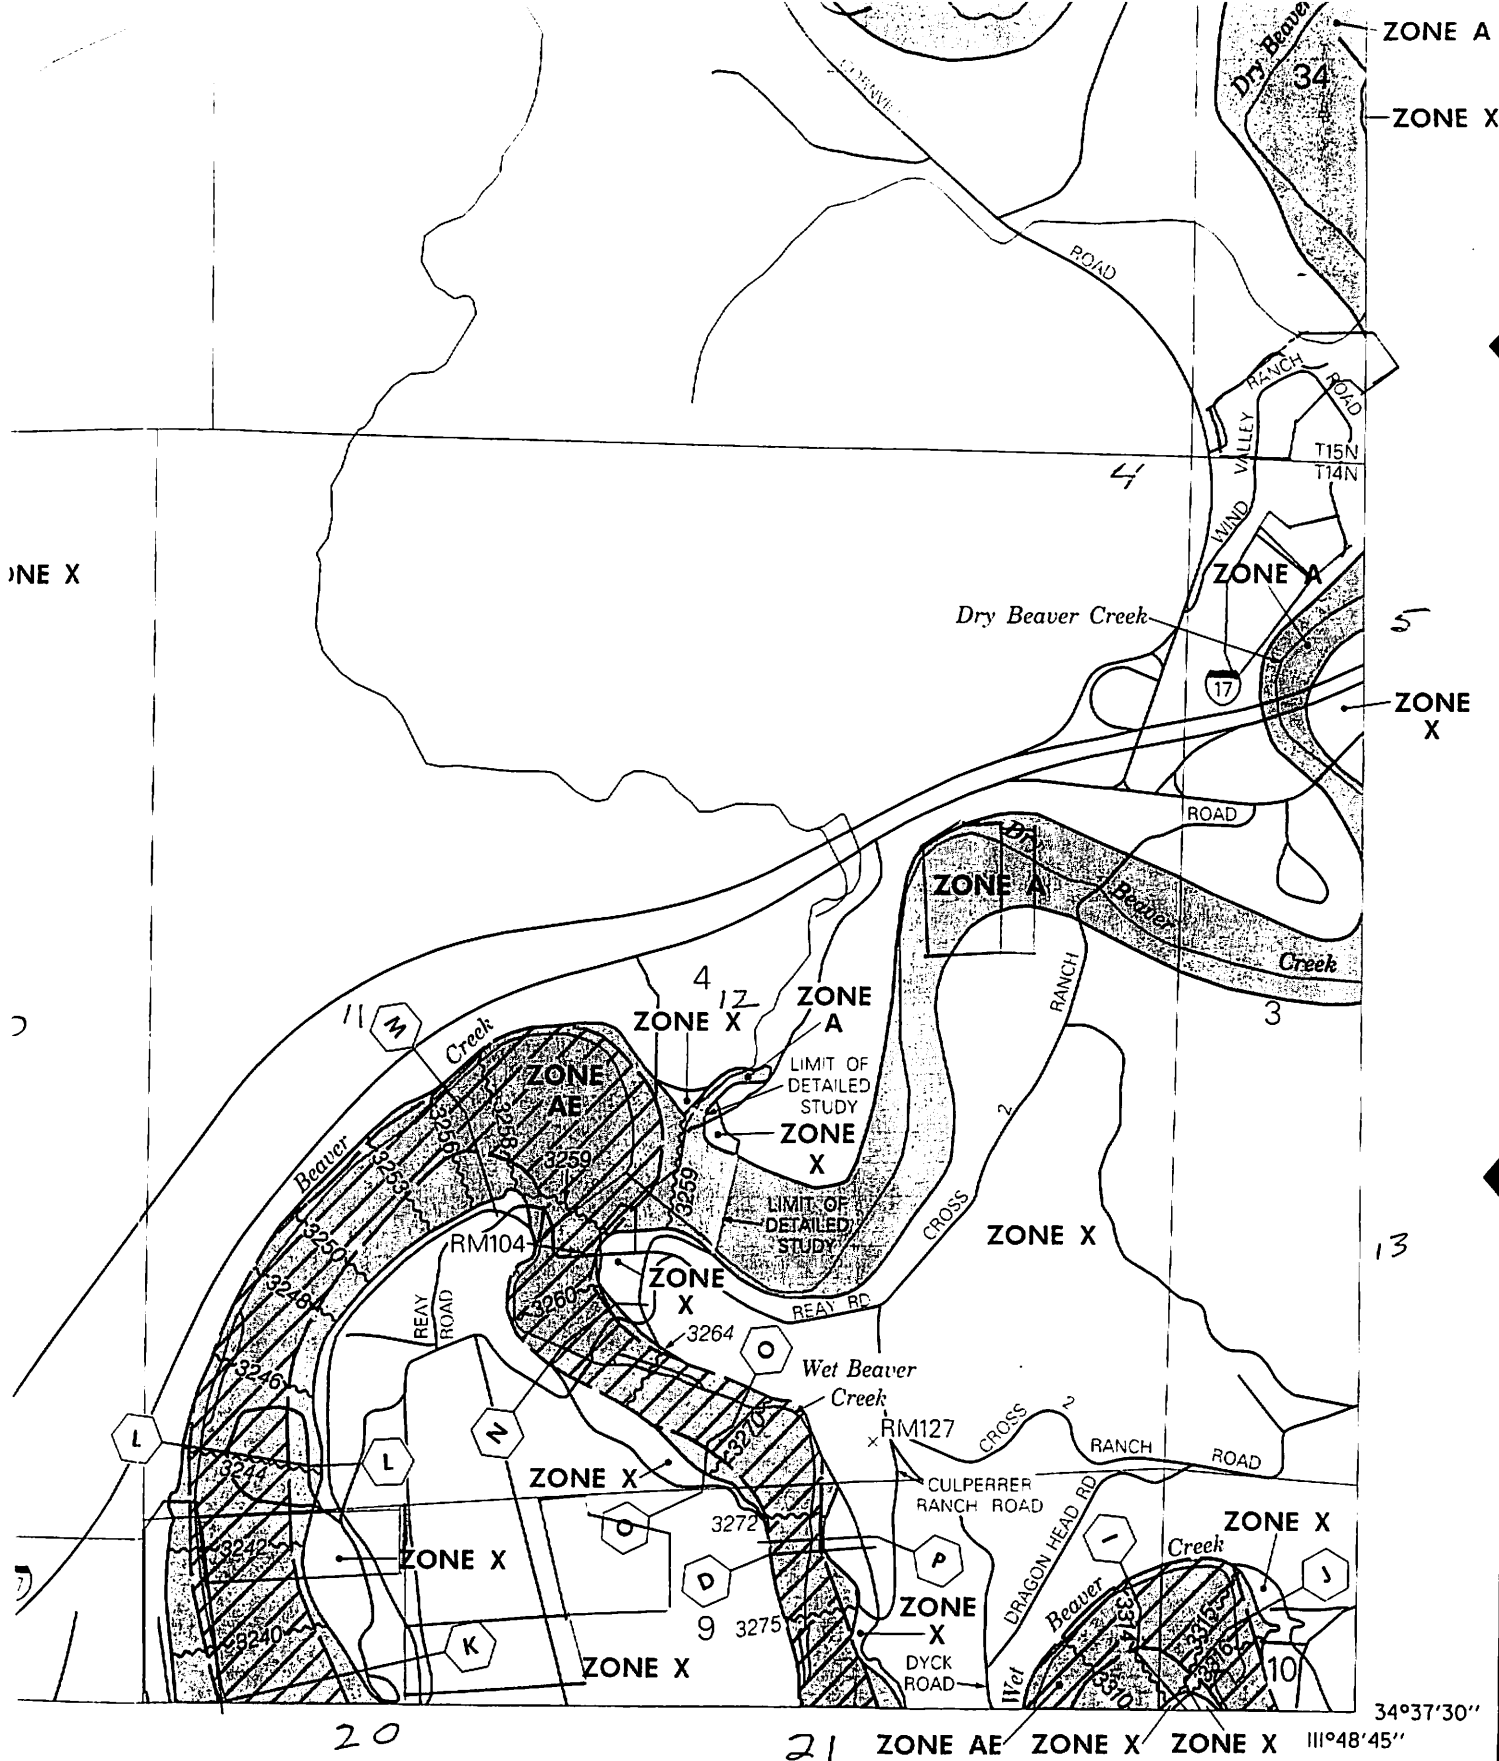

Lake Montezuma

Sec LOMAR
10-28-04

34°37'30"

111°48'45"

22

20

21

ZONE AE ZONE X ZONE X