

ELEVATION REFERENCE MONUMENT

ERM: 128

Panel: 1845

Elevation (NAVD88): 3415.91

Elevation (NGVD29): 3413.51

Latitude: 34°37'46" N

Longitude: 111°47'11" W

Description: Aerial Mapping Company chiseled square on the northwest corner of the bridge over Russell Wash on Lake Shore Drive, approximately 750 feet north and approximately 1,500 feet west of the southeast corner of Section 2, T14N, R5E.

1845

NATIONAL FLOOD INSURANCE PROGRAM

FIRM ORIGINAL
FLOOD INSURANCE RATE MAP

**YAVAPAI COUNTY,
ARIZONA AND
INCORPORATED AREAS**

PANEL 1845 OF 3925

(SEE MAP INDEX FOR PANELS NOT PRINTED)

<u>CONTAINS</u> <u>COMMUNITY</u>	<u>NUMBER</u>	<u>PANEL</u>	<u>SUFFIX</u>
YAVAPAI COUNTY, UNINCORPORATED AREAS	040283	1845	F

**MAP NUMBER
04025C1845 F**


**EFFECTIVE DATE:
JUNE 6, 2001**



Federal Emergency Management Agency

ELEVATION REFERENCE MARKS
REFERENCE ELEVATION MARK (FEET NGVD) DESCRIPTION OF LOCATION

- 1
- RM128 3413.51 Aerial Mapping Company chiseled square on the northwest corner of the bridge over Russell Wash on Lake Shore Drive, approximately 750 feet north and approximately 1,500 feet west of the southeast corner of Section 2, T14N, R5E.
 - RM129 3440.86 Aerial Mapping Company chiseled X in the south end of the west headwall of the bridge on Montezuma Avenue over Wet Beaver Creek, approximately 650 feet south and approximately 500 feet east of approximate northwest corner of Section 1, T14N, R5E.
 - RM130 3569.93 U.S. Army. Corps of Engineers 5/8-inch rebar with aluminum cap stamped USCE WB8 1977 LA DIST, 24 feet south southeast from power pole by trail, 71 feet north of power pole by dirt road, 88 feet from Juniper tree.
 - RM131 3361.05 Aerial Mapping Company 1/2-inch rebar with aluminum cap stamped WBC-BM 102, located in midst of large Indian Lakes sign, set in block foundation, on north side of Rimrock Drive approximately 800 feet southwest from Montezuma Avenue approximately 400 feet east and approximately 100 feet south of the northwest corner of Section 11, T14N, R5E.
 - ~~RM132 3453.34~~ Aerial Mapping Company 1/2-inch rebar with aluminum cap stamped WBC-BM 103, in approximate centerline of Montezuma Avenue, approximately 100 feet north of Redrock Drive and 21 feet west of power pole number VD 594, located approximately 1,000 feet east and approximately 100 feet north of the southwest corner of Section 1, T14N, R5E.
*Reset RM 132A
3453.10
see RM Book*
 - RM133 3411.69 Aerial Mapping Company 1/2-inch rebar with aluminum cap stamped WBC-BM 104, 6 feet north of the centerline of Cottonwood Drive, and 33 feet west of the centerline of Sycamore Lane, and approximately 950 feet west and approximately 2,300 feet south of the northeast corner Section 2, T14N, R5E.
 - RM134 3473.96 Aerial Mapping Company 1/2-inch rebar with aluminum cap stamped WBC-BM 105, in centerline of Kramer Drive, 33 feet east of power pole, 24 feet south of down guy, west of the intersection of Bentley and Kramer Drives, approximately 3,350 feet east and approximately 1,150 feet north of the southwest corner of Section 36, T156N, R5E.
- 2
- 3
-

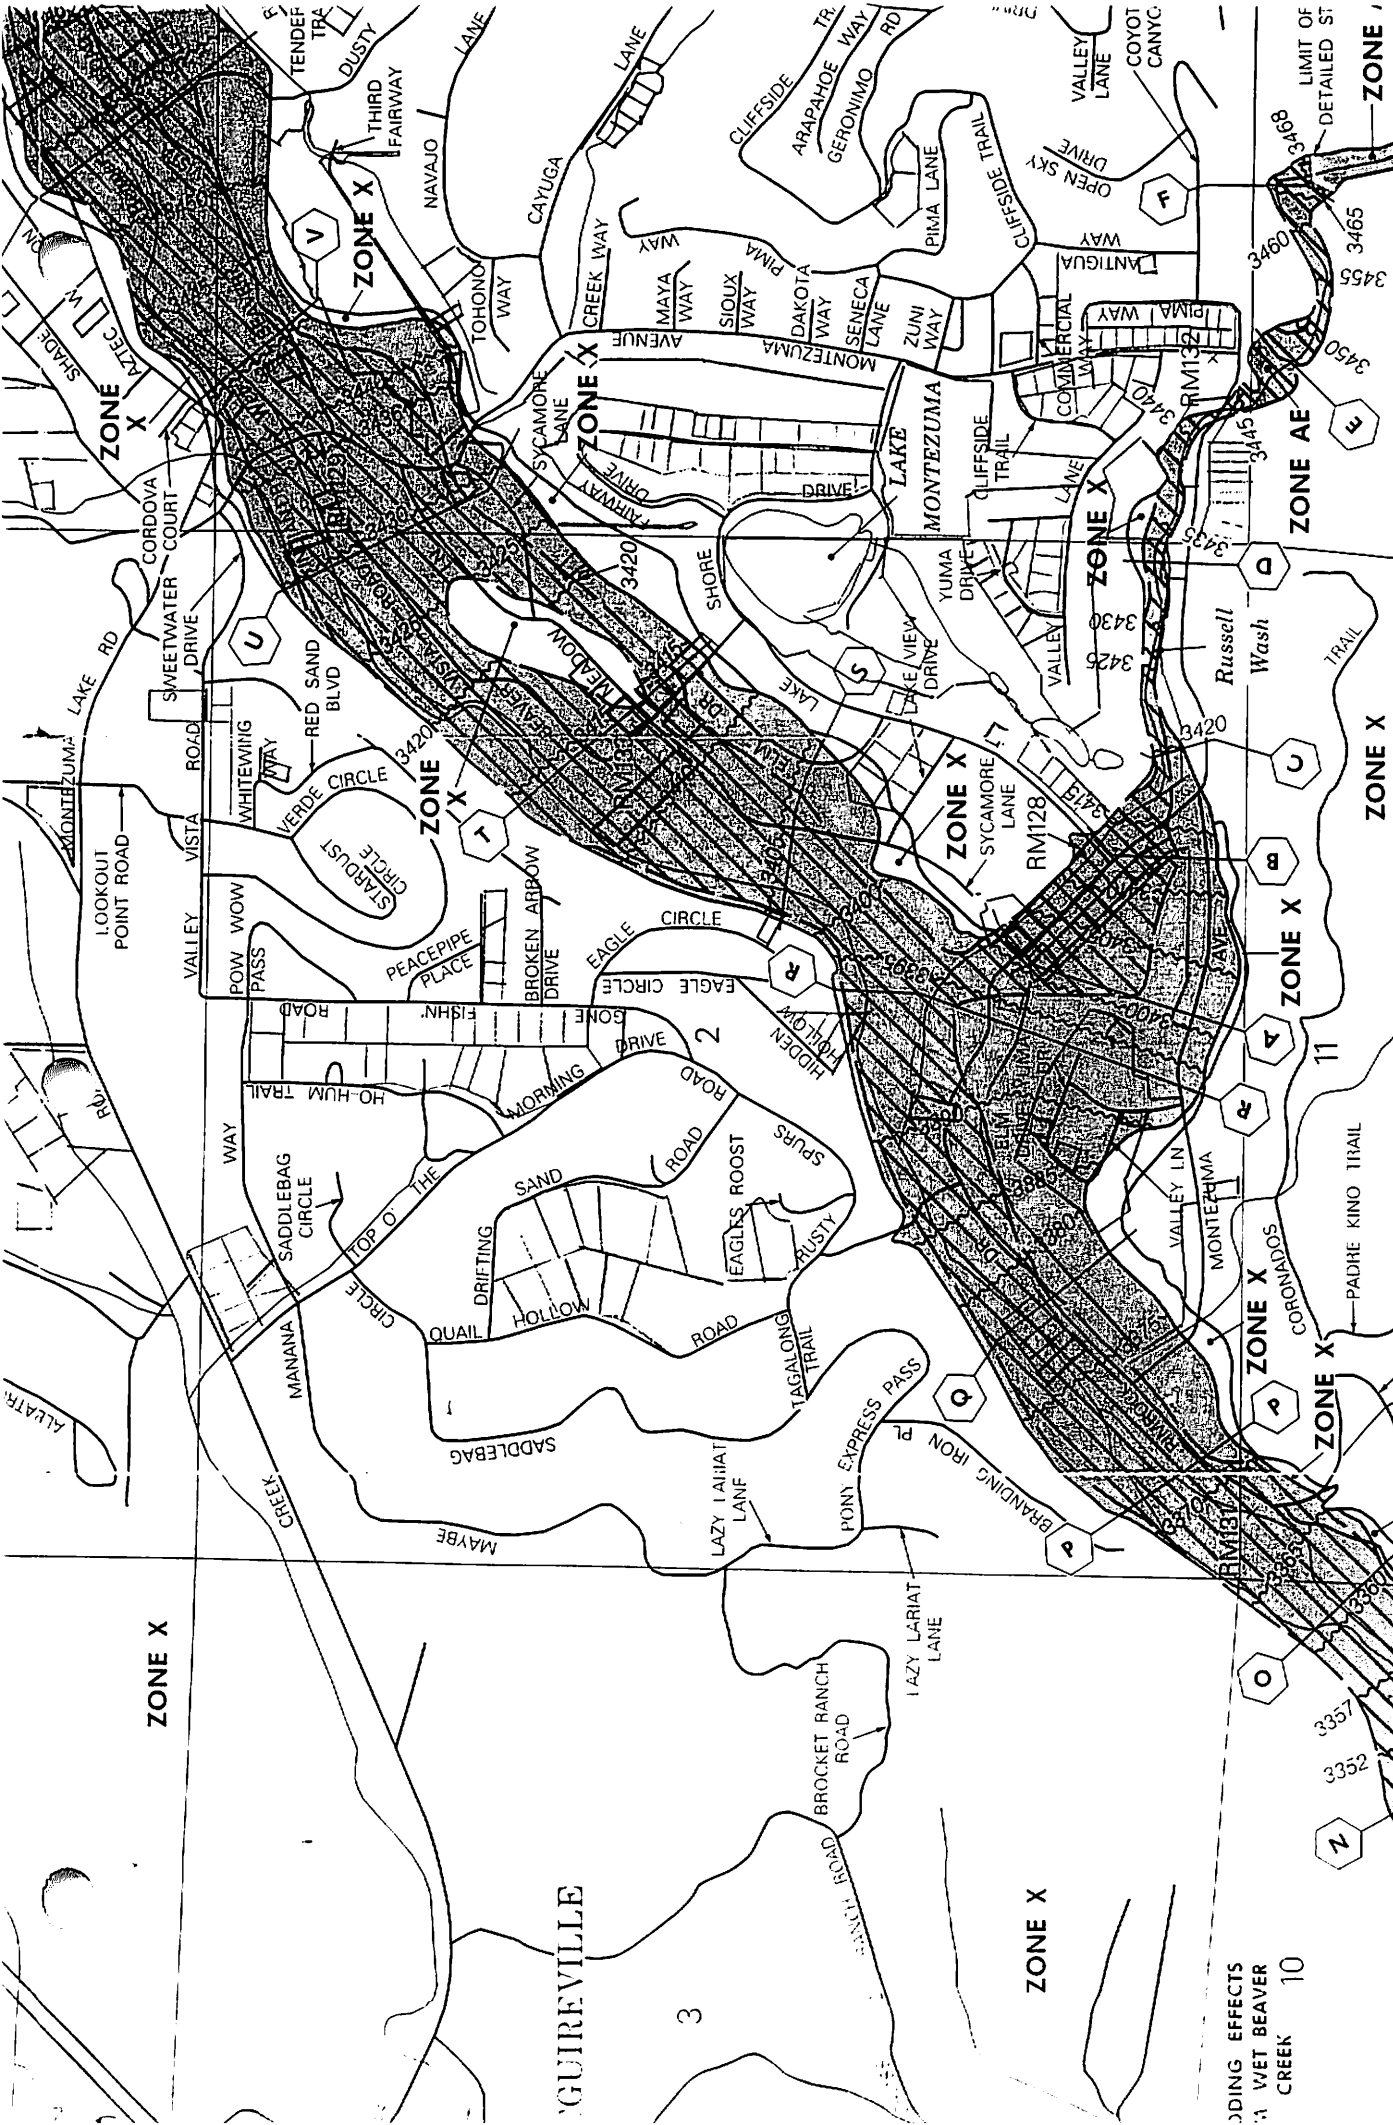

JOHNS PANEL 2210

See Late Montez

ZONE X BILL WILLIAMS TRAIL

04

ZONE X

GUIREVILLE

ZONE X

ADDITIONAL EFFECTS
WET BEAVER
CREEK 10

10