

## ELEVATION REFERENCE MONUMENT

**ERM:** 124  
**Panel:** 2215

**Elevation (NAVD88):** 3099.42  
**Elevation (NGVD29):** 3097.05

**Latitude:** 34°32'53" N  
**Longitude:** 111°52'01" W

**Description:** A square bolt. From the intersection of Salt Mine Road and Woods Ditch, go south to the end of the dirt road and to the bridge over Woods Ditch. Station is located at the east end of the north headwall.

ACE

2215

**NATIONAL FLOOD INSURANCE PROGRAM**

**FIRM**

**FLOOD INSURANCE RATE MAP**

**YAVAPAI COUNTY,  
ARIZONA AND  
INCORPORATED AREAS**

**PANEL 2215 OF 3925**

(SEE MAP INDEX FOR PANELS NOT PRINTED)

CONTAINS

COMMUNITY

NUMBER

PANEL

SUFFIX

CAMP VERDE TOWN OF  
YAVAPAI COUNTY  
UNINCORPORATED AREAS

040121

2215

F

040093

2215

F

**MAP NUMBER  
04025C2215 F**

**EFFECTIVE DATE:  
JUNE 6, 2001**



Federal Emergency Management Agency

A


B

III°52'30"  
34°33'45"

**ELEVATION REFERENCE MARKS**

REFERENCE MARK	ELEVATION (FEET NGVD)	DESCRIPTION OF LOCATION
RM109	3079.40	U.S. Army Corps of Engineers 5/8-inch rebar with aluminum cap stamped USCE VR 41 1977 LA DIST, 90 feet northwest of fence, 17 feet northeast of Fort McDowell Place.
RM110	3072.74	U.S. Army Corps of Engineers 5/8-inch rebar with aluminum cap stamped USCE BM 5 1977 LA DIST, 13 feet southwest of highway, 14 feet southeast of powerpole, 7 feet northeast of fence.
RM115	3101.70	Aerial Mapping Company 1/2-inch rebar with aluminum cap stamped VR-BM 108, at the southwest quadrant of the intersection of Murdock Lane and Pioneer Drive, 0.5 foot north of the west cedar post fence corner, approximately 1,800 feet west and approximately 1,250 feet north of the southeast corner of Section 32, T14N, R5E.
RM116	3055.69	Aerial Mapping Company 1/2-inch rebar with aluminum cap stamped VR-BM 109, at the southeast fence corner of fence along the north side of Fir Street, approximately 350 feet east of Pearl Drive, approximately 1,900 feet east and approximately 1,300 feet south of the northwest corner of Section 7 T13N, R5E.
RM120	3086.67	From Camp Verde go southeast on General Crook Trail to the bridge over the Verde River. Station is located on the wall at the northwest corner of the bridge over the Verde River. Station is a brass cap.
RM124	3097.05	From the intersection of Salt Mine Road and Wood's Ditch, go south to the end of the dirt road and to the bridge over Wood's Ditch. Station is located at the east end of the north headwall. Station is a square bolt.
RM126	3098.75	From the intersection of Salt Mine Road and General Crook Trail, go west to Copper Canyon Wash and proceed south along Salt Mine Road approximately 1 mile to Lucky Canyon Wash. Station is located on the west bulkhead of a steel bridge. Station is the last river south in the center section of the bridge.
RM149	3044.40	U.S. Army Corps of Engineers 5/8-inch rebar with aluminum cap stamped USCE BM 14 1977 LA DIST, 28 feet southwest of Salt Mine Road, 62 feet north of fence.
RM150	3039.53	U.S. Army Corps of Engineers 5/8-inch rebar with aluminum cap stamped USCE BM 17 1977 LA DIST, 8 feet north-northeast from power pole at Y in dirt roads, 9 feet east of road.
RM151	3046.97	U.S. Army Corps of Engineers 5/8-inch rebar with aluminum cap stamped USCE RM 7 1977 LA DIST, 10 feet north-northeast from power pole at Y in dirt roads, 9 feet east of road.

- 1
- 2
- 2

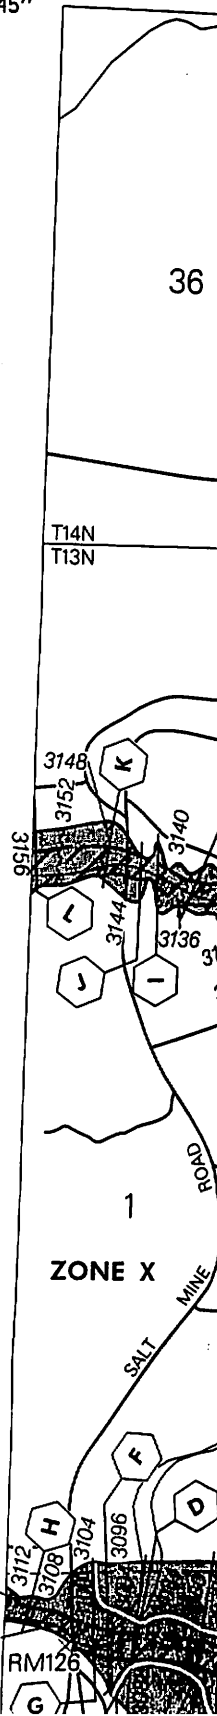

Corps of Engineers 5/8-inch aluminum cap stamped with 1977 LA DIST, 13 of highway, 14 feet of powerpole, 7 feet of fence.

Company 1/2-inch aluminum cap stamped at the southwest corner of the intersection of Pioneer Drive, 0.5 mile west of the west cedar post, approximately 1,800 feet, approximately 1,250 feet, T14N, R5E.

Company 1/2-inch aluminum cap stamped VR- the southeast fence along the north Street, approximately east of Pearl Drive, 1,900 feet east and 1,300 feet south of the corner of Section 7.

Verde go southeast on Salt Mine Road to the bridge over the river. Station is at the southeast corner of the bridge over the river. Station is a square.

Intersection of Salt Mine Road and S Ditch, go south to the dirt road and to the southeast corner of the intersection of the dirt road and the east end of the ditch. Station is a square.

Intersection of Salt Mine Road and S Ditch, go south to the dirt road and to the southeast corner of the intersection of the dirt road and the east end of the ditch. Station is a square.

Corps of Engineers aluminum cap stamped with 1977 LA DIST, 28 of Salt Mine Road, 7 feet of fence.


Corps of Engineers aluminum cap stamped with 1977 LA DIST, 8 of Salt Mine Road, 9 feet of fence.

Corps of Engineers aluminum cap stamped with 1977 LA DIST, 7 of Salt Mine Road, 9 feet of fence.

Company chiseled box end of the concrete driveway to address 3 Box 185-B, at the southeast corner, approximately 1,800 feet, approximately 1,250 feet, T13N, R5E.

Company 1/2-inch aluminum cap stamped VR- the southeast fence along the north Street, approximately east of Pearl Drive, 1,900 feet east and 1,300 feet south of the corner of Section 7.

Company 1/2-inch aluminum cap stamped VR- the southeast fence along the north Street, approximately east of Pearl Drive, 1,900 feet east and 1,300 feet south of the corner of Section 7.

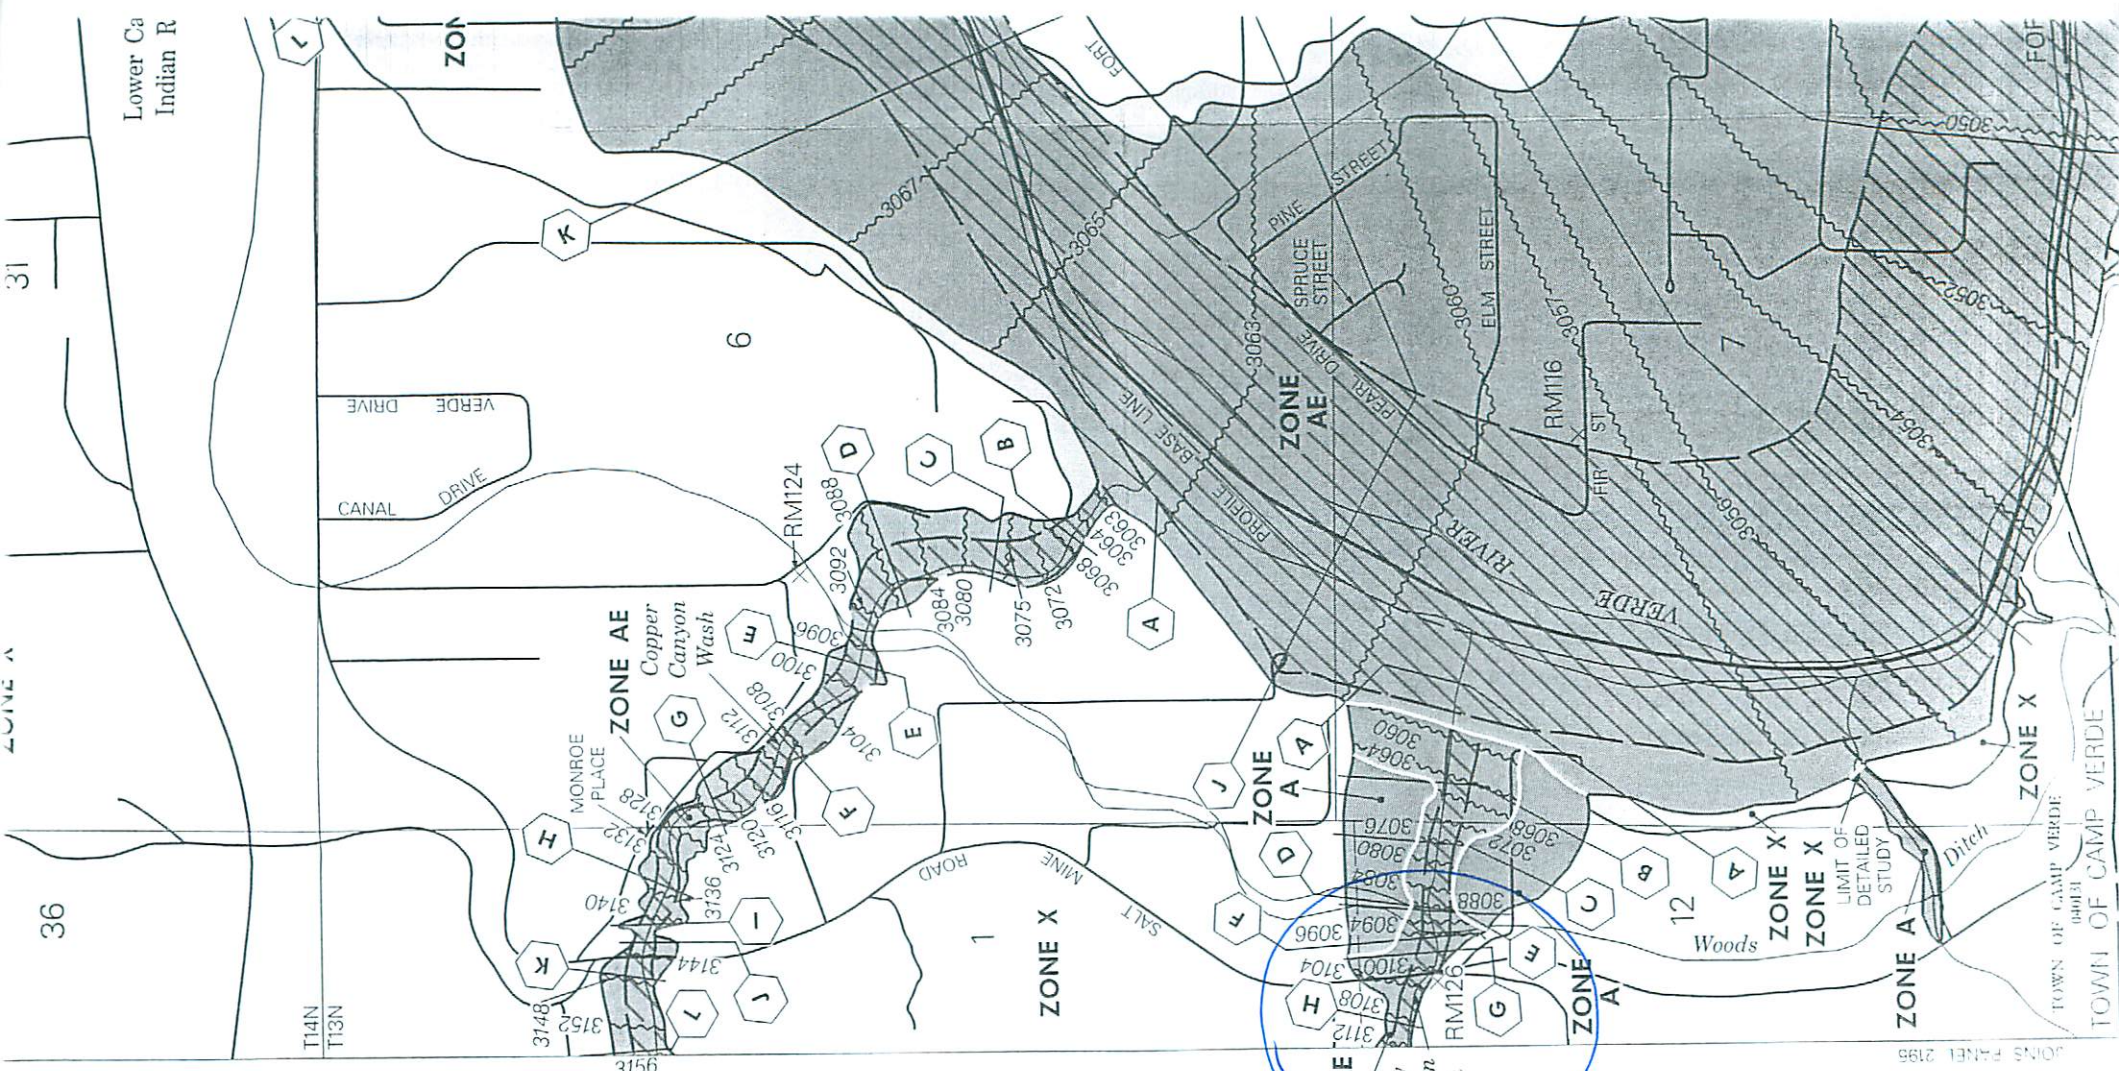

JOINS PANEL 2189

TOWN OF CAMP VERDE  
TOWN OF CAMP VERDE

Lower Ca  
Indian R

36

31

T14N  
T13N

VERDE DRIVE  
CANAL DRIVE

ZONE AE  
Copper Canyon Wash

ZONE X

ZONE AE

ZONE AE  
Lucky Canyon Wash

ZONE A

ZONE X  
Woods

ZONE A

ZONE X

TOWN OF CAMP VERDE

ZONE X

6

1

12

FOF

FOF

3052

3054

3056

3450