

## ELEVATION REFERENCE MONUMENT

**ERM:** 156

**Panel:** 2220

**Elevation (NAVD88):** 3143.78

**Elevation (NGVD29):** 3141.47

**Latitude:** 34°31'39" N

**Longitude:** 111°47'35" W

**Description:** 5/8-inch rebar with aluminum cap stamped Yavapai County Flood Control District (WCC2) approximately 1,501 feet southeast of southwest 1/16 of Section 11, approximately 99 feet south of another power pole approximately 20 feet east of paved street and approximately 109 feet northeast of intersection of Verde Lakes Drive and Aberdovey Drive.

2220

**NATIONAL FLOOD INSURANCE PROGRAM**

**FIRM**  
**FLOOD INSURANCE RATE MAP**

**YAVAPAI COUNTY,  
ARIZONA AND  
INCORPORATED AREAS**

**PANEL 2220 OF 3925**

(SEE MAP INDEX FOR PANELS NOT PRINTED)

CONTAINS:  
COMMUNITY

NUMBER PANEL SUFFIX

CAMP VERDE TOWN OF  
YAVAPAI COUNTY,  
UNINCORPORATED AREAS

040131 2220 F  
040093 2220 F

**MAP NUMBER**  
**04025C2220 F**

**EFFECTIVE DATE:**  
**JUNE 6, 2001**



Federal Emergency Management Agency

13N S/6 E A 5

B

34°33'45"  
111°48'45"

**ELEVATION REFERENCE MARKS**

REFERENCE MARK	ELEVATION (FEET NGVD)	DESCRIPTION OF LOCATION
----------------	-----------------------	-------------------------

RM155	3205.32	Set 5/8-inch rebar with aluminum cap stamped Yavapai County Flood Control District (WCC1) 8 feet west of telephone riser, approximately 71 feet southeast of power box on pedestal, approximately 355 feet northeast of W1/4 corner Section 13, T13N, R5E.
RM156	3141.47	Set 5/8-inch rebar with aluminum cap stamped Yavapai County Flood Control District (WCC2) approximately 1,501 feet southeast of southwest 1/16 of Section 11, approximately 99 feet south of another power pole approximately 20 feet east of paved street and approximately 109 feet northeast of intersection of Verde Lakes Drive and Aberdovey Drive.

T14N  
T13N

YAVA  
TOWN


1

2

ZONE A 10

11

ZONE X

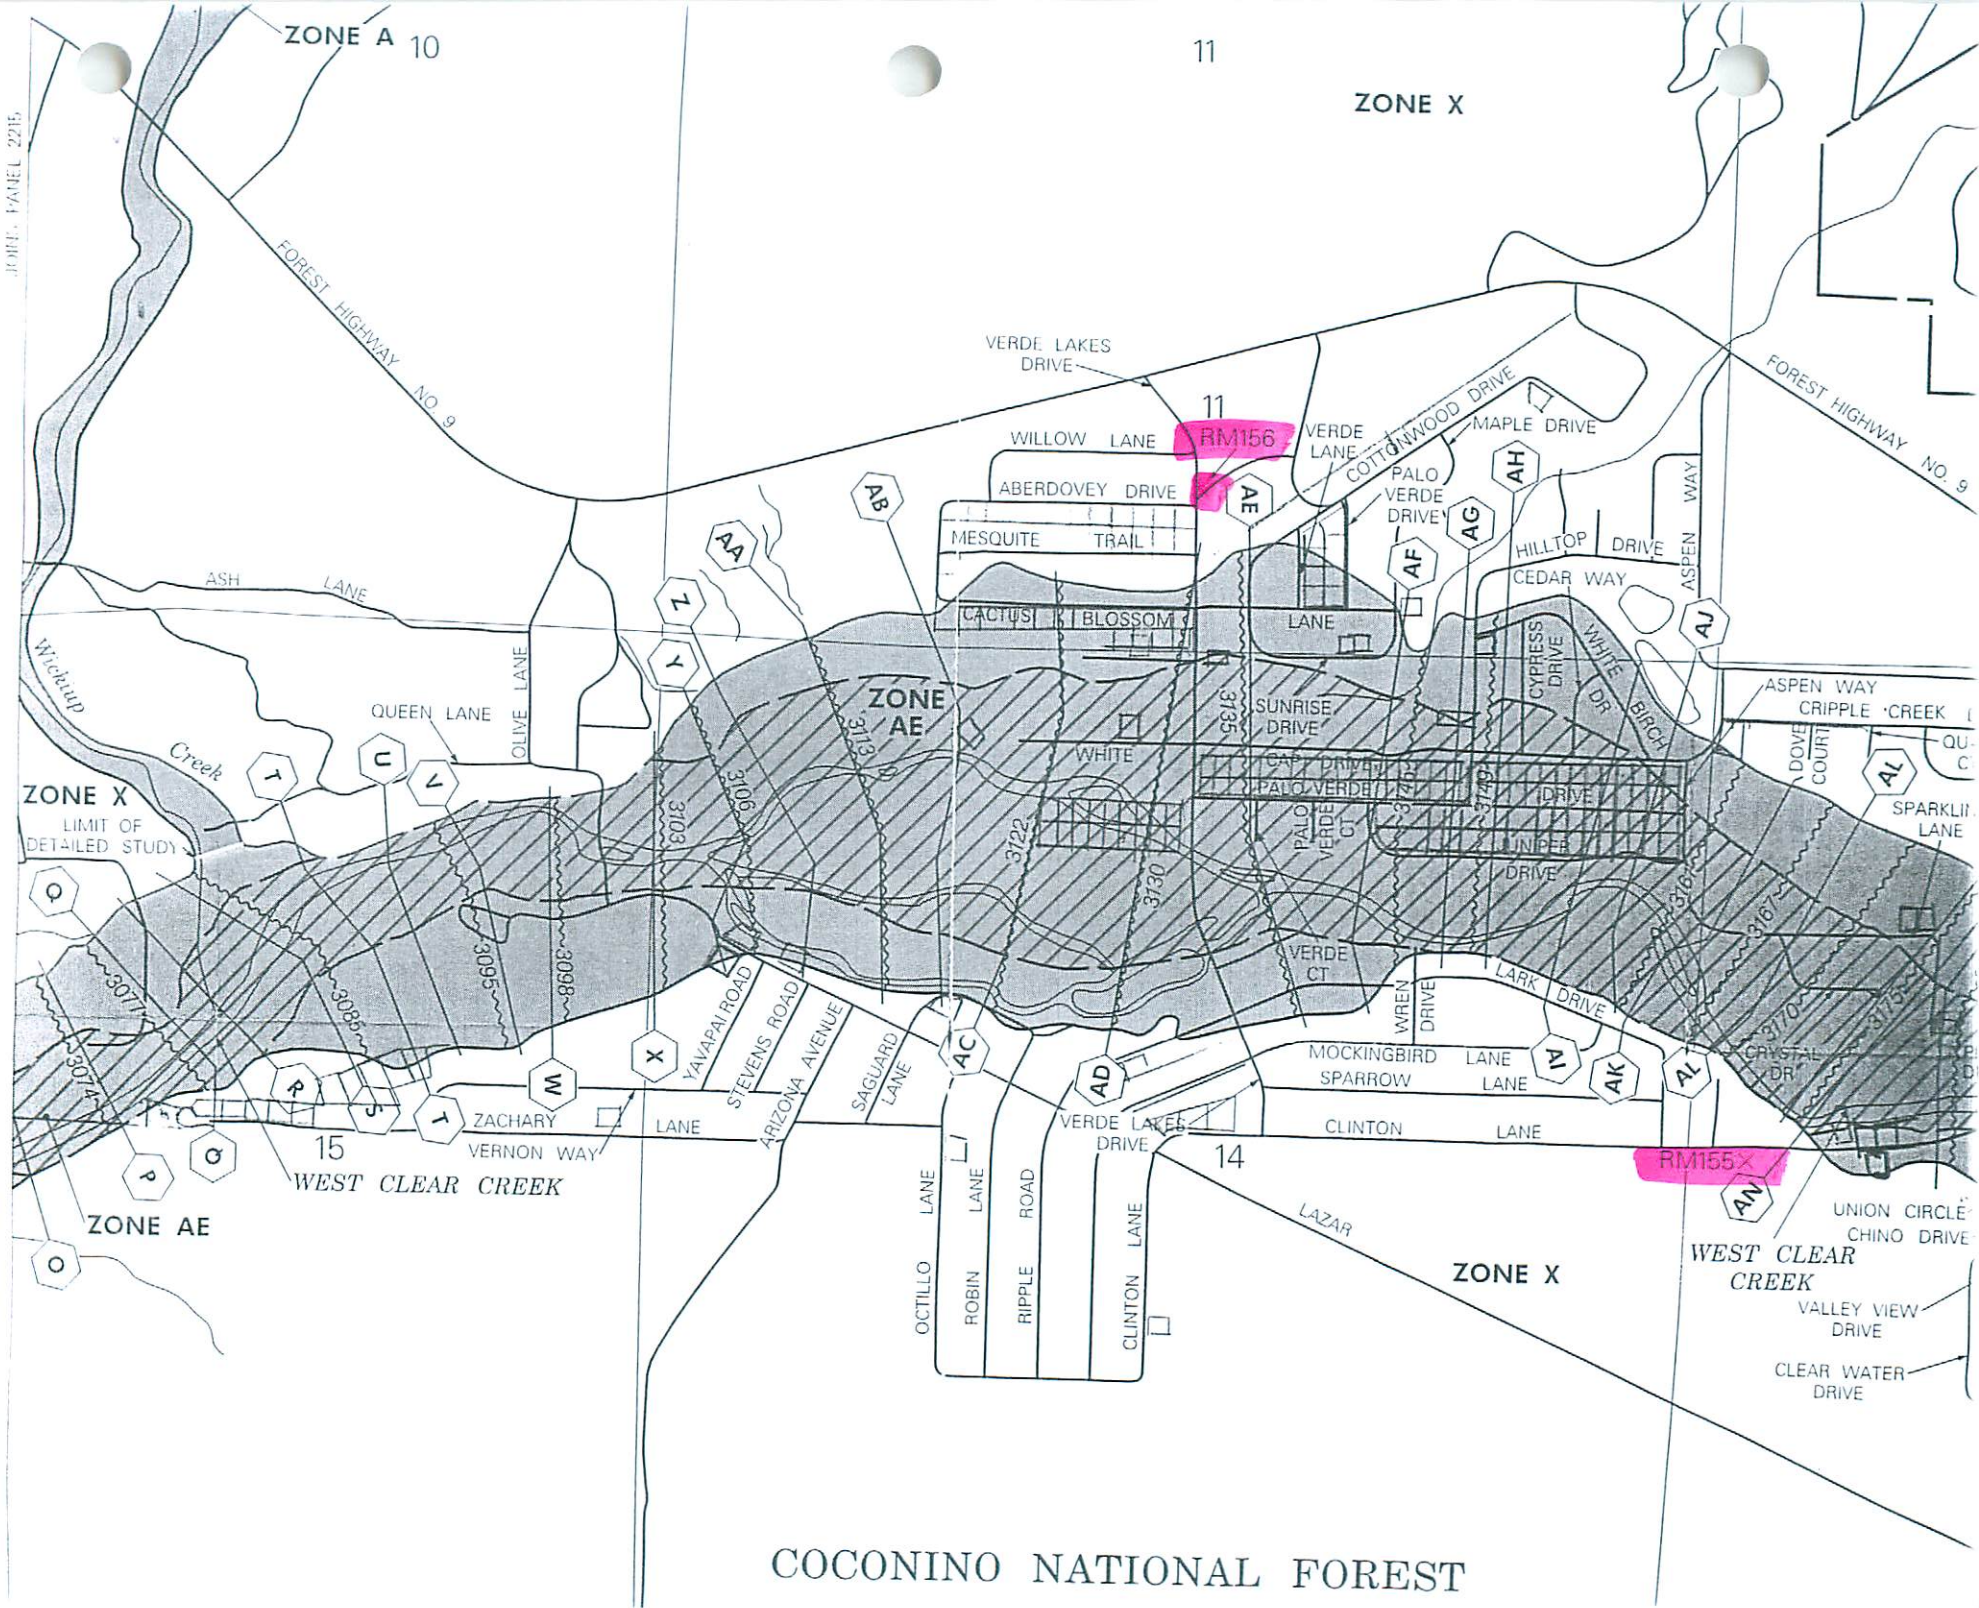

COCONINO NATIONAL FOREST