

ELEVATION REFERENCE MONUMENT

ERM: 136

Panel: 2415

Elevation (NAVD88): 3924.36

Elevation (NGVD29): 3921.66

Latitude: 34°24'54" N

Longitude: 112°43'03" W

Description: Aerial Mapping Company PK nail and brass washer on centerline road directly across from headwall with USGS BM 3921 (elevation 3920.70), approximately 1,800 feet east and 1,000 feet south of the northwest corner of Section 6, T12N, R4W.

2415

NATIONAL FLOOD INSURANCE PROGRAM

FIRM

FLOOD INSURANCE RATE MAP

**YAVAPAI COUNTY,
ARIZONA AND
INCORPORATED AREAS**

PANEL 2415 OF 3925

(SEE MAP INDEX FOR PANELS NOT PRINTED)

CONTAINS

COMMUNITY

NUMBER PANEL

SUFFIX

YAVAPAI COUNTY
UNINCORPORATED AREAS

04025 2415

**MAP NUMBER
04025C2415 F**

**EFFECTIVE DATE:
JUNE 6, 2001**



Federal Emergency Management Agency

A

B


112°45'00"
34°26'15"

ELEVATION REFERENCE MARKS


REFERENCE MARK	ELEVATION (FEET NGVD)	DESCRIPTION OF LOCATION
----------------	-----------------------	-------------------------

- | | | |
|-------|---------|---|
| RM136 | 3921.66 | Aerial Mapping Company PK nail and brass washer on centerline road directly across from headwall with USGS BM 3921 (elevation 3920.70), approximately 1,800 feet east and 1,000 feet south of the northwest corner of Section 6, T12N, R4W. |
| RM137 | 3961.68 | Arizona Highway Department brass cap stamped 3953.49 1957, set in top of curb 3 feet from west end of bridge, south side of bridge at road leading to Skull Valley. |

*See Rolling Hills
final plat*

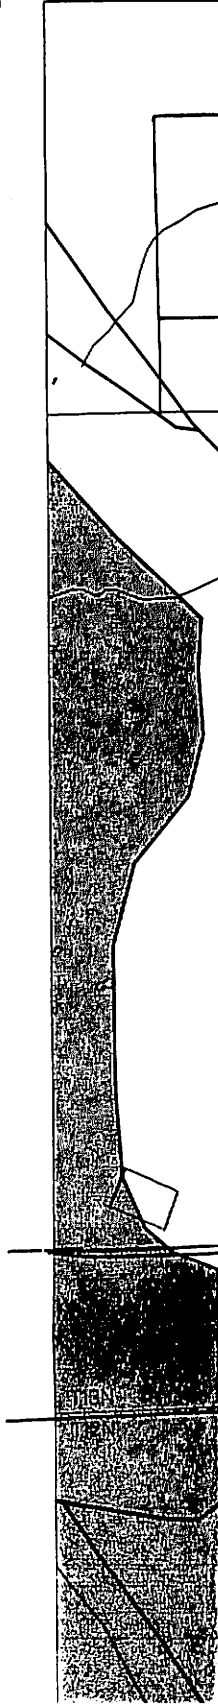

2

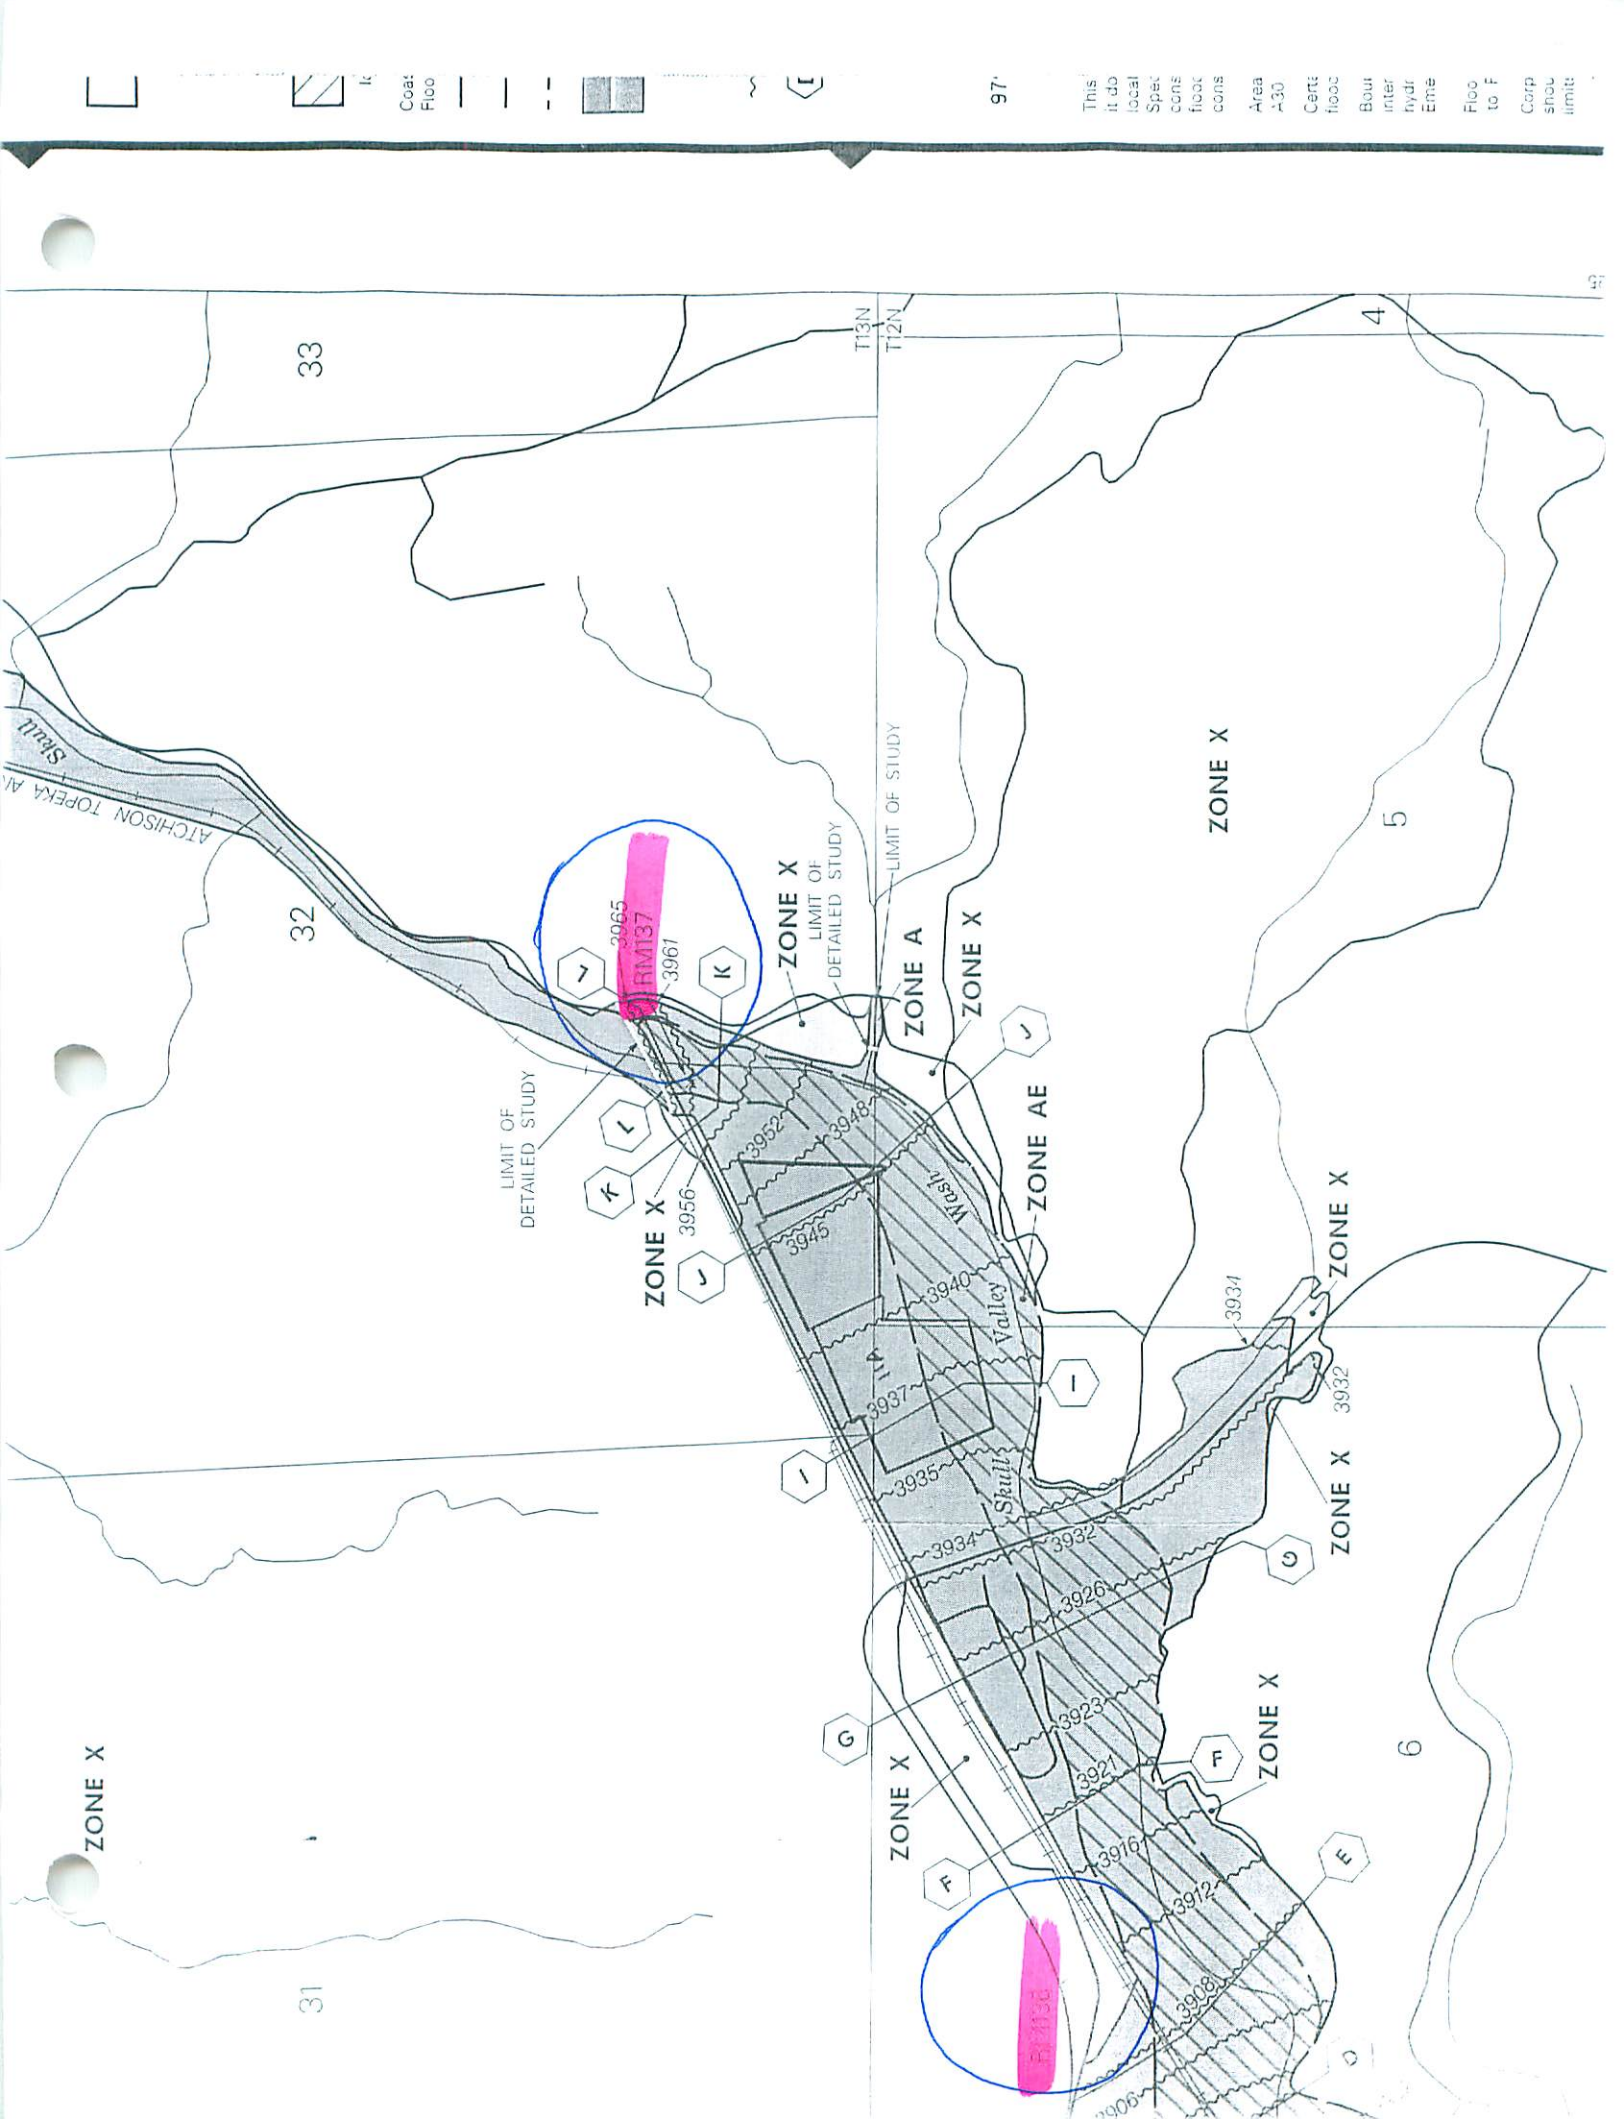

97'

This
it do
local
Spec
cone
floor
cons

Area
A30

Cert:
flood

Bour
inter
hydr
Eme

Floo
to F

Corp
shou
limit

33

32

31

4

5

6

ZONE X

ZONE X

ZONE X

ZONE X

ZONE A

ZONE X

ZONE AE

ZONE X

ZONE X

ZONE X

ZONE X

LIMIT OF
DETAILED STUDY

LIMIT OF
DETAILED STUDY

LIMIT OF STUDY

3965

3967

3956

3952

3948

3945

3940

3937

3935

3934

3932

3926

3923

3921

3916

3912

3908

3906

3934

3932

3935

3934

3932

3926

3923

3921

3916

3912

3908

3906

3965

3967

3956

3952

3948

3945

3940

3937

3935

3934

3932

3926

3923

3921

3916

3912

3908

3906

3934

3932

3935

3934

3932

3926

3923

3921

3916

3912

3908

3906