
## YAVAPAL COUNTY FLOOD CONTROL DISTRICT

## MONUMENT RECORD FORM


CORNER LOCATION INFORMATION	COUNTY FILING INFORMATION
SECTION29, CORNER INDEX CODE _R9 TOWNSHIP _16 North, RANGE 2 West	APPLY COUNTY STICKER HERE IF APPLICABLE FEE #  DOCKET PAGE
G&SRB&M MERIDIAN Yavapai COUNTY	COUNTY, ARIZONA
CORNER TYPE: N/A	DATE HOUR
D ALIQUOT GOV'T COR. D NON-ALIQUOT GOV'T COR. DOTHER	FEE: PAGES
FORMAL CORNER NAME:	REQUEST OF:
	TITLE:
NOTES FOR USING TOWNSHIP INDEX TO DETERMINE INDEX CODE	D SUBMITTED TO BE CHECKED FOR COMPLETENESS
FOR ALIQUOT SECTION, QUARTER, AND SIXTEENTH CORNERS, PUT A CIRCLE AT THE CORNER LOCATION, THEN READ GRID DESIGNATION (A-1 THRU Z-25). A CORNER THAT APPLIES TO TWO OR MORE TOWNSHIPS SHOULD BE INDEXED UNDER THE TOWNSHIP	TITLE: DATE:
NORTH OR WEST OF THE CORNER LOCATION AS INDICATED BY THE HEAVY LINE ON THE INDEX (GENERALLY THE SOUTH AND	TOWNSHIP INDEX SCALE: 1° = 10.000
CORNERS WILL BE INDEXED UNDER THE TOWNSHIP TO WHICH THEY	
APPLY. FOR 1/64 CORNERS AND FURTHER DIVISIONS, AND FOR NON-ALIQUOT CORNERS LYING BETWEEN GRID DESIGNATIONS	1 2 3 4 5 6 7 6 9 10 11 12 13 14 15 16 17 10 10 20 21 22 23 24 25
OR WITHIN A GRID SQUARE ON THE INDEX. DRAW AN APPROPRIATE	╺┞┼┼┼┼┼┼┼┼┼┼┼┼┼┼┼┼┼┼┼┼┼┼┼
REFERENCE LINE OR SHAPE ON THE INDEX. THEN CIRCLE THE CORNER LOCATION AND SPECIFY THE NEAREST INDEX CODE TO	
THE NORTH OR WEST (IF ON A GRID LINE), OR AT THE NORTHWEST CORNER OF THE GRID BLOCK.	
	······································
MONUMENT FIELD VISIT INFORMATION	• <del>••••••••••••••••••••••••••••••••••••</del>
DATE OF FIELD VISIT: 3 May 91	" + + + + + + + + + + + + + + + + + + +
MONUMENT: Set	*-++++++++++++++++++++++++++
□ LEFT AS FOUND □ FOUND & TAGGED □ FOUND & REBUILT	\ <del>\ \ \ \ \ \ \ \ \ \ \ \ \ \ \ \ \ \ \</del>
O RESTORED LOST CORNER   D ESTABLISHED NEW ACCESSORIES	
STATE PLANE COORDINATES: DESTABLISHED TO 3rd ORDER	0-+-+-
ZONE: D WEST XX CENTRAL DEAST D NOT ESTABLISHED	P - + 1 9 + -   -+ 20 + -   -+ 21 + -   -+ 22 + -   -+ 23 + -   -+ 24 + -
DATA: XX N.A.D.1927 (FEET) XX N.A.V.D.1929 (FEET) Y= 1363112.81 X= 329849.27 EL.= 4829.03	
□ N.A.D.1983 (METERS) □ N.A.V.D.1988 (METERS)	T-+30++29+
N= EI.= EL.=	<u>"                                    </u>
LATNORTH, LONGWEST GEOID HEIGHT 4705 SCALE FACTOR 0.999929	v-+++++++++++++++++++++++++++++
CONTROL STATIONS USED: Yavapai County	x +31++32+ +35+ +34+ +35+ +36+
Flood Control	
DESCRIBE RECORD EVIDENCE FOUND, INCLUDING TIES AND ACC MONUMENT NOT OF RECORD, TELL WHY YOU ACCEPTED IT AS VAL ACTIONS TAKEN BY YOU TO REHABILITATE OR PERPETUATE	THIS MONUMENT TE
DRIGINAL MONUMENT OR ITS LOCATION CAN BE FOUND DESCRIP	EVIDENCE OF THE
JSED. INCLUDING ALL RECORD OF SURVEY REFERENCES ARECOME	NTROLLING CORNERS
MENT SET (INCLUDING ACCESSORY MONUMENTS) AS TO MATERIAL PROJECTION OF BURIAL. AND DISPOSITION OF OLD MONUMEN	CUADE MADIETHO
IAGO AND ACCESSURIES IN CONGRITAATION VITH THE EVETCH	ON THE DEVENOR
DESCRIBE ANY CONFLICTING MONUMENTS OR EVIDENCE AND Y	OUR CONCLUSIONS. #5
	π 5
	L.S. 19824
A Marketin Commencer of the Commencer of	
	CONTROL DISTRICT
3.3	
FILED RECORD OF SURVEY IN COUNTY RECORDS AT	POOK DARKE
TTACHED SHEETS: DIVELTEN TESTIMONY DETELD NOTE BAGE	(C) PAGE(S)

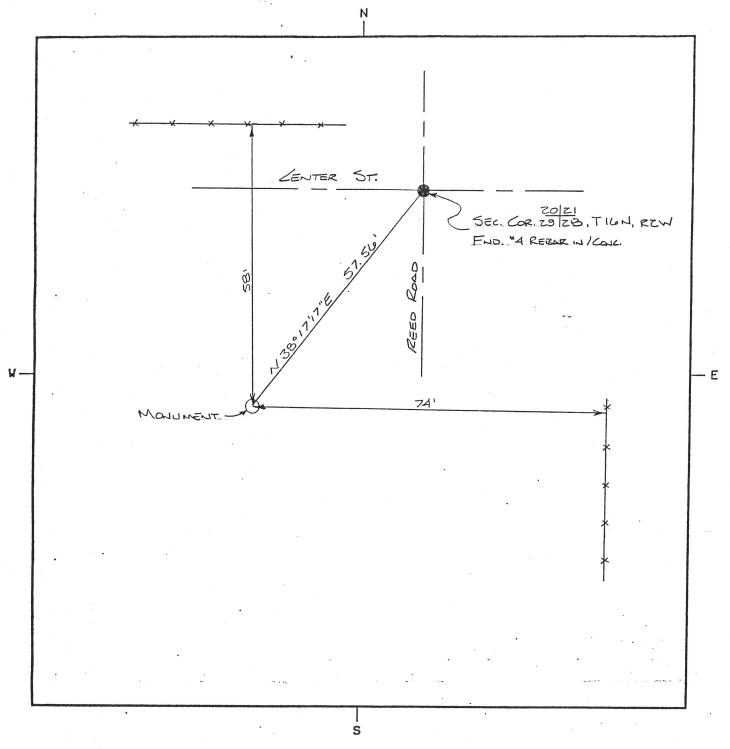

## LAND SURVEYOR IDENTIFICATION AND CERTIFICATION

i David M. Graham	ARIZONA R.I.S.
NUMBER 19824 HEREBY CERTIFY THAT	THIS CORNER RECORD
JAS PREPARED UNDER MY DIRECTION, THAT A	I MONIMENTATION
ACTUALLY EXISTS AS SHOWN HEREON.	
AS SHOWN HEREDN.	

COMPANY NAME	Survnet, Inc.
MAILING ADDRESS	
	05004
	(602) 835-9070

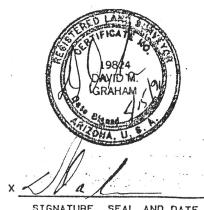

SIGNATURE, SEAL AND DATE