

ELEVATION CERTIFICATE

OMB No. 1660-0008
Expires February 28, 2009

Important: Read the instructions on pages 1-8.

SECTION A - PROPERTY INFORMATION

A1. Building Owner's Name: Tanner Pritchard
 A2. Building Street Address (including Apt., Unit, Suite, and/or Bldg. No.) or P.O. Route and Box No.: 7585 E. Phalaris Lane
 City: Prescott Valley State: AZ ZIP Code: 86332
 A3. Property Description (Lot and Block Numbers, Tax Parcel Number, Legal Description, etc.): 103-01-222K
 A4. Building Use (e.g., Residential, Non-Residential, Addition, Accessory, etc.): Residential
 A5. Latitude/Longitude: Lat. _____ Long. _____ Horizontal Datum: NAD 1927 NAD 1983
 A6. Attach at least 2 photographs of the building if the Certificate is being used to obtain flood insurance.
 A7. Building Diagram Number: 8
 A8. For a building with a crawl space or enclosure(s), provide:
 a) Square footage of crawl space or enclosure(s): 1236.70 sq ft
 b) No. of permanent flood openings in the crawl space or enclosure(s) walls within 1.0 foot above adjacent grade: 1301.25 X 67
 c) Total net area of flood openings in A8.b: 2431.80 sq in
 A9. For a building with an attached garage, provide:
 a) Square footage of attached garage: 405.30 sq ft
 b) No. of permanent flood openings in the attached garage walls within 1.0 foot above adjacent grade: 0
 c) Total net area of flood openings in A9.b: 0 sq in
Garage Door 20,541.60

SECTION B - FLOOD INSURANCE RATE MAP (FIRM) INFORMATION

B1. NFIP Community Name & Community Number: Yavapai County 040093
 B2. County Name: Yavapai B3. State: AZ
 B4. Map/Panel Number: 04025C 1750 B5. Suffix: F
 B6. FIRM Index Date: June 6, 2002 B7. FIRM Panel Effective/Revised Date: June 6, 2001
 B8. Flood Zone(s): A B9. Base Flood Elevation(s) (Zone AO, use base flood depth): 95.6
 B10. Indicate the source of the Base Flood Elevation (BFE) data or base flood depth entered in Item B9.
 FIS Profile FIRM Community Determined Other (Describe) assumed 95.6' BFE
 B11. Indicate elevation datum used for BFE in Item B9: NGVD 1929 NAVD 1988 Other (Describe) Assumed per Ramsey Survey
 B12. Is the building located in a Coastal Barrier Resources System (CBRS) area or Otherwise Protected Area (OPA)?
 CBRS OPA Yes No

SECTION C - BUILDING ELEVATION INFORMATION (SURVEY REQUIRED)


C1. Building elevations are based on: Construction Drawings* Building Under Construction* Finished Construction
 *A new Elevation Certificate will be required when construction of the building is complete.
 C2. Elevations - Zones A1-A30, AE, AH, A (with BFE), VE, V1-V30, V (with BFE), AR, AR/A, AR/AE, AR/A1-A30, AR/AH, AR/AO. Complete Items C2.a-g below according to the building diagram specified in Item A7. 423383 cap
 Benchmark Utilized: 1/2 rebar @ SW property corner Vertical Datum: 94.78
 Conversion/Comments: _____
 Check the measurement used.
 a) Top of bottom floor (including basement, crawl space, or enclosure floor): 93.77 feet meters (Puerto Rico only)
 b) Top of the next higher floor: 94.78 feet meters (Puerto Rico only)
 c) Bottom of the lowest horizontal structural member (V Zones only): NA feet meters (Puerto Rico only)
 d) Attached garage (top of slab): 94.70 feet meters (Puerto Rico only)
 e) Lowest elevation of machinery or equipment servicing the building (Describe type of equipment in Comments): 94.49 feet meters (Puerto Rico only)
 f) Lowest adjacent (finished) grade (LAG): 93.34 feet meters (Puerto Rico only)
 g) Highest adjacent (finished) grade (HAG): 94.32 feet meters (Puerto Rico only)

SECTION D - SURVEYOR, ENGINEER, OR ARCHITECT CERTIFICATION

This certification is to be signed and sealed by a land surveyor, engineer, or architect authorized by law to certify elevation information. I certify that the information on this Certificate represents my best efforts to interpret the data available. I understand that any false statement may be punishable by fine or imprisonment under 18 U.S. Code, Section 1001.

Check here if comments are provided on back of form.

Certifier's Name: Dugan L. McDonald License Number: RLS 26925 Inc.
 Title: President Company Name: Heritage Land Survey + Mapping
 Address: P.O. Box 3270 City: Camp Verde State: AZ ZIP Code: 86322
 Signature: [Signature] Date: 4-19-06 Telephone: 928-567-9170

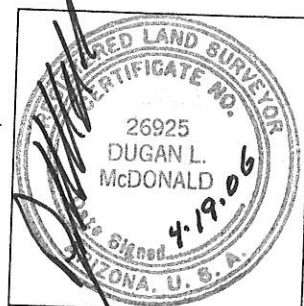

IMPORTANT: In these spaces, copy the corresponding information from Section A.			For Insurance Company Use:	
Building Street Address (including Apt., Unit, Suite, and/or Bldg. No.) or P.O. Route and Box No. 1585 E. Pharrap Lane			Policy Number	
City Prescott Valley	State AZ	ZIP Code 86312	Company NAIC Number	

SECTION D - SURVEYOR, ENGINEER, OR ARCHITECT CERTIFICATION (CONTINUED)

Copy both sides of this Elevation Certificate for (1) community official, (2) insurance agent/company, and (3) building owner.

Comments

Signature _____ Date _____

Check here if attachments

SECTION E - BUILDING ELEVATION INFORMATION (SURVEY NOT REQUIRED) FOR ZONE AO AND ZONE A (WITHOUT BFE)

For Zones AO and A (without BFE), complete Items E1-E5. If the Certificate is intended to support a LOMA or LOMR-F request, complete Sections A, B, and C. For Items E1-E4, use natural grade, if available. Check the measurement used. In Puerto Rico only, enter meters.

E1. Provide elevation information for the following and check the appropriate boxes to show whether the elevation is above or below the highest adjacent grade (HAG) and the lowest adjacent grade (LAG).

a) Top of bottom floor (including basement, crawl space, or enclosure) is _____ feet meters above or below the HAG.

b) Top of bottom floor (including basement, crawl space, or enclosure) is _____ feet meters above or below the LAG.

E2. For Building Diagrams 6-8 with permanent flood openings provided in Section A Items 8 and/or 9 (see page 8 of Instructions), the next higher floor (elevation C2.b in the diagrams) of the building is _____ feet meters above or below the HAG.

E3. Attached garage (top of slab) is _____ feet meters above or below the HAG.

E4. Top of platform of machinery and/or equipment servicing the building is _____ feet meters above or below the HAG.

E5. Zone AO only: If no flood depth number is available, is the top of the bottom floor elevated in accordance with the community's floodplain management ordinance? Yes No Unknown. The local official must certify this information in Section G.

SECTION F - PROPERTY OWNER (OR OWNER'S REPRESENTATIVE) CERTIFICATION

The property owner or owner's authorized representative who completes Sections A, B, and E for Zone A (without a FEMA-issued or community-issued BFE) or Zone AO must sign here. *The statements in Sections A, B, and E are correct to the best of my knowledge.*

Property Owner's or Owner's Authorized Representative's Name _____

Address _____	City _____	State _____	ZIP Code _____
Signature _____	Date _____	Telephone _____	

Comments

Check here if attachments

SECTION G - COMMUNITY INFORMATION (OPTIONAL)

The local official who is authorized by law or ordinance to administer the community's floodplain management ordinance can complete Sections A, B, C (or E), and G of this Elevation Certificate. Complete the applicable item(s) and sign below. Check the measurement used in Items G8, and G9.

G1. The information in Section C was taken from other documentation that has been signed and sealed by a licensed surveyor, engineer, or architect who is authorized by law to certify elevation information. (Indicate the source and date of the elevation data in the Comments area below.)

G2. A community official completed Section E for a building located in Zone A (without a FEMA-issued or community-issued BFE) or Zone AO.

G3. The following information (Items G4.-G9.) is provided for community floodplain management purposes.

G4. Permit Number _____	G5. Date Permit Issued _____	G6. Date Certificate Of Compliance/Occupancy Issued _____
-------------------------	------------------------------	---

G7. This permit has been issued for: New Construction Substantial Improvement

G8. Elevation of as-built lowest floor (including basement) of the building: _____ feet meters (PR) Datum _____

G9. BFE or (in Zone AO) depth of flooding at the building site: _____ feet meters (PR) Datum _____

Local Official's Name _____	Title _____
Community Name _____	Telephone _____
Signature _____	Date _____

Comments

Check here if attachments

TOPOGRAPHIC SURVEY


103-01-218Q

LOT 9A-5

"ANTELOPE MEADOWS AMENDED"
SECTION 11,
TOWNSHIP 15 NORTH, RANGE 1 EAST,
GILA & SALT RIVER BASE & MERIDIAN,
YAVAPAI COUNTY, ARIZONA

LEGEND:


- INDICATES EXISTING ROADWAY
- INDICATED 1/2" BENCH MARK WITH 10' ELEVATION
GAP VALUES OTHERWISE NOTED
- INDICATED 1/2" BENCH MARK WITH 10' ELEVATION
- ▲ INDICATED 3/8" BENCH MARK WITH 10' ELEVATION
- △ INDICATED 3/8" BENCH MARK WITH 10' ELEVATION
- INDICATED CALCULATED SHOWN
- M INDICATED 1/4" BENCH MARK WITH 10' ELEVATION
- (R) INDICATES EXISTING BOUNDARY FROM AN EARLIER SURVEY OF "ANTELOPE MEADOWS AMENDED" SHOWN BY BOOK 44, PAGE 48, IN THE RECORDS OF YAVAPAI COUNTY, ARIZONA
- X INDICATED SPOT ELEVATION

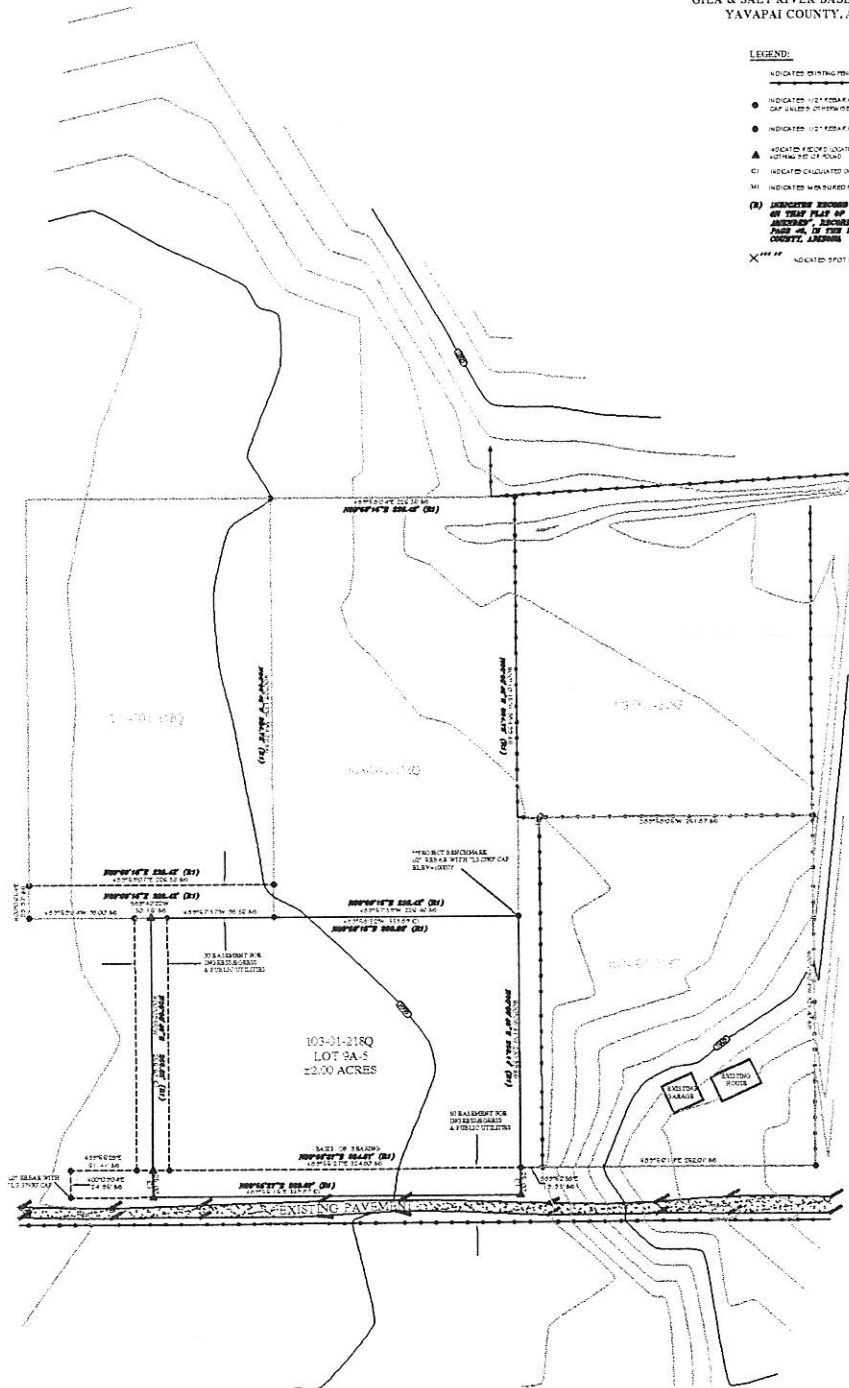

AS SHOWN HEREON
THIS SURVEY IS THE PROPERTY OF
HERITAGE LAND SURVEYING & MAPPING INC.
AND IS NOT TO BE REPRODUCED OR
TRANSMITTED IN ANY FORM OR BY ANY
MEANS, ELECTRONIC OR MECHANICAL,
INCLUDING PHOTOCOPYING, RECORDING,
OR BY ANY INFORMATION STORAGE AND
RETRIEVAL SYSTEM.
CONTOUR INTERVAL = 10'

THIS MAP IS FOR THE PURPOSE OF ALL
CONVEYANCES AND IS NOT TO BE USED
FOR ANY OTHER PURPOSE. THE USER
ACCEPTS ALL LIABILITY FOR ANY
CONVEYANCE MADE IN RELIANCE ON
THIS SURVEY AND THE SURVEYOR'S
CERTIFICATE OF PRACTICE.

GRAPHIC SCALE

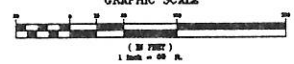

JOB #06-04117

HERITAGE

LAND SURVEYING & MAPPING INC.
DORIS L. HANWELL R.L.S.
PO BOX 2170
CAMP TERRY, AZ 86022
928-287-8170

103-01-218Q