

# ELEVATION CERTIFICATE

Important: Read the instructions on pages 1 - 7.

## SECTION A - PROPERTY OWNER INFORMATION

BUILDING OWNER'S NAME <b>WILLIAM WINTERS</b>		For Insurance Company Use:	
BUILDING STREET ADDRESS (Including Apt., Unit, Suite, and/or Bldg. No.) OR P.O. ROUTE AND BOX NO. <b>9 WREN DR</b>		Policy Number	
CITY <b>PRESCOTT</b>	STATE <b>AZ</b>	Company NAIC Number	
PROPERTY DESCRIPTION (Lot and Block Numbers, Tax Parcel Number, Legal Description, etc.) <b>APN 106-13-036</b>		ZIP CODE <b>86303</b>	
BUILDING USE (e.g., Residential, Non-residential, Addition, Accessory, etc. Use Comments section if necessary.) <b>RESIDENTIAL</b>			
LATITUDE/LONGITUDE (OPTIONAL) (##°-##'-##"##" or ##.#####)		HORIZONTAL DATUM: SOURCE: <input type="checkbox"/> GPS (Type): <input checked="" type="checkbox"/> NAD 1927 <input type="checkbox"/> NAD 1983 <input type="checkbox"/> USGS Quad Map <input type="checkbox"/> Other:	

## SECTION B - FLOOD INSURANCE RATE MAP (FIRM) INFORMATION

B1. NFIP COMMUNITY NAME & COMMUNITY NUMBER <b>YAVAPAI COUNTY 040093</b>		B2. COUNTY NAME <b>YAVAPAI</b>		B3. STATE <b>AZ</b>	
B4. MAP AND PANEL NUMBER <b>040093 1040</b>	B5. SUFFIX <b>B</b>	B6. FIRM INDEX DATE <b>3-9-99</b>	B7. FIRM PANEL EFFECTIVE/REVISED DATE <b>8-19-85</b>	B8. FLOOD ZONE(S) <b>C</b>	B9. BASE FLOOD ELEVATION(S) (Zone AO, use depth of flooding) <b>5145.5</b>

B10. Indicate the source of the Base Flood Elevation (BFE) data or base flood depth entered in B9.  
 FIS Profile  FIRM  Community Determined  Other (Describe): **DATUM ELEVATION**

B11. Indicate the elevation datum used for the BFE in B9:  NGVD 1929  NAVD 1988  Other (Describe):

B12. Is the building located in a Coastal Barrier Resources System (CBRS) area or Otherwise Protected Area (OPA)?  Yes  No  
Designation Date:

## SECTION C - BUILDING ELEVATION INFORMATION (SURVEY REQUIRED)

C1. Building elevations are based on:  Construction Drawings\*  Building Under Construction\*  Finished Construction  
\*A new Elevation Certificate will be required when construction of the building is complete.

C2. Building Diagram Number **8** (Select the building diagram most similar to the building for which this certificate is being completed - see pages 6 and 7. If no diagram accurately represents the building, provide a sketch or photograph.)


C3. Elevations - Zones A1-A30, AE, AH, A (with BFE), VE, V1-V30, V (with BFE), AR, AR/A, AR/AE, AR/A1-A30, AR/AH, AR/AO  
Complete Items C3a-i below according to the building diagram specified in Item C2. State the datum used. If the datum is different from the datum used for the BFE in Section B, convert the datum to that used for the BFE. Show field measurements and datum conversion calculation. Use the space provided or the Comments area of Section D or Section G, as appropriate, to document the datum conversion.

Datum \_\_\_\_\_ Conversion/Comments \_\_\_\_\_

Elevation reference mark used \_\_\_\_\_ Does the elevation reference mark used appear on the FIRM?  Yes  No

- a) Top of bottom floor (including basement or enclosure) **5249** **64** ft.(m)
- b) Top of next higher floor \_\_\_\_\_ ft.(m)
- c) Bottom of lowest horizontal structural member (V zones only) \_\_\_\_\_ ft.(m)
- d) Attached garage (top of slab) \_\_\_\_\_ ft.(m)
- e) Lowest elevation of machinery and/or equipment servicing the building \_\_\_\_\_ ft.(m)
- f) Lowest adjacent grade (LAG) \_\_\_\_\_ ft.(m)
- g) Highest adjacent grade (HAG) \_\_\_\_\_ ft.(m)
- h) No. of permanent openings (flood vents) within 1 ft. above adjacent grade \_\_\_\_\_
- i) Total area of all permanent openings (flood vents) in C3h \_\_\_\_\_ sq. in. (sq. cm)

License Number, Embossed Seal, Signature, and Date

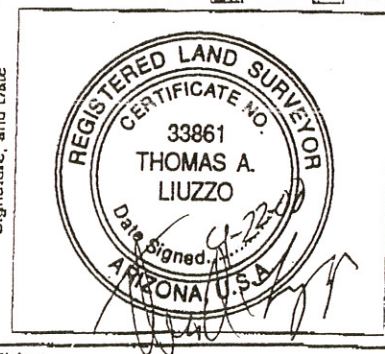

## SECTION D - SURVEYOR, ENGINEER, OR ARCHITECT CERTIFICATION

This certification is to be signed and sealed by a land surveyor, engineer, or architect authorized by law to certify elevation information.  
I certify that the information in Sections A, B, and C on this certificate represents my best efforts to interpret the data available.  
I understand that any false statement may be punishable by fine or imprisonment under 18 U.S. Code, Section 1001.

CERTIFIER'S NAME: **Thomas A. Liuzzo** LICENSE NUMBER: **# 33861**

TITLE: **Survey Manager** COMPANY NAME: **Surprise Engineering**

ADDRESS: **8183 E. Florentine Rd** CITY: **Prescott Valley** STATE: **AZ** ZIP CODE: **86314**

SIGNATURE: **Thomas A. Liuzzo** DATE: **9-28-00** TELEPHONE: **520-772-2974**

**IMPORTANT:** In these spaces, copy the corresponding information from Section A.

BUILDING STREET ADDRESS (Including Apt., Unit, Suite, and/or Bldg. No.) OR P.O. ROUTE AND BOX NO.  
9 WREN DRIVE

CITY PRESCOTT STATE AZ ZIP CODE 86303

For Insurance Company Use:	
Policy Number:	
Company NAIC Number:	

**SECTION D - SURVEYOR, ENGINEER, OR ARCHITECT CERTIFICATION (CONTINUED)**

Copy both sides of this Elevation Certificate for (1) community official, (2) insurance agent/company, and (3) building owner.

COMMENTS CONSTRUCTION IS COMPLETE

Check here if attachments

**SECTION E - BUILDING ELEVATION INFORMATION (SURVEY NOT REQUIRED) FOR ZONE AO AND ZONE A (WITHOUT BFE)**

For Zone AO and Zone A (without BFE), complete Items E1 through E4. If the Elevation Certificate is intended for use as supporting information for a LOMA or LOMR-F, Section C must be completed.

- E1. Building Diagram Number \_\_\_\_\_ (Select the building diagram most similar to the building for which this certificate is being completed - see pages 6 and 7. If no diagram accurately represents the building, provide a sketch or photograph.)
- E2. The top of the bottom floor (including basement or enclosure) of the building is \_\_\_\_\_ ft.(m) \_\_\_\_\_ in.(cm)  above or  below (check one) the highest adjacent grade.
- E3. For Building Diagrams 6-8 with openings (see page 7), the next higher floor or elevated floor (elevation b) of the building is \_\_\_\_\_ ft.(m) \_\_\_\_\_ in.(cm) above the highest adjacent grade.
- E4. For Zone AO only: If no flood depth number is available, is the top of the bottom floor elevated in accordance with the community's floodplain management ordinance?  Yes  No  Unknown. The local official must certify this information in Section G.

**SECTION F - PROPERTY OWNER (OR OWNER'S REPRESENTATIVE) CERTIFICATION**

The property owner or owner's authorized representative who completes Sections A, B, and E for Zone A (without a FEMA-issued or community-issued BFE) or Zone AO must sign here.

PROPERTY OWNER'S OR OWNER'S AUTHORIZED REPRESENTATIVE'S NAME \_\_\_\_\_

ADDRESS _____	CITY _____	STATE _____	ZIP CODE _____
SIGNATURE _____	DATE _____	TELEPHONE _____	

COMMENTS \_\_\_\_\_

Check here if attachments

**SECTION G - COMMUNITY INFORMATION (OPTIONAL)**

The local official who is authorized by law or ordinance to administer the community's floodplain management ordinance can complete Sections A, B, C (or E), and G of this Elevation Certificate. Complete the applicable item(s) and sign below.

- G1.  The information in Section C was taken from other documentation that has been signed and embossed by a licensed surveyor, engineer, or architect who is authorized by state or local law to certify elevation information. (Indicate the source and date of the elevation data in the Comments area below.)
- G2.  A community official completed Section E for a building located in Zone A (without a FEMA-issued or community-issued BFE) or Zone AO.
- G3.  The following information (Items G4-G9) is provided for community floodplain management purposes.

G4. PERMIT NUMBER _____	G5. DATE PERMIT ISSUED _____	G6. DATE CERTIFICATE OF COMPLIANCE/OCCUPANCY ISSUED _____
-------------------------	------------------------------	---

G7. This permit has been issued for:  New Construction  Substantial Improvement

G8. Elevation of as-built lowest floor (including basement) of the building is: \_\_\_\_\_ ft.(m) Datum: \_\_\_\_\_

G9. BFE or (in Zone AO) depth of flooding at the building site is: \_\_\_\_\_ ft.(m) Datum: \_\_\_\_\_

LOCAL OFFICIAL'S NAME _____	TITLE _____
COMMUNITY NAME _____	TELEPHONE _____
SIGNATURE _____	DATE _____

COMMENTS \_\_\_\_\_

Check here if attachments

### ELEVATION OF FLOODPLAIN PROPERTY

When Completed Return To: Yavapai County Flood Control District, 500 S. Marina St., Prescott, AZ, 86303  
(520) 771-3197 FAX 771-3427

DATE 15 JUNE 2000

ASSESSOR'S PARCEL NUMBER 106-13-036 1040

SUBDIVISION NAME UNIT/PHASE AND LOT NUMBER \_\_\_\_\_

OWNER BILL & LIN WINTERS

SITUS ADDRESS 9 WREN DRIVE

BASE BENCHMARK: Number SPILLWAY OF WILLOW LAKE DAM Elevation 5140.45'


PROPERTY BENCHMARK 5144.52

DESCRIPTION OF PROPERTY BENCHMARK SET 5/8" REBAR WITH RED PLASTIC CAP  
SUNRISE CONTROL

GROUND ELEVATIONS AT BUILDING SITE 5144.18  
(Please provide a minimum of three (3) elevations points, representative of the site)

Sketch of Lot  
(include location of property benchmark and building site elevations)

Remarks SET 5/8" REBAR WITH RED PLASTIC CAP SUNRISE CONTROL @ BUILDING SITE LOCATION.

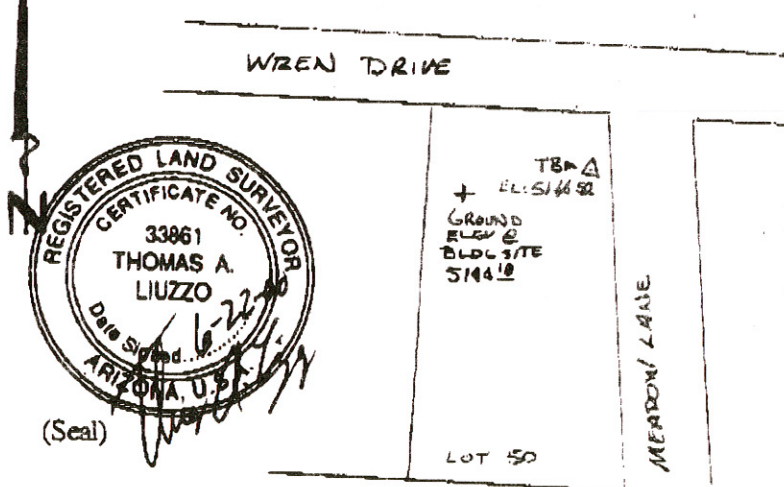

Signed Thomas A. Liuzzo  
 Company Name Sunrise Engineering, Inc.  
 Address 8193 East Floravine Road  
Prescott Valley, AZ. 86314  
 Telephone 520-772-2924

FOR YAVAPAI COUNTY FLOOD CONTROL DISTRICT USE: Date: 6-30-2000  
DAY SPILLWAY = 5145.5

Base Flood Elevation + 1.0' = Regulatory Elevation 5145.5

\* ELEVATION DETERMINATIONS ARE BASED ON BEST AVAILABLE DATA WHEN CALCULATED. ELEVATIONS ARE SUBJECT TO CHANGE WHEN NEW OR REVISED FLOOD STUDIES, OR DATA IS SUPPLIED TO THE DISTRICT.

CLARK/S