

ELEVATION CERTIFICATE

Important: Read the instructions on pages 1 - 5.

SECTION A - PROPERTY OWNER INFORMATION		For Insurance Company Use:
BUILDING OWNER'S NAME	11638 S. Half Moon Dr. William Goodloe Phoenix, AZ 85044	Policy Number
BUILDING STREET ADDRESS (Including Apt., Unit, Suite, and/or Bldg. No.) OR P.O. ROUTE AND BOX NO.	18431 Henley Pkwy Lane (formerly Little Hodge Lane)	Company NAIC Number
CITY	Peeples Valley	STATE
	AZ	ZIP CODE
		86322
PROPERTY DESCRIPTION (Lot and Block Numbers, Tax Parcel Number, Legal Description, etc.)	Lot 16, Peeples Valley, B. 14, P. 87, Y.C.R.O. 202-07-064A	
BUILDING USE (e.g., Residential, Non-residential, Addition, Accessory, etc. Use comments section if necessary.)	Residential	
LATITUDE/LONGITUDE (OPTIONAL) (##° - ##' - ###.###" or ##.#####°)	HORIZONTAL DATUM: <input type="checkbox"/> NAD 1927 <input type="checkbox"/> NAD 1983	SOURCE: <input type="checkbox"/> GPS (Type: _____) <input type="checkbox"/> USGS Quad Map <input type="checkbox"/> Other: _____

SECTION B - FLOOD INSURANCE RATE MAP (FIRM) INFORMATION

B1. NFIP COMMUNITY NAME & COMMUNITY NUMBER	B2. COUNTY NAME	B3. STATE			
040093 YAVAPAI COUNTY	YAVAPAI	AZ			
B4. MAP AND PANEL NUMBER	B5. SUFFIX	B6. FIRM INDEX DATE	B7. FIRM PANEL EFFECTIVE/REVISED DATE	B8. FLOOD ZONE(S)	B9. BASE FLOOD ELEVATION(S) (Zone AO, use depth of flooding)
040093 1440	C	03-09-99	5-18-92	A	4224.6

B10. Indicate the source of the Base Flood Elevation (BFE) data or base flood depth entered in B9.
 FIS Profile FIRM Community Determined Other (Describe: _____)

B11. Indicate the elevation datum used for the BFE in B9: NGVD 1929 NAVD 1988 Other (Describe: _____)

B12. Is the building located in a Coastal Barrier Resources System (CBRS) area or Otherwise Protected Area (OPA)? Yes No
 Designation Date: _____


SECTION C - BUILDING ELEVATION INFORMATION (SURVEY REQUIRED)

C1. Building elevations are based on: Construction Drawings* Building Under Construction* Finished Construction
 *A new Elevation Certificate will be required when construction of the building is complete.

C2. Building Diagram Number 6 (Select the building diagram most similar to the building for which this certificate is being completed - see pages 4 and 5. If no diagram accurately represents the building, provide a sketch or photograph.)

C3. Elevations - Zones A1-A30, AE, AH, A (with BFE), VE, V1-V30, V (with BFE), AR, AR/A, AR/AE, AR/A1-A30, AR/AH, AR/AO
 Complete Items C3a-i below according to the building diagram specified in Item C2. State the datum used. If the datum is different from the datum used for the BFE in Section B, convert the datum to that used for the BFE. Show field measurements and datum conversion calculation. Use the space provided or the Comments area of Section D or Section G, as appropriate, to document the datum conversion.
 Datum RM 201 Conversion/Comments _____
 Elevation reference mark used 4511.52 Does the elevation reference mark used appear on the FIRM? Yes No

<input checked="" type="checkbox"/> a) Top of bottom floor (including basement or enclosure)	_____	_____	ft.(m)
<input type="checkbox"/> b) Top of next higher floor	_____	_____	ft.(m)
<input checked="" type="checkbox"/> c) Bottom of lowest horizontal structural member (V zones only)	_____	_____	ft.(m)
<input type="checkbox"/> d) Attached garage (top of slab)	_____	_____	ft.(m)
<input type="checkbox"/> e) Lowest elevation of machinery and/or equipment servicing the building	_____	_____	ft.(m)
<input checked="" type="checkbox"/> f) Lowest adjacent grade (LAG)	_____	_____	ft.(m)
<input checked="" type="checkbox"/> g) Highest adjacent grade (HAG)	_____	_____	ft.(m)
<input type="checkbox"/> h) No. of permanent openings (flood vents) within 1 ft. above adjacent grade	_____	_____	
<input type="checkbox"/> i) Total area of all permanent openings (flood vents) in C3h	_____	_____	sq. in. (sq. cm)

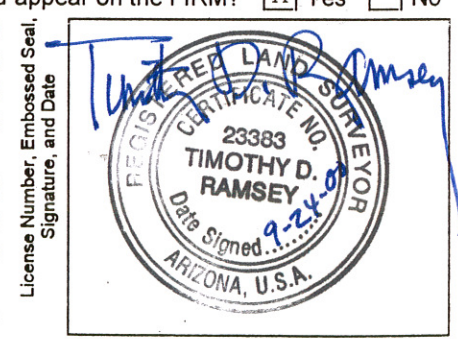

SECTION D - SURVEYOR, ENGINEER, OR ARCHITECT CERTIFICATION

This certification is to be signed and sealed by a land surveyor, engineer, or architect authorized by law to certify elevation information.
 I certify that the information in Sections A, B, and C on this certificate represents my best efforts to interpret the data available.
 I understand that any false statement may be punishable by fine or imprisonment under 18 U.S. Code, Section 1001.

CERTIFIER'S NAME	Timothy D. Ramsey	LICENSE NUMBER	23383
TITLE	President	COMPANY NAME	Ramsey Surveying, Inc.
ADDRESS	2255 West Kris Court	CITY	Prescott
		STATE	AZ
		ZIP CODE	86305
SIGNATURE	<i>Timothy D. Ramsey</i>	DATE	09/24/00
		TELEPHONE	(520) 778-5043

IMPORTANT: In these spaces, copy the corresponding information from Section A.			For Insurance Company Use:
BUILDING STREET ADDRESS (Including Apt., Unit, Suite, and/or Bldg. No.) OR P.O. ROUTE AND BOX NO. Tawny Lane (formerly Little Hodge Lane)			Policy Number
CITY Peeples Valley	STATE AZ	ZIP CODE 86322	Company NAIC Number

SECTION D - SURVEYOR, ENGINEER, OR ARCHITECT CERTIFICATION (CONTINUED)

Copy both sides of this Elevation Certificate for (1) community official, (2) insurance agent/company, and (3) building owner.

COMMENTS

Manufactured home. Elevation of bottom of structural frame is 4526.6. Required elevation per Yavapai County is 4527.4 (see attached). Benchmark used is RM 201. Home is skirted around base with sheet metal. As-built elevation taken on 11/18/99 by Field Survey.

Check here if attachments

SECTION E - BUILDING ELEVATION INFORMATION (SURVEY NOT REQUIRED) FOR ZONES AO and A (WITHOUT BFE)

For Zones AO and A (without BFE), complete Items E1 through E3. If the Elevation Certificate is intended for use as supporting information for a LOMA or LOMR-F, Section C must be completed.

- E1. Building Diagram Number ____ (Select the building diagram most similar to the building for which this certificate is being completed – see pages 4 and 5. If no diagram accurately represents the building, provide a sketch or photograph.)
- E2. The top of the bottom floor (including basement or enclosure) of the building is ft.(m) in.(cm) above or below (check one) the highest adjacent grade.
- E3. For Zone AO only: If no flood depth number is available, is the top of the bottom floor elevated in accordance with the community's floodplain management ordinance? Yes No Unknown. The local official must certify this information in Section G.

SECTION F - PROPERTY OWNER (OR OWNER'S REPRESENTATIVE) CERTIFICATION

The property owner or owner's authorized representative who completes Sections A, B, and E for Zone A (without a FEMA-issued or community-issued BFE) or Zone AO must sign here.

PROPERTY OWNER'S OR OWNER'S AUTHORIZED REPRESENTATIVE'S NAME

ADDRESS CITY STATE ZIP CODE

SIGNATURE DATE TELEPHONE

COMMENTS

Check here if attachments

SECTION G - COMMUNITY INFORMATION (OPTIONAL)

The local official who is authorized by law or ordinance to administer the community's floodplain management ordinance can complete Sections A, B, C (or E), and G of this Elevation Certificate. Check the applicable box(es) and sign below.

- G1. The information in Section C was taken from other documentation that has been signed and embossed by a licensed surveyor, engineer, or architect who is authorized by state or local law to certify elevation information. (Indicate the source and date of the elevation data in the Comments area below.)
- G2. A community official completed Section E for a building located in Zone A (without a FEMA-issued or community-issued BFE) or Zone AO.
- G3. The following information (Items G4-G9) is provided for community floodplain management purposes.

G4. PERMIT NUMBER	G5. DATE PERMIT ISSUED	G6. DATE CERTIFICATE OF COMPLIANCE/OCCUPANCY ISSUED
-------------------	------------------------	---

G7. This permit has been issued for: New Construction Substantial Improvement

G8. Elevation of as-built lowest floor (including basement) of the building is: _____ ft.(m) Datum: _____

G9. BFE or (in Zone AO) depth of flooding at the building site is: _____ ft.(m) Datum: _____

LOCAL OFFICIAL'S NAME TITLE

COMMUNITY NAME TELEPHONE

SIGNATURE DATE

COMMENTS

Check here if attachments

ELEVATION OF FLOODPLAIN PROPERTY

When Completed Return To: Yavapai County Flood Control District, 500 S. Marina St.,
Prescott, AZ, 86303, (520) 771-3197 FAX 771-3427

DATE JULY 22, 1999

ASSESSORS NUMBER 202-07-064

SUBDIVISION NAME AND NUMBER PEEPLER VALLEY, LOT 16

OWNER BILL GOODLOE


BASE BENCHMARK NUMBER RM 201
(on floodplain circuit)

BASE BENCHMARK ELEVATION 4511.52


PROPERTY BENCHMARK 4548.06

GROUND ELEVATION AT BUILDING SITE 4525.8

DESCRIPTION OF PROPERTY BENCHMARK N.E. PROP. CORNER, TOP OF REBAR

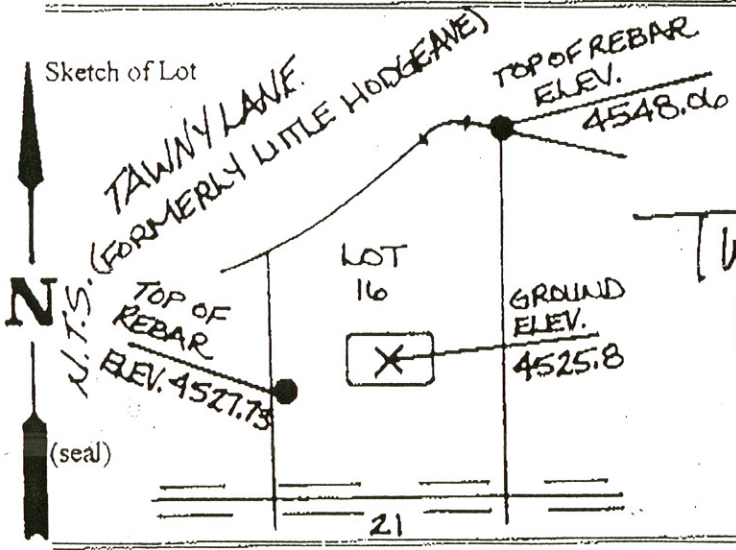

Remarks SET REBAR NEAR BUILDING SITE, ELEV. 4527.73, TOP OF REBAR.

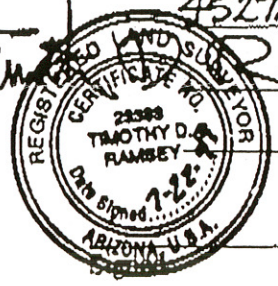

Company Name RAMSEY SURVEYING

Date: 7/23/99

FOR YAVAPAI COUNTY FLOOD CONTROL DISTRICT USE:

Base Flood Elevation	<u>4526.4'</u>	+ 1.0' = Regulatory Elevation	<u>4527.4'</u>
----------------------	----------------	-------------------------------	----------------

* ELEVATION DETERMINATIONS ARE BASED ON BEST AVAILABLE DATA WHEN CALCULATED. ELEVATIONS ARE SUBJECT TO CHANGE WHEN NEW OR REVISED FLOOD STUDIES, OR DATA IS SUPPLIED TO THE DISTRICT.