

**ELEVATION CERTIFICATE**  
**FEDERAL EMERGENCY MANAGEMENT AGENCY**  
**NATIONAL FLOOD INSURANCE PROGRAM**

O.M.B. No. 3067-0077

Expires July 31, 1999

**ATTENTION:** Use of this certificate does not provide a waiver of the flood insurance purchase requirement. This form is used only to provide elevation information necessary to ensure compliance with applicable community floodplain management ordinances, to determine the proper insurance premium rate, and/or to support a request for a Letter of Map Amendment or Revision (LOMA or LOMR). You are not required to respond to this collection of information unless a valid OMB control number is displayed in the upper right corner of this form.

**Instructions for completing this form can be found on the following pages.**

SECTION A PROPERTY INFORMATION		FOR INSURANCE COMPANY USE
BUILDING OWNERS NAME <b>Larry Scott</b>		POLICY NUMBER
STREET ADDRESS (Including Apt., Unit, Suite and/or Bldg. Number) OR P.O. ROUTE AND BOX NUMBER <b>P.O. Box 378</b>		COMPANY NAIC NUMBER
OTHER DESCRIPTION (Lot and Block Numbers, etc.) <b>Wineglass Acres, U-2, Portn. Lot 47      303-05-117C</b>		
CITY <b>Paulden</b>	STATE <b>AZ</b>	ZIP CODE <b>86334</b>

**SECTION B FLOOD INSURANCE RATE MAP (FIRM) INFORMATION**

Provide the following from the proper FIRM (See Instructions):

1. COMMUNITY NUMBER	2. PANEL NUMBER	3. SUFFIX	4. DATE OF FIRM INDEX	5. FIRM ZONE	6. BASE FLOOD ELEVATION (in AO Zones, use depth)
<b>040093</b>	<b>585</b>	<b>D</b>	<b>3/9/99</b>	<b>A3</b>	<b>4403.9</b>

7. Indicate the elevation datum system used on the FIRM for Base Flood Elevations (BFE):  NGVD '29     Other (describe on back)
8. For Zones A or V, where no BFE is provided on the FIRM, and the community has established a BFE for this building site, indicate the community's BFE:       feet NGVD (or other FIRM datum-see Section B, Item 7).

**SECTION C BUILDING ELEVATION INFORMATION**

- Using the Elevation Certificate Instructions, indicate the diagram number from the diagrams found on Pages 5 and 6 that best describes the subject building's reference level 7.
- (a). FIRM Zones A1-A30, AE, AH, and A (with BFE). The top of the reference level floor from the selected diagram is at an elevation of 4406.1 feet NGVD (or other FIRM datum-see Section B, Item 7).  
 (b). FIRM Zones V1-V30, VE, and V (with BFE). The bottom of the lowest horizontal structural member of the reference level from the selected diagram, is at an elevation of        feet NGVD (or other FIRM datum-see Section B, Item 7).  
 (c). FIRM Zone A (without BFE). The floor used as the reference level from the selected diagram is    feet above        or below    (check one) the highest grade adjacent to the building.  
 (d). FIRM Zone AO. The floor used as the reference level from the selected diagram is    feet above    or below    (check one) the highest grade adjacent to the building. If no flood depth number is available, is the building's lowest floor (reference level) elevated in accordance with the community's floodplain management ordinance?  Yes  No  Unknown
- Indicate the elevation datum system used in determining the above reference level elevations:  NGVD '29     Other (describe under Comments on Page 2). (NOTE: If the elevation datum used in measuring the elevations is different than that used on the FIRM (see Section B, Item 7), then convert the elevations to the datum system used on the FIRM and show the conversion equation under Comments on Page 2.)
- Elevation reference mark used appears on FIRM:  Yes  No (See Instructions on Page 4)
- The reference level elevation is based on:  actual construction  construction drawings  
 (NOTE:) Use of construction drawings is only valid if the building does not yet have the reference level floor in place, in which case this certificate will only be valid for the building during the course of construction. A post-construction Elevation Certificate will be required once construction is complete.)
- The elevation of the lowest grade immediately adjacent to the building is:       feet NGVD (or other FIRM datum-see Section B, Item 7).  
4 4 0 2 . 3

**SECTION D COMMUNITY INFORMATION**


- If the community official responsible for verifying building elevations specifies that the reference level indicated in Section C. Item 1 is not the "lowest floor" as defined in the community's floodplain management ordinance, the elevation of the building's "lowest floor" as defined by the ordinance is:       feet NGVD (or other FIRM datum-see Section B, Item 7).
- Date of the start of construction or substantial improvement 7/26/99

**SECTION E CERTIFICATION**

This certification is to be signed by a land surveyor, engineer, or architect who is authorized by state or local law to certify elevation information when the elevation information for Zones A1-A30, AE, AH, A (with BFE), V1-V30, VE, and V (with BFE) is required. Community officials who are authorized by local law or ordinance to provide floodplain management information, may also sign the certification. In the case of Zones AO and A (without a FEMA or community issued BFE), a building official, a property owner, or an owner's representative may also sign the certification.

Reference level diagrams 6, 7 and 8 - Distinguishing Features-If the certifier is unable to certify to breakaway/non-breakaway wall, enclosure size, location of servicing equipment, area use, wall openings, or unfinished area Feature(s), then list the Feature(s) not included in the certification under Comments below. The diagram number, Section C, Item 1, must still be entered.


*I certify that the information in Sections B and C on this certificate represents my best efforts to interpret the data available. I understand that any false statement may be punishable by fine or imprisonment under 18 U.S. Code, Section 1001.*

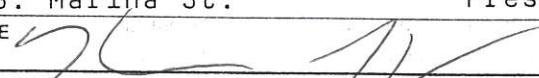CERTIFIER'S NAME		LICENSE NUMBER (or Affix Seal)	
Kenneth E. Spedding,			
TITLE		COMPANY NAME	
District Director			
ADDRESS		CITY	
500 S. Marina St.		Prescott	
		STATE	
		AZ	
		ZIP	
		86303	
SIGNATURE 		DATE	
		8/31/99	
		PHONE	
		(520) 771-3197	

Copies should be made of this Certificate for: 1) community official, 2) insurance agent/company, and 3) building owner.

**COMMENTS:**

Structure is a manufactured home. Elevation (2a) is to the bottom of the structural frame.

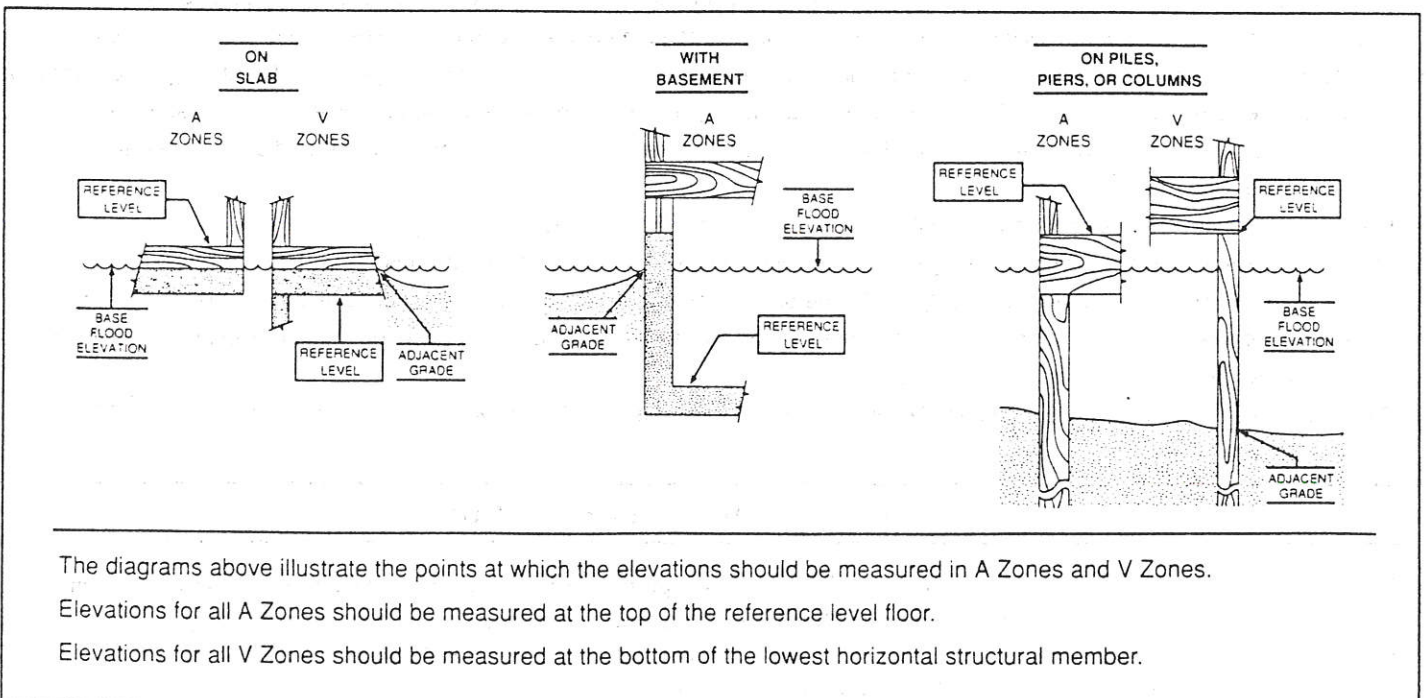

"AS BUILT" ELEVATIONS FOR EITHER MANUFACTURED HOMES . SITE BUILT HOMES

When Completed Return To: Yavapai County Flood Control District

**Section 1 - Complete entire section**

DATE AUG. 21, 1999 ASSESSORS NUMBER 303-05-117

SUBDIVISION NAME AND LOT NUMBER WINEGLASS ACRES, UNIT 2, POR. LOT 47

OWNER LARRY SCOTT

BASE BENCHMARK NUMBER RM 52  
(on floodplain circuit)

ELEVATION OF THE LOWEST GRADE  
IMMEDIATELY ADJACENT TO THE BUILDING 4402.3

PROPERTY BENCHMARK ELEVATION 4403.63

DIAGRAM # (from Page 5 & 6 of OMB No. 3067-0070) 7

**Section 2 - Complete if appropriate**

**'As Built' Elevation for Manufactured Homes**

SURVEYED BOTTOM OF STRUCTURAL FRAME OR  
LOWEST POINT OF ANY ATTACHED APPLIANCES 4406.11

(seal)

Signed RAMSEY SURVEYING



**Section 3 - Complete if appropriate**

**'As Built' Elevation for Site Built Homes**

SURVEYED LOWEST FLOOR \_\_\_\_\_

(seal)

Signed \_\_\_\_\_

**FOR DISTRICT USE:**

REQUIRED ELEVATION TO BOTTOM OF STRUCTURAL FRAME  
OR LOWEST POINT OF ANY ATTACHED APPLIANCES \_\_\_\_\_

(As Per Development Permit) \_\_\_\_\_


DIFFERENCE \_\_\_\_\_

REQUIRED LOWEST FLOOR ELEVATION \_\_\_\_\_

(As Per Development Permit) \_\_\_\_\_

DIFFERENCE \_\_\_\_\_

PARCELS "C" AND "D", LOT 47  
WINEGLASS ACRES, UNIT 2

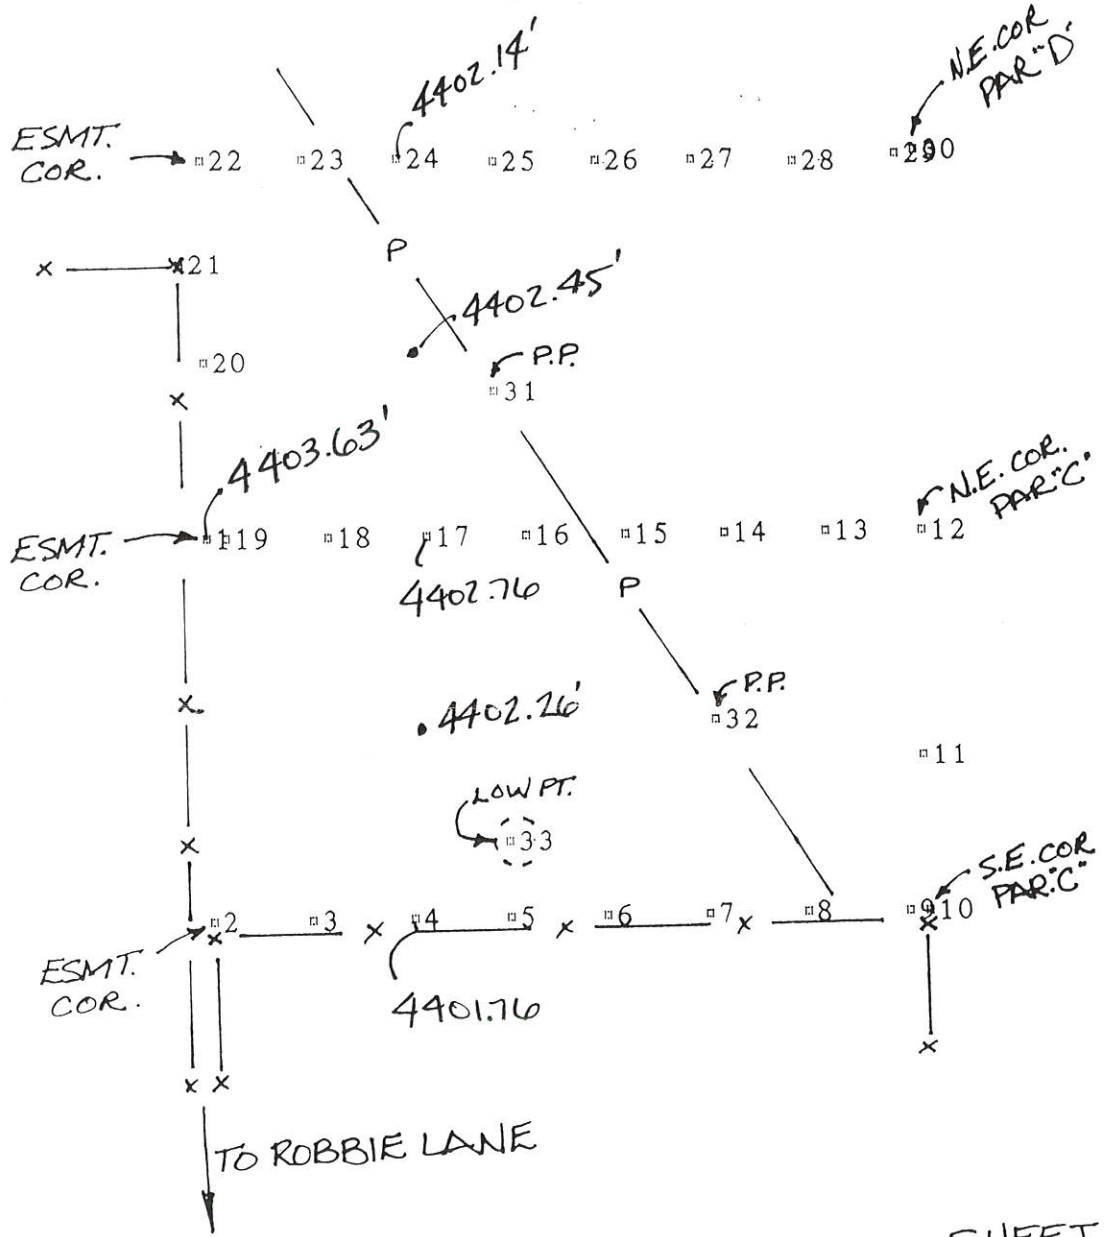

# ELEVATION OF FLOODPLAIN PROPERTY

When Completed Return To: Yavapai County Flood Control District, 500 S. Marina St.,  
Prescott, AZ, 86303, (520) 771-3197 FAX 771-3427

DATE JULY 10, 1999

ASSESSORS NUMBER 308-05-117

SUBDIVISION NAME AND NUMBER WINEGLASS ACRES, UNIT 2, POR. LOT 47

OWNER LARRY SCOTT


BASE BENCHMARK NUMBER RM 52  
(on floodplain circuit)

BASE BENCHMARK ELEVATION 4408.36

PROPERTY BENCHMARK 4403.63

GROUND ELEVATION AT BUILDING SITE 4402.3


DESCRIPTION OF PROPERTY BENCHMARK NORTH WEST EASEMENT  
CORNER, TOP OF REBAR

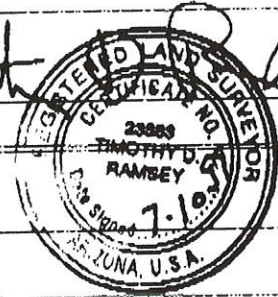

Sketch of Lot



TO ROBBIE LANE

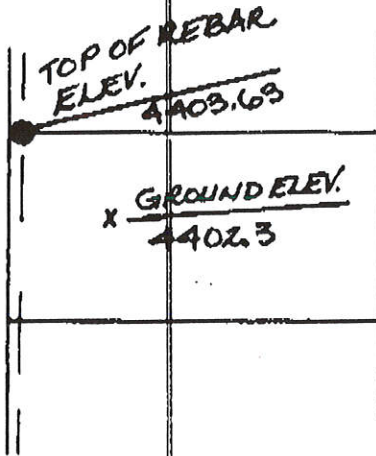

Remarks

PAR. "C", RECORD OF  
SURVEY 32/35 O.R.

Signed

Timothy D. Ramsey  
**RAMSEY SURVEYING, INC.**  
Company Name

Date: \_\_\_\_\_

**FOR YAVAPAI COUNTY FLOOD CONTROL DISTRICT USE:**

Base Flood Elevation	+ 1.0' = Regulatory Elevation
----------------------	-------------------------------

\* ELEVATION DETERMINATIONS ARE BASED ON BEST AVAILABLE DATA WHEN CALCULATED. ELEVATIONS ARE SUBJECT TO CHANGE WHEN NEW OR REVISED FLOOD STUDIES, OR DATA IS SUPPLIED TO THE DISTRICT.

99.199