

FEDERAL EMERGENCY MANAGEMENT AGENCY
NATIONAL FLOOD INSURANCE PROGRAM

O.M.B. No. 3067-0077
Expires July 31, 2002

ELEVATION CERTIFICATE

Important: Read the instructions on pages 1 - 7.

SECTION A - PROPERTY OWNER INFORMATION			For Insurance Company Use:	
BUILDING OWNER'S NAME KEN SMITH			Policy Number	
BUILDING STREET ADDRESS (Including Apt., Unit, Suite, and/or Bldg. No.) OR P.O. ROUTE AND BOX NO. 24825 N. Catalina St. (MAIL P.O. BOX 4432 CHINO VALLEY AZ 86323)			Company NAIC Number	
CITY PAULDEN	STATE AZ	ZIP CODE 86334		
PROPERTY DESCRIPTION (Lot and Block Numbers, Tax Parcel Number, Legal Description, etc.) APN 304-01-041B SEC. 34, T18N, R2W, GSRBM				
BUILDING USE (e.g., Residential, Non-residential, Addition, Accessory, etc. Use a Comments area, if necessary.) RESIDENTIAL				
LATITUDE/LONGITUDE (OPTIONAL) (##° - ##' - ##.###" or ###.####°)		HORIZONTAL DATUM: <input type="checkbox"/> NAD 1927 <input type="checkbox"/> NAD 1983		SOURCE: <input type="checkbox"/> GPS (Type): _____ <input type="checkbox"/> USGS Quad Map <input type="checkbox"/> Other: _____
NA				

SECTION B - FLOOD INSURANCE RATE MAP (FIRM) INFORMATION

B1. NFIP COMMUNITY NAME & COMMUNITY NUMBER YAVAPAI COUNTY UNINCORPORATED 040093		B2. COUNTY NAME YAVAPAI		B3. STATE AZ	
B4. MAP AND PANEL NUMBER 04025C0990	B5. SUFFIX F	B6. FIRM INDEX DATE 6/6/2001	B7. FIRM PANEL EFFECTIVE/REVISED DATE 6/6/2001	B8. FLOOD ZONE(S) AE	B9. BASE FLOOD ELEVATION(S) (Zone AO, use depth of flooding) 4423.11
B10. Indicate the source of the Base Flood Elevation (BFE) data or base flood depth entered in B9. <input checked="" type="checkbox"/> FIS Profile <input type="checkbox"/> FIRM <input type="checkbox"/> Community Determined <input type="checkbox"/> Other (Describe): _____					
B11. Indicate the elevation datum used for the BFE in B9: <input checked="" type="checkbox"/> NGVD 1929 <input type="checkbox"/> NAVD 1988 <input type="checkbox"/> Other (Describe): _____					
B12. Is the building located in a Coastal Barrier Resources System (CBRS) area or Otherwise Protected Area (OPA)? <input type="checkbox"/> Yes <input checked="" type="checkbox"/> No Designation Date _____					

SECTION C - BUILDING ELEVATION INFORMATION (SURVEY REQUIRED)

C1. Building elevations are based on: Construction Drawings* Building Under Construction* Finished Construction
*A new Elevation Certificate will be required when construction of the building is complete.

C2. Building Diagram Number 8 (Select the building diagram most similar to the building for which this certificate is being completed - see pages 6 and 7. If no diagram accurately represents the building, provide a sketch or photograph.)

C3. Elevations - Zones A1-A30, AE, AH, A (with BFE), VE, V1-V30, V (with BFE), AR, AR/A, AR/AE, AR/A1-A30, AR/AH, AR/AO
Complete Items C3.-a-i below according to the building diagram specified in Item C2. State the datum used. If the datum is different from the datum used for the BFE in Section B, convert the datum to that used for the BFE. Show field measurements and datum conversion calculation. Use the space provided or the Comments area of Section D or Section G, as appropriate, to document the datum conversion.
Datum NA Conversion/Comments _____

Elevation reference mark used RM18 Does the elevation reference mark used appear on the FIRM? Yes No

a) Top of bottom floor (including basement or enclosure)	4426.0 ft.(m)
b) Top of next higher floor	NA. ft.(m)
c) Bottom of lowest horizontal structural member (SEE COMMENTS)	4425.0 ft.(m)
d) Attached garage (top of slab)	NA. ft.(m)
e) Lowest elevation of machinery and/or equipment servicing the building (Describe in a Comments area)	NA. ft.(m)
f) Lowest adjacent (finished) grade (LAG)	4423.4 ft.(m)
g) Highest adjacent (finished) grade (HAG)	4424.3 ft.(m)
h) No. of permanent openings (flood vents) within 1 ft. above adjacent grade <u>NA</u>	
i) Total area of all permanent openings (flood vents) in C3.h <u>NA</u> sq. in. (sq. cm)	

License Number, Embossed Seal, Signature, and Date



SECTION D - SURVEYOR, ENGINEER, OR ARCHITECT CERTIFICATION

This certification is to be signed and sealed by a land surveyor, engineer, or architect authorized by law to certify elevation information.
I certify that the information in Sections A, B, and C on this certificate represents my best efforts to interpret the data available.
I understand that any false statement may be punishable by fine or imprisonment under 18 U.S. Code, Section 1001.

CERTIFIER'S NAME	DUANE FAMAS	LICENSE NUMBER	AZ RLS 27737
TITLE	LAND SURVEYOR/PRESIDENT	COMPANY NAME	FAMAS LAND SURVEYORS, INC.
ADDRESS	P.O. BOX 4357	CITY	PRESCOTT
		STATE	AZ
		ZIP CODE	86302
SIGNATURE	<u>Duane Famas</u>	DATE	AUG 5, 2002
	AZ RLS 27737	TELEPHONE	928-717-2844

IMPORTANT: In these spaces, copy the corresponding information from Section A.			For Insurance Company Use:
BUILDING STREET ADDRESS (Including Apt., Unit, St. or Bldg. No.) OR P.O. ROUTE AND BOX NO. CATALINA STREET (MAIL PO BOX 4432 CHINO VALLEY AZ 86323)			Policy Number
CITY PAULDEN	STATE AZ	ZIP CODE 86334	Company NAIC Number

SECTION D - SURVEYOR, ENGINEER, OR ARCHITECT CERTIFICATION (CONTINUED)

Copy both sides of this Elevation Certificate for (1) community official, (2) insurance agent/company, and (3) building owner.

COMMENTS
 MANUFACTURED HOME ON BLOCK STEM WALL, NO PERMANENT FLOOD VENTS, ONE 30 INCH ACCESS AT WEST END OF BUILDING.
 BOTTOM OF FRAME IS AT AN ELEVATION OF 4425.0 FT

SEE MAP ATTACHED

Check here if attachments

SECTION E - BUILDING ELEVATION INFORMATION (SURVEY NOT REQUIRED) FOR ZONE AO AND ZONE A (WITHOUT BFE)

For Zone AO and Zone A (without BFE), complete Items E1 through E4. If the Elevation Certificate is intended for use as supporting information for a LOMA or LOMR-F, Section C must be completed.

- E1. Building Diagram Number __ (Select the building diagram most similar to the building for which this certificate is being completed – see pages 6 and 7. If no diagram accurately represents the building, provide a sketch or photograph.)
- E2. The top of the bottom floor (including basement or enclosure) of the building is __ ft.(m) __ in.(cm) above or below (check one) the highest adjacent grade. (Use natural grade, if available).
- E3. For Building Diagrams 6-8 with openings (see page 7), the next higher floor or elevated floor (elevation b) of the building is __ ft.(m) __ in.(cm) above the highest adjacent grade. Complete items C3.h and C3.i on front of form.
- E4. For Zone AO only: If no flood depth number is available, is the top of the bottom floor elevated in accordance with the community's floodplain management ordinance?
 Yes No Unknown. The local official must certify this information in Section G.

SECTION F - PROPERTY OWNER (OR OWNER'S REPRESENTATIVE) CERTIFICATION

The property owner or owner's authorized representative who completes Sections A, B, C (Items C3.h and C3.i only), and E for Zone A (without a FEMA-issued or community-issued BFE) or Zone AO must sign here. The statements in Sections A, B, C, and E are correct to the best of my knowledge.

PROPERTY OWNER'S OR OWNER'S AUTHORIZED REPRESENTATIVE'S NAME

ADDRESS	CITY	STATE	ZIP CODE
SIGNATURE	DATE	TELEPHONE	
COMMENTS			

Check here if attachments

SECTION G - COMMUNITY INFORMATION (OPTIONAL)

The local official who is authorized by law or ordinance to administer the community's floodplain management ordinance can complete Sections A, B, C (or E), and G of this Elevation Certificate. Complete the applicable item(s) and sign below.

- G1. The information in Section C was taken from other documentation that has been signed and embossed by a licensed surveyor, engineer, or architect who is authorized by state or local law to certify elevation information. (Indicate the source and date of the elevation data in the Comments area below.)
- G2. A community official completed Section E for a building located in Zone A (without a FEMA-issued or community-issued BFE) or Zone AO.
- G3. The following information (Items G4-G9) is provided for community floodplain management purposes.

G4. PERMIT NUMBER	G5. DATE PERMIT ISSUED	G6. DATE CERTIFICATE OF COMPLIANCE/OCCUPANCY ISSUED
-------------------	------------------------	---

G7. This permit has been issued for: New Construction Substantial Improvement

G8. Elevation of as-built lowest floor (including basement) of the building is: _____ ft.(m) Datum: _____

G9. BFE or (in Zone AO) depth of flooding at the building site is: _____ ft.(m) Datum: _____

LOCAL OFFICIAL'S NAME	TITLE
COMMUNITY NAME	TELEPHONE
SIGNATURE	DATE
COMMENTS	

Check here if attachments

ELEVATION CERTIFICATE SKETCH

PARCEL 304-01-041B

SEC. 34, T18N, R2W, G & SRB & M., YAVAPAI COUNTY, ARIZONA



DATE OF SURVEY

JULY, 2002

DRAWING SCALE

1 IN = 100 FT

THIS IS NOT A BOUNDARY SURVEY

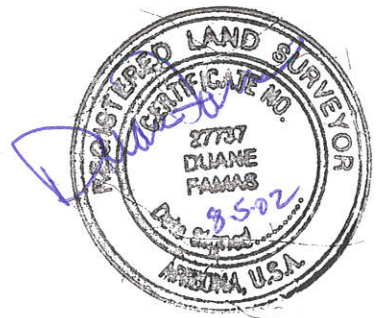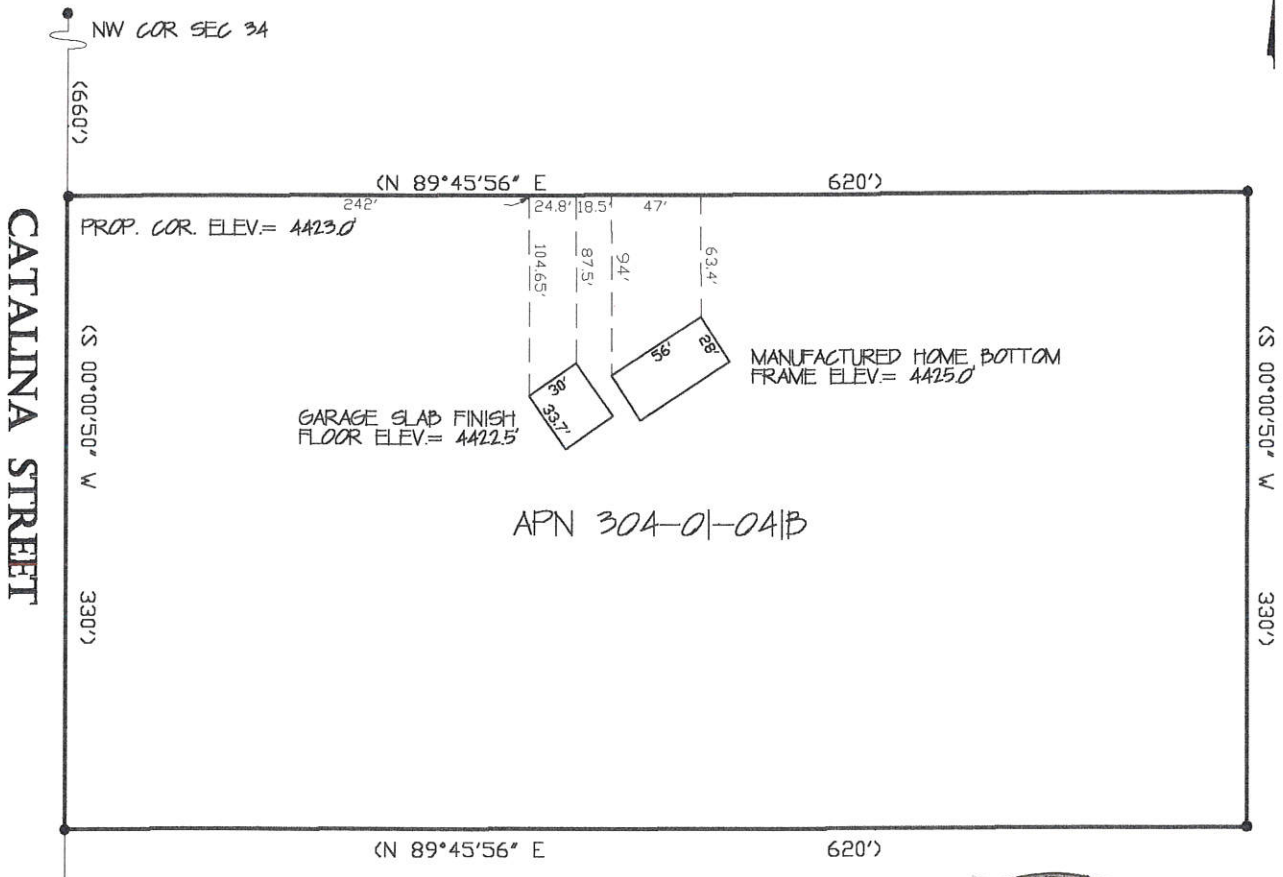

- = FOUND 1/2" REBAR MARKED "FAMAS"
- () = RECORD INFORMATION



FAMAS LAND SURVEYORS, INC.

P.O. BOX 4357 PRESCOTT, AZ 86302
 PHONE (928)-717-2844 FAX (928)-717-2840

DRAWN BY: DEF | FILE NO.: 378BY01

NOTE THAT ALL EASEMENTS OF RECORD MAY NOT BE SHOWN ON THIS PLAT