

FEDERAL EMERGENCY MANAGEMENT AGENCY
NATIONAL FLOOD INSURANCE PROGRAM

O.M.B. No. 3067-0077
Expires July 31, 2002

ELEVATION CERTIFICATE

Important: Read the instructions on pages 1 - 7.

SECTION A - PROPERTY OWNER INFORMATION			For Insurance Company Use:
BUILDING OWNER'S NAME PAUL AND SUSAN HURLEY			Policy Number
BUILDING STREET ADDRESS (Including Apt., Unit, Suite, and/or Bldg. No.) OR P.O. ROUTE AND BOX NO. 25020 LARITA RD			Company NAIC Number
CITY PAULDEN	STATE AZ	ZIP CODE 86334	
PROPERTY DESCRIPTION (Lot and Block Numbers, Tax Parcel Number, Legal Description, etc.) APN 304-01-095R			
BUILDING USE (e.g., Residential, Non-residential, Addition, Accessory, etc. Use a Comments area, if necessary.) RESIDENTIAL			
LATITUDE/LONGITUDE (OPTIONAL) (##° - ##' - ##.###" or ##.#####°)		HORIZONTAL DATUM: <input type="checkbox"/> NAD 1927 <input type="checkbox"/> NAD 1983	SOURCE: <input type="checkbox"/> GPS (Type): _____ <input type="checkbox"/> USGS Quad Map <input type="checkbox"/> Other: _____

SECTION B - FLOOD INSURANCE RATE MAP (FIRM) INFORMATION

B1. NFIP COMMUNITY NAME & COMMUNITY NUMBER Yavapai County 040093		B2. COUNTY NAME Yavapai County		B3. STATE Arizona	
B4. MAP AND PANEL NUMBER 04025C0970	B5. SUFFIX F	B6. FIRM INDEX DATE 6/6/01	B7. FIRM PANEL EFFECTIVE/REVISED DATE 6/6/01	B8. FLOOD ZONE(S) AE	B9. BASE FLOOD ELEVATION(S) (Zone AO, use depth of flooding) 4379.8

B10. Indicate the source of the Base Flood Elevation (BFE) data or base flood depth entered in B9.
 FIS Profile FIRM Community Determined Other (Describe): _____

B11. Indicate the elevation datum used for the BFE in B9: NGVD 1929 NAVD 1988 Other (Describe): _____

B12. Is the building located in a Coastal Barrier Resources System (CBRS) area or Otherwise Protected Area (OPA)? Yes No Designation Date _____

SECTION C - BUILDING ELEVATION INFORMATION (SURVEY REQUIRED)

C1. Building elevations are based on: Construction Drawings* Building Under Construction* Finished Construction
 *A new Elevation Certificate will be required when construction of the building is complete.

C2. Building Diagram Number 8 (Select the building diagram most similar to the building for which this certificate is being completed - see pages 6 and 7. If no diagram accurately represents the building, provide a sketch or photograph.)

C3. Elevations - Zones A1-A30, AE, AH, A (with BFE), VE, V1-V30, V (with BFE), AR, AR/A, AR/AE, AR/A1-A30, AR/AH, AR/AO
 Complete Items C3.-a-i below according to the building diagram specified in Item C2. State the datum used. If the datum is different from the datum used for the BFE in Section B, convert the datum to that used for the BFE. Show field measurements and datum conversion calculation. Use the space provided or the Comments area of Section D or Section G, as appropriate, to document the datum conversion.
 Datum _____ Conversion/Comments _____

Elevation reference mark used 50-3 Does the elevation reference mark used appear on the FIRM? Yes No (RM 13)

a) Top of bottom floor (including basement or enclosure)	4380. 13 ft.(m)
b) Top of next higher floor	_____ ft.(m)
c) Bottom of lowest horizontal structural member (V zones only)	_____ ft.(m)
d) Attached garage (top of slab)	4378. 00 ft.(m)
e) Lowest elevation of machinery and/or equipment servicing the building (Describe in a Comments area)	_____ ft.(m)
f) Lowest adjacent (finished) grade (LAG)	4377. 20 ft.(m)
g) Highest adjacent (finished) grade (HAG)	4377. 80 ft.(m)
h) No. of permanent openings (flood vents) within 1 ft. above adjacent grade * GARAGE 390 sq in (SEE COMMENTS)	
i) Total area of all permanent openings (flood vents) in C3.h **sq. in. (sq. cm) (SEE COMMENTS)	

License Number, Embossed Seal, Signature, and Date



SECTION D - SURVEYOR, ENGINEER, OR ARCHITECT CERTIFICATION

This certification is to be signed and sealed by a land surveyor, engineer, or architect authorized by law to certify elevation information.
 I certify that the information in Sections A, B, and C on this certificate represents my best efforts to interpret the data available.
 I understand that any false statement may be punishable by fine or imprisonment under 18 U.S. Code, Section 1001.

CERTIFIER'S NAME DUANE FAMAS	LICENSE NUMBER AZ RLS 27737		
TITLE LS/PRESIDENT	COMPANY NAME FAMAS LAND SURVEYORS, INC		
ADDRESS PO BOX 4357 SIGNATURE	CITY PRESCOTT DATE 6/28/01	STATE AZ TELEPHONE 928-717-2844	ZIP CODE 86302

IMPORTANT: In these spaces, copy the corresponding information from Section A.			For Insurance Company Use:
BUILDING STREET ADDRESS (Including Apt., Unit, Suite, or Bldg. No.) OR P.O. ROUTE AND BOX NO. 25020 Larita Road			Policy Number
CITY: Paulden	STATE AZ	ZIP CODE 86334	Company NAIC Number

SECTION D - SURVEYOR, ENGINEER, OR ARCHITECT CERTIFICATION (CONTINUED)

Copy both sides of this Elevation Certificate for (1) community official, (2) insurance agent/company, and (3) building owner.

COMMENTS

* North and South ends of the elevated structure are open for flood flow thru. The North wall of garage has 6 - 65 sq in vents for a total of 390 sq in.
 ** The structure is elevated by concrete stem walls under the East and West walls and down the center (all parallel)

the North end being 26 feet wide and 1.6 feet high, the South end is 26 feet wide and 2.3 feet high.
 NOTE THAT RM 50-3 WAS USED (NEW FIRM MAP SHOWS AS RM 13 BUT ERRONEOUSLY REPORTS DATA FOR RM 50-2)

Check here if attachments

SECTION E - BUILDING ELEVATION INFORMATION (SURVEY NOT REQUIRED) FOR ZONE AO AND ZONE A (WITHOUT BFE)

For Zone AO and Zone A (without BFE), complete Items E1 through E4. If the Elevation Certificate is intended for use as supporting information for a LOMA or LOMR-F, Section C must be completed.

- E1. Building Diagram Number __ (Select the building diagram most similar to the building for which this certificate is being completed – see pages 6 and 7. If no diagram accurately represents the building, provide a sketch or photograph.)
- E2. The top of the bottom floor (including basement or enclosure) of the building is __ ft.(m) __ in.(cm) above or below (check one) the highest adjacent grade. (Use natural grade, if available).
- E3. For Building Diagrams 6-8 with openings (see page 7), the next higher floor or elevated floor (elevation b) of the building is __ ft.(m) __ in.(cm) above the highest adjacent grade. Complete items C3.h and C3.i on front of form.
- E4. For Zone AO only: If no flood depth number is available, is the top of the bottom floor elevated in accordance with the community's floodplain management ordinance?
 Yes No Unknown. The local official must certify this information in Section G.

SECTION F - PROPERTY OWNER (OR OWNER'S REPRESENTATIVE) CERTIFICATION

The property owner or owner's authorized representative who completes Sections A, B, C (Items C3.h and C3.i only), and E for Zone A (without a FEMA-issued or community-issued BFE) or Zone AO must sign here. The statements in Sections A, B, C, and E are correct to the best of my knowledge.

PROPERTY OWNER'S OR OWNER'S AUTHORIZED REPRESENTATIVE'S NAME

ADDRESS CITY STATE ZIP CODE

SIGNATURE DATE TELEPHONE

COMMENTS

Check here if attachments

SECTION G - COMMUNITY INFORMATION (OPTIONAL)

The local official who is authorized by law or ordinance to administer the community's floodplain management ordinance can complete Sections A, B, C (or E), and G of this Elevation Certificate. Complete the applicable item(s) and sign below.

- G1. The information in Section C was taken from other documentation that has been signed and embossed by a licensed surveyor, engineer, or architect who is authorized by state or local law to certify elevation information. (Indicate the source and date of the elevation data in the Comments area below.)
- G2. A community official completed Section E for a building located in Zone A (without a FEMA-issued or community-issued BFE) or Zone AO.
- G3. The following information (Items G4-G9) is provided for community floodplain management purposes.

G4. PERMIT NUMBER	G5. DATE PERMIT ISSUED	G6. DATE CERTIFICATE OF COMPLIANCE/OCCUPANCY ISSUED
-------------------	------------------------	---

G7. This permit has been issued for: New Construction Substantial Improvement

G8. Elevation of as-built lowest floor (including basement) of the building is: _____ ft.(m) Datum: _____

G9. BFE or (in Zone AO) depth of flooding at the building site is: _____ ft.(m) Datum: _____

LOCAL OFFICIAL'S NAME TITLE

COMMUNITY NAME TELEPHONE

SIGNATURE DATE

COMMENTS

Check here if attachments

FLOOD ELEVATION

APN 304-01-095R
 SEC. 29, T18N, R2W, G. & S.R.B. & M.,
 YAVAPAI COUNTY, ARIZONA



ELEVATIONS BASED ON RM50-3
 WITH AN ELEVATION OF 4378.475



LEGEND

- = FOUND 1/2" REBAR #23383 OR AS NOTED
- = 1/2" REBAR WITH PLASTIC CAP STAMPED "FAMAS"

DETAIL SECTION OF NEW SINGLE FAMILY RESIDENCE

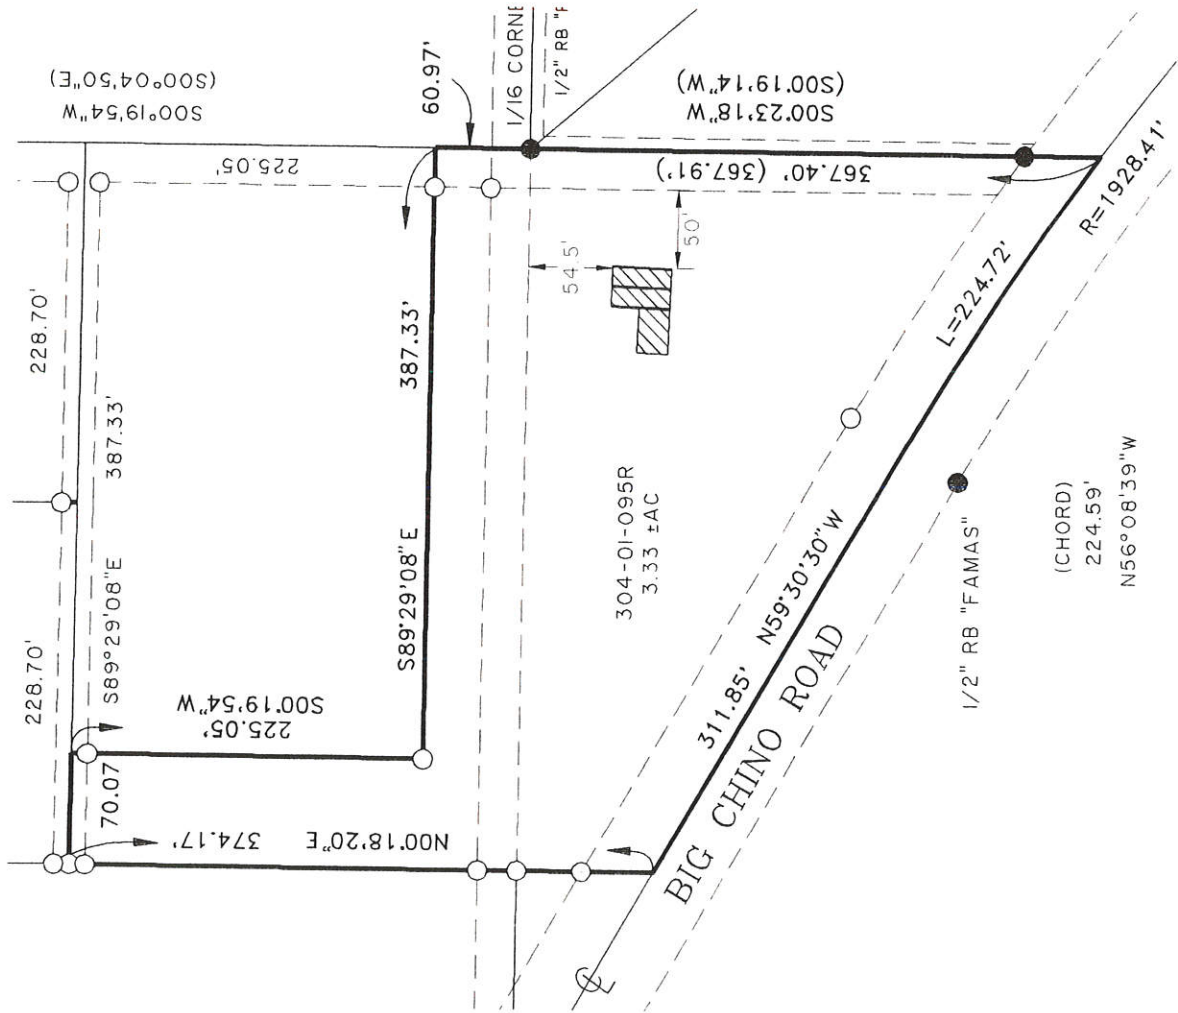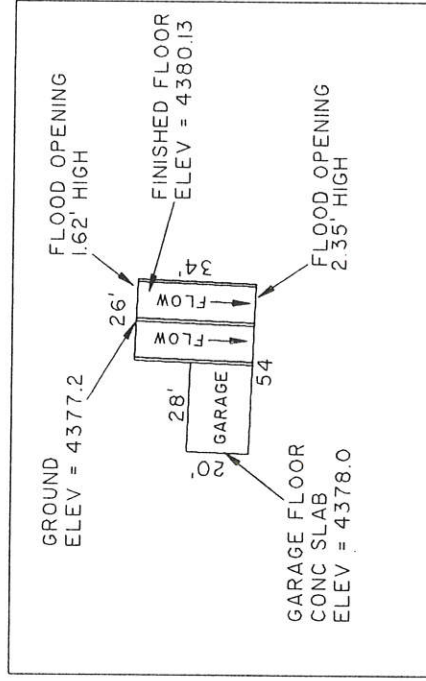

FAMAS LAND SURVEYORS, INC.
 P.O. BOX 4357 PRESCOTT, AZ 86302
 PHONE (909)-717-2844 FAX (909)-717-2840

DATE OF SURVEY: 12-09-98
 DATE DRAWN: 12-10-98
 DRAWN BY: RSP
 FILE NO: 758198
 FOR: PAUL HURLEY

ELEVATION OF FLOODPLAIN PROPERTY

When Completed Return To: Yavapai County Flood Control District, 500 S. Marina St., Prescott, AZ, 86303
(520) 771-3197 FAX 771-3427


DATE 3/22/00
ASSESSORS NUMBER 304-01-095R
SUBDIVISION NAME AND NUMBER 11 METES & BOUNDS
OWNER PAUL HURLEY
SITUS ADDRESS _____
BASE BENCHMARK: Number RM 50-2 Elevation 4378.215

PROPERTY BENCHMARK SITE TBM 4378.89
DESCRIPTION OF PROPERTY BENCHMARK 1/2" REBAR S of NE PROPERTY CORNER


GROUND ELEVATIONS AT BUILDING SITE E 4378.7 J 4378.1 G 4377.3
(Please provide a minimum of three (3) elevations points, representative of the site)

Sketch of Lot (include location of property benchmark and building site elevations) Remarks A 4377.7 B 77.1

X TBM 304-01-095T C 75.9 D 76.9
EL 4383.09 SECOR E 78.7 F 79.3
G 77.3 H 76.0 J 78.1

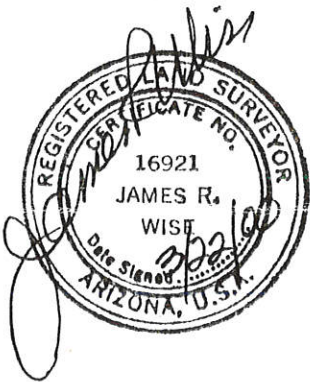

(Seal)

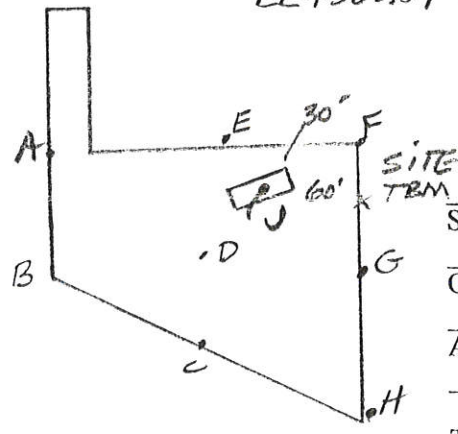

Signed James R. Wise
Company Name KEYEY/WISE ENGINEERING INC
Address 146 GROVE AVE
PRESCOTT AZ 86301
Telephone (520) 771-1730

FOR YAVAPAI COUNTY FLOOD CONTROL DISTRICT USE: Date: 3/31/00

Base Flood Elevation 4379.8' + 1.0' = Regulatory Elevation 4380.8'

* ELEVATION DETERMINATIONS ARE BASED ON BEST AVAILABLE DATA WHEN CALCULATED. ELEVATIONS ARE SUBJECT TO CHANGE WHEN NEW OR REVISED FLOOD STUDIES, OR DATA IS SUPPLIED TO THE DISTRICT.

