

ELEVATION CERTIFICATE

OMB No. 1660-0008
Expires February 28, 2009


Important: Read the instructions on pages 1-8.

SECTION A - PROPERTY INFORMATION			For Insurance Company Use:
A1. Building Owner's Name <u>LEIGH, NED & RITA MRS</u>		Policy Number	
A2. Building Street Address (including Apt., Unit, Suite, and/or Bldg. No.) or P.O. Route and Box No. <u>24605 NORTH FEATHER MOUNTAIN ROAD</u>		Company NAIC Number	
City <u>PAULDEN</u>	State <u>ARIZONA</u>	ZIP Code <u>86334</u>	
A3. Property Description (Lot and Block Numbers, Tax Parcel Number, Legal Description, etc.) <u>APN 304-01-185B</u>			
A4. Building Use (e.g., Residential, Non-Residential, Addition, Accessory, etc.) <u>RESIDENTIAL</u>			
A5. Latitude/Longitude: Lat. <u>34 54 14.8</u> Long. <u>-112 30 16.9</u>		Horizontal Datum: <input type="checkbox"/> NAD 1927 <input checked="" type="checkbox"/> NAD 1983	
A6. Attach at least 2 photographs of the building if the Certificate is being used to obtain flood insurance. <u>N/A</u>			
A7. Building Diagram Number <u>1</u>			
A8. For a building with a crawl space or enclosure(s), provide: <u>N/A</u>		A9. For a building with an attached garage, provide:	
a) Square footage of crawl space or enclosure(s) _____ sq ft	a) Square footage of attached garage <u>400</u> sq ft		
b) No. of permanent flood openings in the crawl space or enclosure(s) walls within 1.0 foot above adjacent grade _____	b) No. of permanent flood openings in the attached garage walls within 1.0 foot above adjacent grade <u>0</u>		
c) Total net area of flood openings in A8.b _____ sq ft	c) Total net area of flood openings in A9.b <u>0</u> sq ft		

SECTION B - FLOOD INSURANCE RATE MAP (FIRM) INFORMATION					
B1. NFIP Community Name & Community Number <u>040093</u>		B2. County Name <u>YAVAPAI</u>		B3. State <u>AZ</u>	
B4. Map/Panel Number <u>04025C0900</u>	B5. Suffix <u>F</u>	B6. FIRM Index Date <u>6-6-01</u>	B7. FIRM Panel Effective/Revised Date <u>6-6-01</u>	B8. Flood Zone(s) <u>AE</u>	B9. Base Flood Elevation(s) (Zone AO, use base flood depth) <u>4378.70</u>
B10. Indicate the source of the Base Flood Elevation (BFE) data or base flood depth entered in Item B9. <input checked="" type="checkbox"/> FIS Profile <input type="checkbox"/> FIRM <input type="checkbox"/> Community Determined <input type="checkbox"/> Other (Describe) _____					
B11. Indicate elevation datum used for BFE in Item B9: <input checked="" type="checkbox"/> NGVD 1929 <input type="checkbox"/> NAVD 1988 <input type="checkbox"/> Other (Describe) _____					
B12. Is the building located in a Coastal Barrier Resources System (CBRS) area or Otherwise Protected Area (OPA)? <input type="checkbox"/> Yes <input checked="" type="checkbox"/> No Designation Date _____ <input type="checkbox"/> CBRS <input type="checkbox"/> OPA					

SECTION C - BUILDING ELEVATION INFORMATION (SURVEY REQUIRED)	
C1. Building elevations are based on: <input type="checkbox"/> Construction Drawings* <input type="checkbox"/> Building Under Construction* <input checked="" type="checkbox"/> Finished Construction *A new Elevation Certificate will be required when construction of the building is complete.	
C2. Elevations - Zones A1-A30, (E) AH, A (with BFE), VE, V1-V30, V (with BFE), AR, AR/A, AR/AE, AR/A1-A30, AR/AH, AR/AO. Complete Items C2.a-g below according to the building diagram specified in Item A7. Benchmark Utilized <u>RM 50-2</u> <u>4378.215</u> Vertical Datum <u>MGVD 29</u> Conversion/Comments <u>NE CORNER 1/2" REBAR ELEVATION 4376.50 (SITE BENCH)</u>	
Check the measurement used.	
a) Top of bottom floor (including basement, crawl space, or enclosure floor) <u>4378.73</u> <input checked="" type="checkbox"/> feet <input type="checkbox"/> meters (Puerto Rico only)	
b) Top of the next higher floor <u>N/A</u> <input type="checkbox"/> feet <input type="checkbox"/> meters (Puerto Rico only)	
c) Bottom of the lowest horizontal structural member (V Zones only) <u>N/A</u> <input type="checkbox"/> feet <input type="checkbox"/> meters (Puerto Rico only)	
d) Attached garage (top of slab) <u>4378.43</u> <input checked="" type="checkbox"/> feet <input type="checkbox"/> meters (Puerto Rico only)	
e) Lowest elevation of machinery or equipment servicing the building (Describe type of equipment in Comments) <u>4381.50</u> <input checked="" type="checkbox"/> feet <input type="checkbox"/> meters (Puerto Rico only)	
f) Lowest adjacent (finished) grade (LAG) <u>4376.52</u> <input checked="" type="checkbox"/> feet <input type="checkbox"/> meters (Puerto Rico only)	
g) Highest adjacent (finished) grade (HAG) <u>4377.31</u> <input checked="" type="checkbox"/> feet <input type="checkbox"/> meters (Puerto Rico only)	

SECTION D - SURVEYOR, ENGINEER, OR ARCHITECT CERTIFICATION	
This certification is to be signed and sealed by a land surveyor, engineer, or architect authorized by law to certify elevation information. I certify that the information on this Certificate represents my best efforts to interpret the data available. I understand that any false statement may be punishable by fine or imprisonment under 18 U.S. Code, Section 1001.	
<input type="checkbox"/> Check here if comments are provided on back of form.	
<u>MARK E. EVANS</u> Certifier's Name	<u>33985</u> License Number
<u>PRESIDENT</u> Title	<u>M.E. EVANS & ASSOCIATES</u> Company Name
<u>890 WEST ROAD 1 SOUTH CHINO VALLEY</u> Address	<u>ARIZONA 86323</u> State ZIP Code
<u>Mark</u> Signature	<u>928-636-0102</u> Telephone
<u>9/30/08</u> Date	

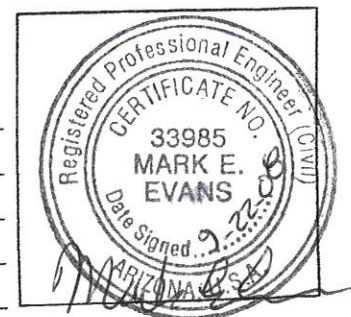

IMPORTANT: In these spaces, copy the corresponding information from Section 1

Building Street Address (including Apt., Unit, Suite, and/or Bldg. No.) or P.O. Route and Box No.

24605 NORTH FEATHER MOUNTAIN ROAD

City
PAULDEN

State
ARIZONA

ZIP Code
86334

For Insurance Company Use:

Policy Number

Company NAIC Number

SECTION D - SURVEYOR, ENGINEER, OR ARCHITECT CERTIFICATION (CONTINUED)

Copy both sides of this Elevation Certificate for (1) community official, (2) insurance agent/company, and (3) building owner.

Comments

THE REGULATOR ELEVATION FOR THIS PARCEL WAS DETERMINED BY RAYMOND FARIAS ON 4-19-96 (SEE ATTACHED) PARCEL 304-01-185A WAS SPLIT AFTER 1996 INTO 304-01-185B & C. THIS CERTIFICATION APPLIES TO 304-01-185B

Signature

Mark E. [Signature]

Date

9-22-08

Check here if attachments

SECTION E - BUILDING ELEVATION INFORMATION (SURVEY NOT REQUIRED) FOR ZONE AO AND ZONE A (WITHOUT BFE)

For Zones AO and A (without BFE), complete Items E1-E5. If the Certificate is intended to support a LOMA or LOMR-F request, complete Sections A, B, and C. For Items E1-E4, use natural grade, if available. Check the measurement used. In Puerto Rico only, enter meters.

- E1. Provide elevation information for the following and check the appropriate boxes to show whether the elevation is above or below the highest adjacent grade (HAG) and the lowest adjacent grade (LAG).
 - a) Top of bottom floor (including basement, crawl space, or enclosure) is _____ feet meters above or below the HAG.
 - b) Top of bottom floor (including basement, crawl space, or enclosure) is _____ feet meters above or below the LAG.
- E2. For Building Diagrams 6-8 with permanent flood openings provided in Section A Items 8 and/or 9 (see page 8 of instructions), the next higher floor (elevation C2.b in the diagrams) of the building is _____ feet meters above or below the HAG.
- E3. Attached garage (top of slab) is _____ feet meters above or below the HAG.
- E4. Top of platform of machinery and/or equipment servicing the building is _____ feet meters above or below the HAG.
- E5. Zone AO only: If no flood depth number is available, is the top of the bottom floor elevated in accordance with the community's floodplain management ordinance? Yes No Unknown. The local official must certify this information in Section G.

SECTION F - PROPERTY OWNER (OR OWNER'S REPRESENTATIVE) CERTIFICATION

The property owner or owner's authorized representative who completes Sections A, B, and E for Zone A (without a FEMA-issued or community-issued BFE) or Zone AO must sign here. The statements in Sections A, B, and E are correct to the best of my knowledge.

Property Owner's or Owner's Authorized Representative's Name

Address

City

State

ZIP Code

Signature

Date

Telephone

Comments

Check here if attachments

SECTION G - COMMUNITY INFORMATION (OPTIONAL)

The local official who is authorized by law or ordinance to administer the community's floodplain management ordinance can complete Sections A, B, C (or E), and G of this Elevation Certificate. Complete the applicable item(s) and sign below. Check the measurement used in Items G8, and G9.

- G1. The information in Section C was taken from other documentation that has been signed and sealed by a licensed surveyor, engineer, or architect who is authorized by law to certify elevation information. (Indicate the source and date of the elevation data in the Comments area below.)
- G2. A community official completed Section E for a building located in Zone A (without a FEMA-issued or community-issued BFE) or Zone AO.
- G3. The following information (Items G4.-G9.) is provided for community floodplain management purposes.

G4. Permit Number 597-56	G5. Date Permit Issued	G6. Date Certificate Of Compliance/Occupancy Issued
-----------------------------	------------------------	---

G7. This permit has been issued for: New Construction Substantial Improvement

G8. Elevation of as-built lowest floor (including basement) of the building: _____ feet meters (PR) Datum _____

G9. BFE or (in Zone AO) depth of flooding at the building site: _____ feet meters (PR) Datum _____

Local Official's Name

Title

Community Name

Telephone

Signature

Date

Comments

Check here if attachments

Replaces all previous editions

Building Photographs

See Instructions for Item A6.

Building Street Address (including Apt., Unit, Suite, and/or Bldg. No.) or P.O. Route and Box No.		For Insurance Company Use:	
24605 NORTH FEATHER MOUNTAIN ROAD		Policy Number	
City	State	ZIP Code	Company NAIC Number
PAULDEN	ARIZONA	86334	

If using the Elevation Certificate to obtain NFIP flood insurance, affix at least two building photographs below according to the instructions for Item A6. Identify all photographs with: date taken; "Front View" and "Rear View"; and, if required, "Right Side View" and "Left Side View." If submitting more photographs than will fit on this page, use the Continuation Page, following.

SEE ATTACHED



WEST & SOUTH SIDE OF HOUSE



EAST SIDE OF HOUSE




NORTH SIDE OF HOUSE



WEST SIDE OF HOUSE


ELEVATION EXHIBIT

APN 304-01-185B
NTS

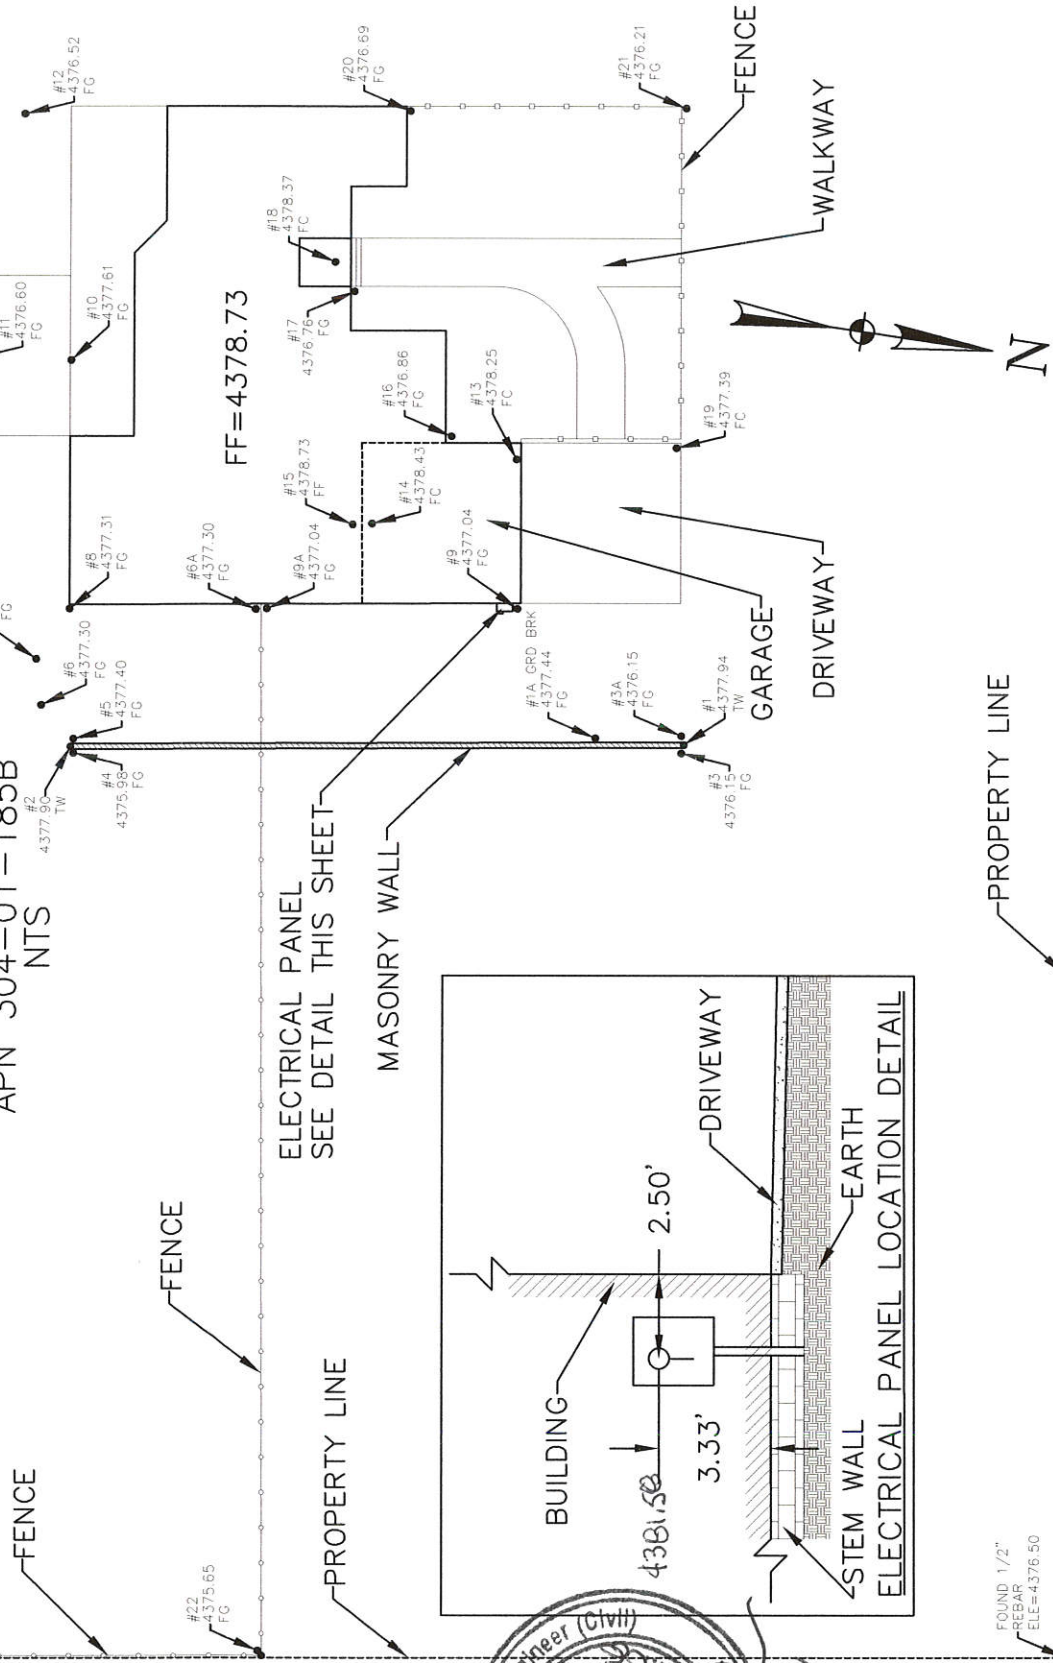


ELECTRICAL PANEL
SEE DETAIL THIS SHEET

MASONRY WALL

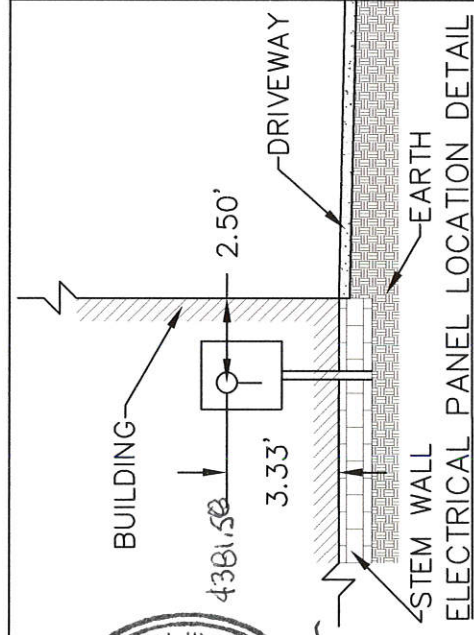

PROPERTY LINE


FOUND 1/2"
REBAR
ELE= 4376.50

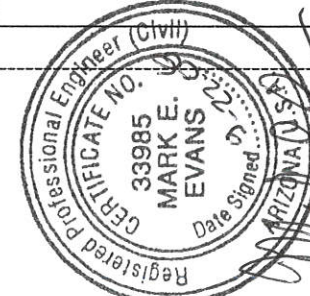

Expires 9/30/2011

SITE BENCHMARK:
1/2" REBAR AT
NORTHEAST SIDE OF
PROPERTY
ELEVATION=4376.50

NOTE:
100 YEAR REGULATORY ELEVATION=4378.60
FINISHED FLOOR OF BUILDING ELEVATION=4378.73

ELEVATION EXHIBIT		APN 304-01-185B	DESIGN	D.F.	REVISED
M.E. EVANS & ASSOCIATES 1596 SUSAN A. WILLIAMS WAY SUITE A CHINO VALLEY, ARIZONA 86323 (928) 636-0102 FAX 636-0733		M.E.E.		M.E.E.	
		DATE 9-22-08		JOB 08-009	
		SHEET NO.		1 OF 1	
		JOB 08-009		SHEET NO. 1 OF 1	

ELEVATION OF FLOODPLAIN PROPERTY

When Completed Return To: YAVAPAI COUNTY DEVELOPMENT SERVICES – FLOODPLAIN UNIT
Prescott Office: 500 S. Marina St., Prescott, AZ, 86303 PH (928) 771-3197, FAX (928) 771-3427
Cottonwood Office: 10 S. 6th St., Cottonwood, AZ 86326 PH (928) 639-8151, FAX (928) 639-8118

DATE 9/22/08 ASSESSOR'S PARCEL NUMBER 304-01-185B

SUBDIVISION NAME UNIT/PHASE AND LOT NUMBER N/A

SITUS ADDRESS 24605 NORTH FEATHER MOUNTAIN ROAD CHINO VALLEY ARIZONA 86334

BASE BENCHMARK: Number RM 50-2 Elevation 4378.215
MEVD 29


TEMPORARY PROPERTY BENCHMARK (TBM) ELEVATION 4376.50

TBM DESCRIPTION 1/2" REBAR @ NORTHEAST CORNER OF PARCEL

GROUND ELEVATIONS AT BUILDING SITE 4377.31, 4377.04, 4376.52
(Please provide a minimum of three (3) elevation points, representative of the site)

SKETCH OF LOT (include location of TBM and building site elevations)

SEE ATTACHED
EXHIBIT

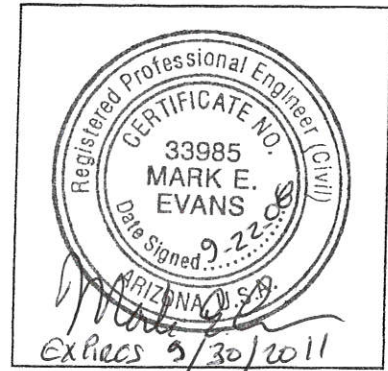

(seal)

Mark E. Evans
Signed

M.E. EVANS & ASSOCIATES
Company Name

890 WEST ROAD 1 SOUTH
Address
CHINO VALLEY ARIZONA 86323

Telephone 928-636-0102

Remarks PER RAYMOND FANAS 4-19-96

4377.60 + 1.00 = 4378.60
BASE FLOOD ELEVATION REGULATORY ELEVATION

FOR YAVAPAI COUNTY FLOOD CONTROL DISTRICT USE:

Date: 9-30-08

Base Flood Elevation 4378.7 + 1.0' = Regulatory Elevation 4379.7

* ELEVATION DETERMINATIONS ARE BASED ON BEST AVAILABLE DATA WHEN CALCULATED. ELEVATIONS ARE SUBJECT TO CHANGE WHEN NEW OR REVISED FLOOD STUDIES OR DATA IS SUPPLIED TO THE DISTRICT.