

FEDERAL EMERGENCY MANAGEMENT AGENCY  
NATIONAL FLOOD INSURANCE PROGRAM

O.M.B. No. 3067-0077  
Expires December 31, 2005

**ELEVATION CERTIFICATE**

Important: Read the instructions on pages 1 - 7.

**SECTION A - PROPERTY OWNER INFORMATION**

BUILDING OWNER'S NAME <b>NANCY HOLLIS</b>	For Insurance Company Use: Policy Number
BUILDING STREET ADDRESS (Including Apt., Unit, Suite, and/or Bldg. No.) OR P.O. ROUTE AND BOX NO. <b>2425 BAYBERRY</b>	Company NAIC Number
CITY	STATE ZIP CODE

PROPERTY DESCRIPTION (Lot and Block Numbers, Tax Parcel Number, Legal Description, etc.)

**APN 304-02-025, WINEGLASS ACRES AMENDED**

BUILDING USE (e.g., Residential, Non-residential, Addition, Accessory, etc. Use Comments area if necessary.)

**RESIDENTIAL**

LATITUDE/LONGITUDE (OPTIONAL) HORIZONTAL DATUM: SOURCE:  GPS (Type):  
(##° - ##' - ##.###" or ###.#####")  NAD 1927  NAD 1983  USGS Quad Map  Other:

**SECTION B - FLOOD INSURANCE RATE MAP (FIRM) INFORMATION**

B1. NFIP COMMUNITY NAME & COMMUNITY NUMBER <b>Yavapai County - 040093</b>		B2. COUNTY NAME <b>Yavapai</b>		B3. STATE <b>AZ</b>	
B4. MAP AND PANEL NUMBER <b>04025C0970</b>	B5. SUFFIX <b>F</b>	B6. FIRM INDEX DATE <b>6-6-01</b>	B7. FIRM PANEL EFFECTIVE/REVISED DATE <b>6-6-01</b>	B8. FLOOD ZONES <b>AE</b>	B9. BASE FLOOD ELEVATION(S) <b>4383.1</b>

B10. Indicate the source of the Base Flood Elevation (BFE) data or base flood depth entered in B9.

FIS Profile  FIRM  Community Determined  Other (Describe):

B11. Indicate the elevation datum used for the BFE in B9:  NGVD 1929  NAVD 1988  Other (Describe):

B12. Is the building located in a Coastal Barrier Resources System (CBRS) area or Otherwise Protected Area (OPA)?  Yes  No  
Designation Date:

**SECTION C - BUILDING ELEVATION INFORMATION (SURVEY REQUIRED)**

C1. Building elevations are based on:  Construction Drawings\*  Building Under Construction\*  Finished Construction  
\*A new Elevation Certificate will be required when construction of the building is complete.


C2. Building Diagram Number **8** (Select the building diagram most similar to the building for which this certificate is being completed - see pages 6 and 7. If no diagram accurately represents the building, provide a sketch or photograph.)

C3. Elevations - Zones A1-A30, AE, AH, A (with BFE), VE, V1-V30, V (with BFE), AR, AR/A, AR/AE, AR/A1-A30, AR/AH, AR/AO  
Complete Items C3.a-i below according to the building diagram specified in Item C2. State the datum used. If the datum is different from the datum used for the BFE in Section B, convert the datum to that used for the BFE. Show field measurements and datum conversion calculation. Use the space provided or the Comments area of Section D or Section G, as appropriate, to document the datum conversion.  
Datum \_\_\_\_\_ Conversion/Comments \_\_\_\_\_

Elevation reference mark used **RM 50-2** Does the elevation reference mark used appear on the FIRM?  Yes  No

- a) Top of bottom floor (including basement or enclosure) **4384.00** ft.(m)
- b) Top of next higher floor **4385.25** ft.(m)
- c) Bottom of lowest horizontal structural member (zones only) **N/A** ft.(m)
- d) Attached garage (top of slab) **N/A** ft.(m)
- e) Lowest elevation of machinery and/or equipment servicing the building (Describe in a Comments area.) \_\_\_\_\_ ft.(m)
- f) Lowest adjacent (finished) grade (LAG) **4383.97** ft.(m)
- g) Highest adjacent (finished) grade (HAG) **4384.23** ft.(m)
- h) No. of permanent openings (flood vents) within 1 ft. above adjacent grade **17**
- i) Total area of all permanent openings (flood vents) in C3.h **2448** sq. in. (sq. cm)

License Number, Embossed Seal, Signature, and Date

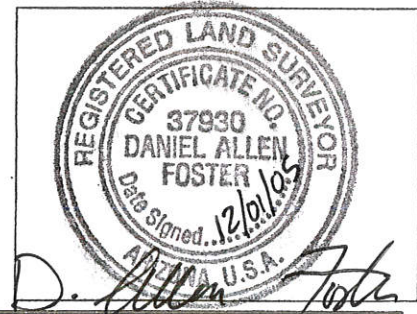

**SECTION D - SURVEYOR, ENGINEER, OR ARCHITECT CERTIFICATION**

This certification is to be signed and sealed by a land surveyor, engineer, or architect authorized by law to certify elevation information. I certify that the information in Sections A, B, and C on this certificate represents my best efforts to interpret the data available. I understand that any false statement may be punishable by fine or imprisonment under 18 U.S. Code, Section 1001.

CERTIFIER'S NAME <b>D. ALLEN FOSTER</b>	LICENSE NUMBER <b>RLS # 37930</b>
TITLE <b>OWNER</b>	COMPANY NAME <b>FOSTCO SURVEYING</b>
ADDRESS <b>P.O. Box 4363</b>	CITY <b>CHINO VALLEY</b>
SIGNATURE <b>D. Allen Foster</b>	DATE <b>12/01/05</b>
	STATE <b>AZ</b>
	ZIP CODE <b>86323</b>
	TELEPHONE <b>928-636-9184</b>

<b>IMPORTANT: In these spaces, copy the corresponding information from Section A.</b>			For Insurance Company Use:	
BUILDING STREET ADDRESS (Including Apt., Unit, Suite, and/or Bldg. No.) OR P.O. ROUTE AND BOX NO. <b>2425 BAYBERRY</b>			Policy Number	
CITY	STATE	ZIP CODE	Company NAIC Number	

**SECTION D - SURVEYOR, ENGINEER, OR ARCHITECT CERTIFICATION (CONTINUED)**

Copy both sides of this Elevation Certificate for (1) community official, (2) insurance agent/company, and (3) building owner.

COMMENTS

**MANUFACTURED HOME IS ON A BLOCK STEM WALL. ELEVATION OF C3C IS TO THE LOWEST STRUCTURAL FRAME, AND HAS AN ELEVATION OF 4384.75. MINIMUM ELEVATION AS DETERMINED BY YAVAPAI COUNTY WAS 4384.10.**

Check here if attachments

**SECTION E - BUILDING ELEVATION INFORMATION (SURVEY NOT REQUIRED) FOR ZONE AO AND ZONE A (WITHOUT BFE)**

For Zone AO and Zone A (without BFE), complete Items E1. through E4. If the Elevation Certificate is intended for use as supporting information for a LOMA or LOMR-F, Section C must be completed.

- E1. Building Diagram Number \_\_\_\_\_ (Select the building diagram most similar to the building for which this certificate is being completed – see pages 6 and 7. If no diagram accurately represents the building, provide a sketch or photograph.)
- E2. The top of the bottom floor (including basement or enclosure) of the building is \_\_\_\_\_ ft.(m) \_\_\_\_\_ in.(cm) \_\_\_\_\_ above or \_\_\_\_\_ below (check one) the highest adjacent grade. (Use natural grade, if available.)
- E3. For Building Diagrams 6-8 with openings (see page 7), the next higher floor or elevated floor (elevation b) of the building is \_\_\_\_\_ ft.(m) \_\_\_\_\_ in.(cm) above the highest adjacent grade. Complete Items C3.h and C3.i on front of form.
- E4. For Zone AO only: If no flood depth number is available, is the top of the bottom floor elevated in accordance with the community's floodplain management ordinance?  Yes  No  Unknown. The local official must certify this information in Section G.

**SECTION F - PROPERTY OWNER (OR OWNER'S REPRESENTATIVE) CERTIFICATION**

The property owner or owner's authorized representative who completes Sections A, B, C (Items C3.h and C3.i only), and E for Zone A (without a FEMA-issued or community-issued BFE) or Zone AO must sign here. *The statements in Sections A, B, C, and E are correct to the best of my knowledge.*

PROPERTY OWNER'S OR OWNER'S AUTHORIZED REPRESENTATIVE'S NAME

ADDRESS CITY STATE ZIP CODE

SIGNATURE DATE TELEPHONE

COMMENTS

Check here if attachments

**SECTION G - COMMUNITY INFORMATION (OPTIONAL)**

The local official who is authorized by law or ordinance to administer the community's floodplain management ordinance can complete Sections A, B, C (or E), and G of this Elevation Certificate. Complete the applicable item(s) and sign below.

- G1.  The information in Section C was taken from other documentation that has been signed and embossed by a licensed surveyor, engineer, or architect who is authorized by state or local law to certify elevation information. (Indicate the source and date of the elevation data in the Comments area below.)
- G2.  A community official completed Section E for a building located in Zone A (without a FEMA-issued or community-issued BFE) or Zone AO.
- G3.  The following information (Items G4-G9) is provided for community floodplain management purposes.

G4. PERMIT NUMBER	G5. DATE PERMIT ISSUED	G6. DATE CERTIFICATE OF COMPLIANCE/OCCUPANCY ISSUED
-------------------	------------------------	---

G7. This permit has been issued for:  New Construction  Substantial Improvement

G8. Elevation of as-built lowest floor (including basement) of the building is: \_\_\_\_\_ ft.(m) Datum: \_\_\_\_\_

G9. BFE or (in Zone AO) depth of flooding at the building site is: \_\_\_\_\_ ft.(m) Datum: \_\_\_\_\_

LOCAL OFFICIAL'S NAME TITLE

COMMUNITY NAME TELEPHONE

SIGNATURE DATE

COMMENTS

Check here if attachments

# ELEVATION OF FLOODPLAIN PROPERTY


When Completed Return To: Yavapai County Development Services – Floodplain Unit  
500 S. Marina St., Prescott, AZ, 86303 (928) 771-3197 FAX 771-3427

DATE 9/23/05  
ASSESSOR'S PARCEL NUMBER 304-02-025  
SUBDIVISION NAME UNIT/PHASE AND LOT NUMBER WINEGLASS ACRES AMENDED  
OWNER RUBY EARNHART (NANCY HOLLIS)  
SITUS ADDRESS BAYBERRY DR/SUNHAWK RD  
BASE BENCHMARK: Number RM50-2 Elevation 4378.21

PROPERTY BENCHMARK ① 4381.94' ② 4382.42'  
DESCRIPTION OF PROPERTY BENCHMARK ① 1/2" REBAR ± 0.15' ABOVE GROUND  
② 1/2" FOSTER AT THE NW R/W CORNER  
GROUND ELEVATIONS AT BUILDING SITE ③ 4381.50', ④ 4381.41', ⑤ 4381.70'  
(Please provide a minimum of three (3) elevations points, representative of the site)

Sketch of Lot  
(include location of property benchmark and building site elevations)

Remarks PROPERTY IS  
RELATIVELY FLAT THROUGHOUT  
PARCEL.

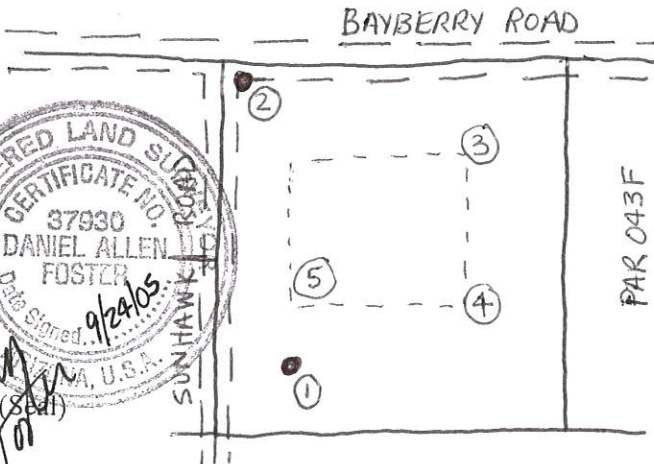

D. Allen Foster  
Signed  
FOSTCO SURVEYING INC  
Company Name  
P.O. BOX 4363  
Address  
CHINO VALLEY, AZ 86323  
Telephone 928-636-9184

FOR YAVAPAI COUNTY FLOOD CONTROL DISTRICT USE:

Date: \_\_\_\_\_

Base Flood Elevation 4383.1 + 1.0' = Regulatory Elevation 4384.1

\* ELEVATION DETERMINATIONS ARE BASED ON BEST AVAILABLE DATA WHEN CALCULATED. ELEVATIONS ARE SUBJECT TO CHANGE WHEN NEW OR REVISED FLOOD STUDIES OR DATA IS SUPPLIED TO THE DISTRICT.