

ELEVATION CERTIFICATE

OMB No. 1660-0008
Expires February 28, 2009

Important: Read the instructions on pages 1-8.

SECTION A - PROPERTY INFORMATION

A1. Building Owner's Name <u>Patricia Goddard</u>	For Insurance Company Use:
	Policy Number
A2. Building Street Address (including Apt., Unit, Suite, and/or Bldg. No.) or P.O. Route and Box No. <u>24350 N. Feather Mountain Road</u>	Company NAIC Number

City Paulden State AZ ZIP Code 86334

A3. Property Description (Lot and Block Numbers, Tax Parcel Number, Legal Description, etc.)
Tax Parcel Number 304-02-040E

A4. Building Use (e.g., Residential, Non-Residential, Addition, Accessory, etc.) Residential M.H.

A5. Latitude/Longitude: Lat. 34°54'05.3" Long. -112°30'20.7"

Horizontal Datum: NAD 1927 NAD 1983

A6. Attach at least 2 photographs of the building if the Certificate is being used to obtain flood insurance.

A7. Building Diagram Number 8

A8. For a building with a crawl space or enclosure(s), provide

- a) Square footage of crawl space or enclosure(s) 1620 sq ft
b) No. of permanent flood openings in the crawl space or enclosure(s) walls within 1.0 foot above adjacent grade n/a
c) Total net area of flood openings in A8.b n/a sq in

A9. For a building with an attached garage, provide:

- a) Square footage of attached garage n/a sq ft
b) No. of permanent flood openings in the attached garage walls within 1.0 foot above adjacent grade n/a
c) Total net area of flood openings in A9.b n/a sq in

SECTION B - FLOOD INSURANCE RATE MAP (FIRM) INFORMATION

B1. NFIP Community Name & Community Number <u>Yavapai County 040093</u>		B2. County Name <u>Yavapai</u>		B3. State <u>Arizona</u>	
B4. Map/Panel Number <u>04025C0970</u>	B5. Suffix <u>F</u>	B6. FIRM Index Date <u>6/6/01</u>	B7. FIRM Panel Effective/Revised Date <u>6/6/01</u>	B8. Flood Zone(s) <u>AE</u>	B9. Base Flood Elevation(s) (Zone AO, use base flood depth) <u>4378.0'</u>

B10. Indicate the source of the Base Flood Elevation (BFE) data or base flood depth entered in Item B9.

- FIS Profile FIRM Community Determined Other (Describe) _____

B11. Indicate elevation datum used for BFE in Item B9: NGVD 1929 NAVD 1988 Other (Describe) _____

B12. Is the building located in a Coastal Barrier Resources System (CBRS) area or Otherwise Protected Area (OPA)? Yes No
Designation Date _____ CBRS OPA

SECTION C - BUILDING ELEVATION INFORMATION (SURVEY REQUIRED)

C1. Building elevations are based on: Construction Drawings* Building Under Construction* Finished Construction

*A new Elevation Certificate will be required when construction of the building is complete.

C2. Elevations - Zones A1-A30, AE, AH, A (with BFE), VE, V1-V30, V (with BFE), AR, AR/A, AR/AE, AR/A1-A30, AR/AH, AR/AO. Complete Items C2.a-g below according to the building diagram specified in Item A7.

Benchmark Utilized RM 13 Vertical Datum NGVD 1929 4378.21'

Conversion/Comments _____

Check the measurement used.

- a) Top of bottom floor (including basement, crawl space, or enclosure floor) 4377.1 feet meters (Puerto Rico only)
b) Top of the next higher floor 4380.8 feet meters (Puerto Rico only)
c) Bottom of the lowest horizontal structural member (V Zones only) n/a feet meters (Puerto Rico only)
d) Attached garage (top of slab) n/a feet meters (Puerto Rico only)
e) Lowest elevation of machinery or equipment servicing the building (Describe type of equipment in Comments) 4379.5 feet meters (Puerto Rico only)
f) Lowest adjacent (finished) grade (LAG) 4377.1 feet meters (Puerto Rico only)
g) Highest adjacent (finished) grade (HAG) 4377.8 feet meters (Puerto Rico only)

SECTION D - SURVEYOR, ENGINEER, OR ARCHITECT CERTIFICATION

This certification is to be signed and sealed by a land surveyor, engineer, or architect authorized by law to certify elevation information. I certify that the information on this Certificate represents my best efforts to interpret the data available. I understand that any false statement may be punishable by fine or imprisonment under 18 U.S. Code, Section 1001.

Check here if comments are provided on back of form.

Certifier's Name <u>Lauri Hopps</u>	License Number <u>33876</u>
Title <u>Registered Land Surveyor</u>	Company Name <u>Advanced Surveys, Inc.</u>
Address <u>P.O. Box 26031</u>	City <u>Prescott Valley</u> State <u>AZ</u> ZIP Code <u>86312</u>
Signature <u>Lauri Hopps</u> Date <u>6/6/07</u>	Telephone <u>928-772-4716</u>



ELEVATION OF FLOODPLAIN PROPERTY

When Completed Return To: YAVAPAI COUNTY DEVELOPMENT SERVICES – FLOODPLAIN UNIT

500 S. Marina St., Prescott, AZ, 86303 (928) 771-3197 FAX (928) 771-3427 Office: Prescott _____
10 S. 6th St., Cottonwood, AZ 86326 (928) 639-8151 FAX (928) 639-8118 Cottonwood _____

DATE 9-24-04

ASSESSOR'S PARCEL NUMBER 304-02-040E

SUBDIVISION NAME UNIT/PHASE AND LOT NUMBER _____

OWNER _____

SITUS ADDRESS _____

BASE BENCHMARK: Number Rm 13 Elevation 4378.21'

PROPERTY BENCHMARK 4377.09'

DESCRIPTION OF PROPERTY BENCHMARK NE Corner 1/2" Rebar. LS 23383

GROUND ELEVATIONS AT BUILDING SITE 4376.88' 4376.91' 4376.88'
(Please provide a minimum of three (3) elevation points, representative of the site)

Sketch of Lot _____ Remarks _____
(include location of property benchmark and building site elevations)

see attached sketch.



Lauri Hopps
Signed _____
Company Name Advanced Surveys Inc
PO Box 26031
Address Prescott Valley AZ 86312
Telephone 928 772-4716

FOR YAVAPAI COUNTY FLOOD CONTROL DISTRICT USE: Date: 10/6/04


Base Flood Elevation 4378.0 + 1.0' = Regulatory Elevation 4379.0

* ELEVATION DETERMINATIONS ARE BASED ON BEST AVAILABLE DATA WHEN CALCULATED. ELEVATIONS ARE SUBJECT TO CHANGE WHEN NEW OR REVISED FLOOD STUDIES OR DATA IS SUPPLIED TO THE DISTRICT.

304-02-040E

4377.59

4377.09

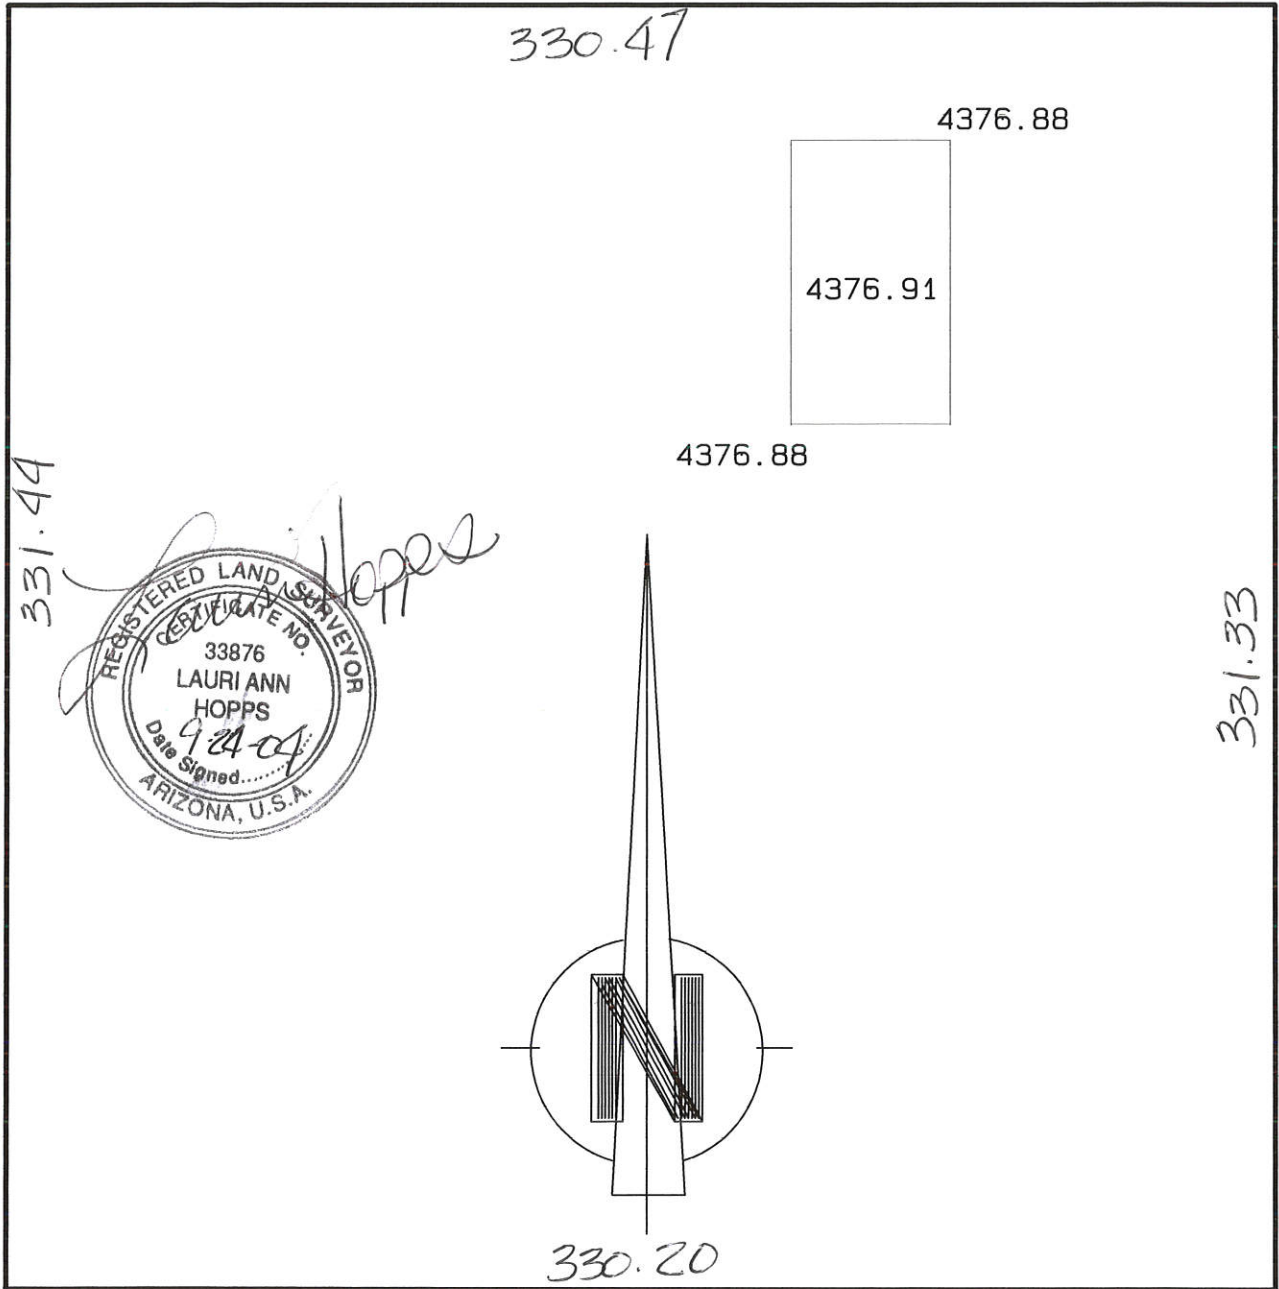

Feather Mt. Rd.

