

FEDERAL EMERGENCY MANAGEMENT AGENCY
NATIONAL FLOOD INSURANCE PROGRAM

O.M.B. No. 3067-0077
Expires December 31, 2005

ELEVATION CERTIFICATE

Important: Read the instructions on pages 1 - 7.

SECTION A - PROPERTY OWNER INFORMATION

BUILDING OWNER'S NAME Daniel and Janice Weisenstein		For Insurance Company Use: Policy Number
BUILDING STREET ADDRESS (Including Apt., Unit, Suite, and/or Bldg. No.) OR P.O. ROUTE AND BOX NO. 24252 N. Riviera Avenue		Company NAIC Number
CITY Pauiden	STATE AZ	ZIP CODE 86334

PROPERTY DESCRIPTION (Lot and Block Numbers, Tax Parcel Number, Legal Description, etc.)

304-06-071

BUILDING USE (e.g., Residential, Non-residential, Addition, Accessory, etc. Use a Comments area, if necessary.)
Manufactured Home

LATITUDE/LONGITUDE (OPTIONAL)
(##° - ##' - ###" or ###.####")

HORIZONTAL DATUM:
☐ NAD 1927 ☒ NAD 1983

SOURCE: ☐ GPS (Type): ☐ USGS Quad Map ☐ Other:

SECTION B - FLOOD INSURANCE RATE MAP (FIRM) INFORMATION

B1. NFIP COMMUNITY NAME & COMMUNITY NUMBER YAVAPAI COUNTY - 040093	B2. COUNTY NAME YAVAPAI COUNTY	B3. STATE ARIZONA
---	-----------------------------------	----------------------

B4. MAP AND PANEL NUMBER 04025C0990	B5. SUFFIX F	B6. FIRM INDEX DATE 6/6/01	B7. FIRM PANEL EFFECTIVE/REVISED DATE 6/6/01	B8. FLOOD ZONE(S) AE	B9. BASE FLOOD ELEVATION(S) (Zone AO, use depth of flooding) 4394.6
--	-----------------	-------------------------------	---	-------------------------	---

B10. Indicate the source of the Base Flood Elevation (BFE) data or base flood depth entered in B9.

☒ FIS Profile ☒ FIRM ☐ Community Determined ☐ Other (Describe):

B11. Indicate the elevation datum used for the BFE in B9: ☒ NGVD 1929 ☐ NAVD 1988 ☐ Other (Describe):

B12. Is the building located in a Coastal Barrier Resources System (CBRS) area or Otherwise Protected Area (OPA)? ☐ Yes ☒ No Designation Date

SECTION C - BUILDING ELEVATION INFORMATION (SURVEY REQUIRED)

C1. Building elevations are based on: ☐ Construction Drawings* ☐ Building Under Construction* ☒ Finished Construction

*A new Elevation Certificate will be required when construction of the building is complete.

C2. Building Diagram Number (Select the building diagram most similar to the building for which this certificate is being completed - see pages 6 and 7. If no diagram accurately represents the building, provide a sketch or photograph.)

C3. Elevations - Zones A1-A30, AE, AH, A (with BFE), VE, V1-V30, V (with BFE), AR, AR/A, AR/AE, AR/A1-A30, AR/AH, AR/AO


Complete Items C3-a-i below according to the building diagram specified in Item C2. State the datum used. If the datum is different from the datum used for the BFE in Section B, convert the datum to that used for the BFE. Show field measurements and datum conversion calculation. Use the space provided or the Comments area of Section D or Section G, as appropriate, to document the datum conversion.

Datum M 22 Conversion/Comments

Elevation reference mark used 22 Does the elevation reference mark used appear on the FIRM? ☒ Yes ☐ No

- ☐ a) Top of bottom floor (including basement or enclosure) 4396.9 ft.(m)
- ☐ b) Top of next higher floor NA ft.(m)
- ☐ c) Bottom of lowest horizontal structural member (V zones only) NA ft.(m)
- ☐ d) Attached garage (top of slab) NA ft.(m)
- ☐ e) Lowest elevation of machinery and/or equipment servicing the building (Describe in a Comments area) 4396.5 ft.(m)
- ☐ f) Lowest adjacent (finished) grade (LAG) 4393.0 ft.(m)
- ☐ g) Highest adjacent (finished) grade (HAG) 4393.5 ft.(m)
- ☐ h) No. of permanent openings (flood vents) within 1 ft. above adjacent grade 4
- ☐ i) Total area of all permanent openings (flood vents) in C3.h 3672 sq. in. (sq. cm)

License Number, Embossed Seal, Signature, and Date

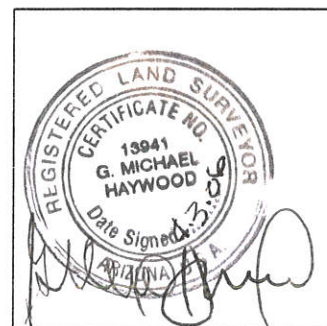

SECTION D - SURVEYOR, ENGINEER, OR ARCHITECT CERTIFICATION

This certification is to be signed and sealed by a land surveyor, engineer, or architect authorized by law to certify elevation information.

I certify that the information in Sections A, B, and C on this certificate represents my best efforts to interpret the data available.

I understand that any false statement may be punishable by fine or imprisonment under 18 U.S. Code, Section 1001.

CERTIFIER'S NAME <u>G. Michael Haywood</u>	LICENSE NUMBER <u>AZ 13941</u>
TITLE <u>PRESIDENT</u>	COMPANY NAME <u>M. HAYWOOD ASSOC. INC.</u>
ADDRESS <u>P.O. Box 1001</u>	CITY <u>PRESCOTT</u>
SIGNATURE <u>[Signature]</u>	DATE <u>4-3-06</u>
	STATE <u>AZ</u>
	ZIP CODE <u>86302</u>
	TELEPHONE

IMPORTANT: In these spaces, copy the corresponding information from Section A.		For Insurance Company Use:
BUILDING STREET ADDRESS (Including Apt., Unit, Suite, and Flg. No.) OR P.O. ROUTE AND BOX NO. 24252 N. RIVIERA AVE.		Policy Number
CITY PAULDEN	STATE AZ	ZIP CODE 86334
		Company NAIC Number

SECTION D - SURVEYOR, ENGINEER, OR ARCHITECT CERTIFICATION (CONTINUED)

Copy both sides of this Elevation Certificate for (1) community official, (2) insurance agent/company, and (3) building owner.

COMMENTS

MANUFACTURED HOME - ELEVATION OF LOWEST STRUCTURAL MEMBER = 4395'
HOME IS SET ON JACKS WITH MASONITE SKIRTING WITH 4 SCREENED OPENINGS.

☐ Check here if attachments

SECTION E - BUILDING ELEVATION INFORMATION (SURVEY NOT REQUIRED) FOR ZONE AO AND ZONE A (WITHOUT BFE)

For Zone AO and Zone A (without BFE), complete Items E1 through E4. If the Elevation Certificate is intended for use as supporting information for a LOMA or LOMR-F, Section C must be completed.

- E1. Building Diagram Number (Select the building diagram most similar to the building for which this certificate is being completed - see pages 6 and 7. If no diagram accurately represents the building, provide a sketch or photograph.)
- E2. The top of the bottom floor (including basement or enclosure) of the building is ___ ft.(m) ___ in.(cm) ☐ above or ☐ below (check one) the highest adjacent grade. (Use natural grade, if available).
- E3. For Building Diagrams 6-8 with openings (see page 7), the next higher floor or elevated floor (elevation b) of the building is ___ ft.(m) ___ in.(cm) above the highest adjacent grade. Complete items C3.h and C3.i on front of form.
- E4. The top of the platform of machinery and/or equipment servicing the building is ___ ft.(m) ___ in.(cm) ☐ above or ☐ below (check one) the highest adjacent grade. (Use natural grade, if available).
- E5. For Zone AO only: If no flood depth number is available, is the top of the bottom floor elevated in accordance with the community's floodplain management ordinance?
☐ Yes ☐ No ☐ Unknown. The local official must certify this information in Section G.

SECTION F - PROPERTY OWNER (OR OWNER'S REPRESENTATIVE) CERTIFICATION

The property owner or owner's authorized representative who completes Sections A, B, C (Items C3.h and C3.i only), and E for Zone A (without a FEMA-issued or community-issued BFE) or Zone AO must sign here. *The statements in Sections A, B, C, and E are correct to the best of my knowledge.*

PROPERTY OWNER'S OR OWNER'S AUTHORIZED REPRESENTATIVE'S NAME

ADDRESS CITY STATE ZIP CODE

SIGNATURE DATE TELEPHONE

COMMENTS

☐ Check here if attachments

SECTION G - COMMUNITY INFORMATION (OPTIONAL)

The local official who is authorized by law or ordinance to administer the community's floodplain management ordinance can complete Sections A, B, C (or E), and G of this Elevation Certificate. Complete the applicable item(s) and sign below.

- G1. ☐ The information in Section C was taken from other documentation that has been signed and embossed by a licensed surveyor, engineer, or architect who is authorized by state or local law to certify elevation information. (Indicate the source and date of the elevation data in the Comments area below.)
- G2. ☐ A community official completed Section E for a building located in Zone A (without a FEMA-issued or community-issued BFE) or Zone AO.
- G3. ☐ The following information (Items G4-G9) is provided for community floodplain management purposes.

G4. PERMIT NUMBER	G5. DATE PERMIT ISSUED	G6. DATE CERTIFICATE OF COMPLIANCE/OCCUPANCY ISSUED
-------------------	------------------------	---

G7. This permit has been issued for: ☐ New Construction ☐ Substantial Improvement

G8. Elevation of as-built lowest floor (including basement) of the building is: ___ ft.(m) Datum: ___

G9. BFE or (in Zone AO) depth of flooding at the building site is: ___ ft.(m) Datum: ___

LOCAL OFFICIAL'S NAME TITLE

COMMUNITY NAME TELEPHONE

SIGNATURE DATE

COMMENTS

☐ Check here if attachments

ELEVATION OF FLOODPLAIN PROPERTY

When Completed Return To: **YAVAPAI COUNTY DEVELOPMENT SERVICES – FLOODPLAIN UNIT**

500 S. Marina St., Prescott, AZ, 86303 (928) 771-3197 FAX (928) 771-3427 Office: Prescott X
10 S. 6th St., Cottonwood, AZ 86326 (928) 639-8151 FAX (928) 639-8118 Cottonwood _____

DATE OCTOBER 24, 2005

ASSESSOR'S PARCEL NUMBER 304.06-071

SUBDIVISION NAME UNIT/PHASE AND LOT NUMBER HOLIDAY LAKE ESTATES • LOT 1229

OWNER DANIEL & JANICE WEISENSTEIN

SITUS ADDRESS

BASE BENCHMARK: Number RM22(1411) Elevation 4393.79

PROPERTY BENCHMARK 4393.51

DESCRIPTION OF PROPERTY BENCHMARK TOP OF 1/2" REBAR AT S.W. CORNER

GROUND ELEVATIONS AT BUILDING SITE 4392.9


(Please provide a minimum of three (3) elevation points, representative of the site)

Sketch of Lot
(include location of property benchmark and building site elevations)

Remarks ELGVSTED BERM

Along W. 1/5 of

LOT.

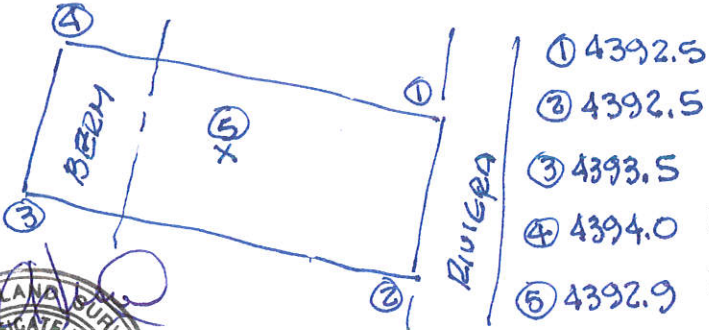

Signed

MILYWOOD ASSOC, INC.

Company Name

P.O. Box 1001

Address

Prescott, AZ 86302

Telephone 778.5101

FOR YAVAPAI COUNTY FLOOD CONTROL DISTRICT USE:

Date:

Base Flood Elevation

4394.55

+ 1.0' = Regulatory Elevation

4395.55

* ELEVATION DETERMINATIONS ARE BASED ON BEST AVAILABLE DATA WHEN CALCULATED. ELEVATIONS ARE SUBJECT TO CHANGE WHEN NEW OR REVISED FLOOD STUDIES OR DATA IS SUPPLIED TO THE DISTRICT.