

FEDERAL EMERGENCY MANAGEMENT AGENCY
NATIONAL FLOOD INSURANCE PROGRAM

O.M.B. No. 3067-0077
Expires July 31, 2002

ELEVATION CERTIFICATE

Important: Read the instructions on pages 1 - 7.

SECTION A - PROPERTY OWNER INFORMATION			For Insurance Company Use:
BUILDING OWNER'S NAME WHITLOCK - FEDERAL NATIONAL MORTGAGE			Policy Number
BUILDING STREET ADDRESS (Including Apt., Unit, Suite, and/or Bldg. No.) OR P.O. ROUTE AND BOX NO. 2425 RIVIERA AVENUE			Company NAIC Number
CITY PAULDEN	STATE AZ	ZIP CODE 86343	
PROPERTY DESCRIPTION (Lot and Block Numbers, Tax Parcel Number, Legal Description, etc.) LOT 1283 HOLIDAY LAKE ESTATES APN 304-06-124 D			
BUILDING USE (e.g., Residential, Non-residential, Addition, Accessory, etc. Use a Comments area, if necessary.) RESIDENTIAL			
LATITUDE/LONGITUDE (OPTIONAL) (##° - ##' - ###" or ###.####")		HORIZONTAL DATUM: <input checked="" type="checkbox"/> NAD 1927 <input type="checkbox"/> NAD 1983	SOURCE: <input type="checkbox"/> GPS (Type): _____ <input checked="" type="checkbox"/> USGS Quad Map <input type="checkbox"/> Other: _____

SECTION B - FLOOD INSURANCE RATE MAP (FIRM) INFORMATION

B1. NFIP COMMUNITY NAME & COMMUNITY NUMBER YAVAPAI COUNTY 040093		B2. COUNTY NAME YAVAPAI COUNTY		B3. STATE AZ	
B4. MAP AND PANEL NUMBER 040093 605	B5. SUFFIX C	B6. FIRM INDEX DATE 3-9-99	B7. FIRM PANEL EFFECTIVE/REVISED DATE 9-20-96	B8. FLOOD ZONE(S) AE	B9. BASE FLOOD ELEVATION(S) (Zone AO, use depth of flooding) 4395.4

B10. Indicate the source of the Base Flood Elevation (BFE) data or base flood depth entered in B9.
☐ FIS Profile ☒ FIRM ☐ Community Determined ☒ Other (Describe): SEE COMMENTS

B11. Indicate the elevation datum used for the BFE in B9: ☒ NGVD 1929 ☐ NAVD 1988 ☐ Other (Describe): _____

B12. Is the building located in a Coastal Barrier Resources System (CBRS) area or Otherwise Protected Area (OPA)? ☐ Yes ☒ No Designation Date _____

SECTION C - BUILDING ELEVATION INFORMATION (SURVEY REQUIRED)

C1. Building elevations are based on: ☐ Construction Drawings* ☐ Building Under Construction* ☒ Finished Construction
 *A new Elevation Certificate will be required when construction of the building is complete.

C2. Building Diagram Number 8 (Select the building diagram most similar to the building for which this certificate is being completed - see pages 6 and 7. If no diagram accurately represents the building, provide a sketch or photograph.)


C3. Elevations - Zones A1-A30, AE, AH, A (with BFE), VE, V1-V30, V (with BFE), AR, AR/A, AR/AE, AR/A1-A30, AR/AH, AR/AO
 Complete Items C3.-a-i below according to the building diagram specified in Item C2. State the datum used. If the datum is different from the datum used for the BFE in Section B, convert the datum to that used for the BFE. Show field measurements and datum conversion calculation. Use the space provided or the Comments area of Section D or Section G, as appropriate, to document the datum conversion.

Datum 4400.46 Conversion/Comments _____

Elevation reference mark used RM1415 Does the elevation reference mark used appear on the FIRM? ☒ Yes ☐ No

a) Top of bottom floor (including basement or enclosure)	<u>4394.80</u> ft.(m)
b) Top of next higher floor	<u>4395.8</u> ft.(m)
c) Bottom of lowest horizontal structural member (V zones only)	_____ ft.(m)
d) Attached garage (top of slab)	_____ ft.(m)
e) Lowest elevation of machinery and/or equipment servicing the building (Describe in a Comments area)	_____ ft.(m)
f) Lowest adjacent (finished) grade (LAG)	<u>4393.0</u> ft.(m)
g) Highest adjacent (finished) grade (HAG)	<u>4393.10</u> ft.(m)
h) No. of permanent openings (flood vents) within 1 ft. above adjacent grade <u>3</u>	
i) Total area of all permanent openings (flood vents) in C3.h <u>270</u> sq. in. (sq. cm)	

License Number, Embossed Seal, Signature, and Date

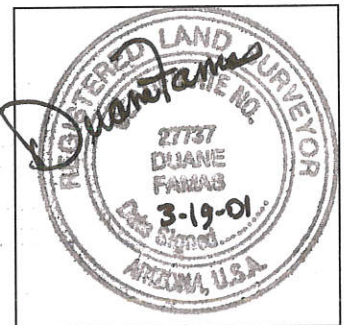

SECTION D - SURVEYOR, ENGINEER, OR ARCHITECT CERTIFICATION

This certification is to be signed and sealed by a land surveyor, engineer, or architect authorized by law to certify elevation information.
 I certify that the information in Sections A, B, and C on this certificate represents my best efforts to interpret the data available.
 I understand that any false statement may be punishable by fine or imprisonment under 18 U.S. Code, Section 1001.

CERTIFIER'S NAME DUANE FAMAS	LICENSE NUMBER AZ RLS 27737
TITLE LAND SURVEYOR	COMPANY NAME FAMAS LAND SURVEYORS, INC.
ADDRESS PO Box 4357	CITY PRESCOTT
SIGNATURE <i>Duane Fammas</i>	STATE AZ
	ZIP CODE 86302
	DATE 03-19-2001
	TELEPHONE 520-717-2844

IMPORTANT: In these spaces, copy the corresponding information from Section A.			For Insurance Company Use:
BUILDING STREET ADDRESS (Including Apt., Unit, Suite, or Bldg. No.) OR P.O. ROUTE AND BOX NO. 24245 Riviera Ave			Policy Number
CITY Paulden	STATE AZ	ZIP CODE 86343	Company NAIC Number

SECTION D - SURVEYOR, ENGINEER, OR ARCHITECT CERTIFICATION (CONTINUED)

Copy both sides of this Elevation Certificate for (1) community official, (2) insurance agent/company, and (3) building owner.

COMMENTS

ELEVATION BASED ON YAVAPAI COUNTY FLOOD MONUMENT ERM 1415 WITH AN ELEVATION OF 4400.46 AS SHOWN ON FEMA FLOODWAY MAP

SITE BUILT HOME ON CINDER BLOCK STEM WALL WITH AN ENCLOSED ADDITION ON CONCRETE SLAB. THE FLOOD OPENINGS CONSIST OF 2 - 3'X9'

VENTS ON THE WESTERLY FACE AND 1 - 12'X18" ON THE SOUTHERLY FACE OF THE STRUCTURE.

☒ Check here if attachments

SECTION E - BUILDING ELEVATION INFORMATION (SURVEY NOT REQUIRED) FOR ZONE AO AND ZONE A (WITHOUT BFE)

For Zone AO and Zone A (without BFE), complete Items E1 through E4. If the Elevation Certificate is intended for use as supporting information for a LOMA or LOMR-F, Section C must be completed.

E1. Building Diagram Number __ (Select the building diagram most similar to the building for which this certificate is being completed – see pages 6 and 7. If no diagram accurately represents the building, provide a sketch or photograph.)

E2. The top of the bottom floor (including basement or enclosure) of the building is __ ft.(m) __ in.(cm) ☐ above or ☐ below (check one) the highest adjacent grade. (Use natural grade, if available).

E3. For Building Diagrams 6-8 with openings (see page 7), the next higher floor or elevated floor (elevation b) of the building is __ ft.(m) __ in.(cm) above the highest adjacent grade. Complete items C3.h and C3.i on front of form.

E4. For Zone AO only: If no flood depth number is available, is the top of the bottom floor elevated in accordance with the community's floodplain management ordinance?

☐ Yes ☐ No ☐ Unknown. The local official must certify this information in Section G.

SECTION F - PROPERTY OWNER (OR OWNER'S REPRESENTATIVE) CERTIFICATION

The property owner or owner's authorized representative who completes Sections A, B, C (Items C3.h and C3.i only), and E for Zone A (without a FEMA-issued or community-issued BFE) or Zone AO must sign here. The statements in Sections A, B, C, and E are correct to the best of my knowledge.

PROPERTY OWNER'S OR OWNER'S AUTHORIZED REPRESENTATIVE'S NAME

ADDRESS CITY STATE ZIP CODE

SIGNATURE DATE TELEPHONE

COMMENTS

☐ Check here if attachments

SECTION G - COMMUNITY INFORMATION (OPTIONAL)

The local official who is authorized by law or ordinance to administer the community's floodplain management ordinance can complete Sections A, B, C (or E), and G of this Elevation Certificate. Complete the applicable item(s) and sign below.

G1. ☐ The information in Section C was taken from other documentation that has been signed and embossed by a licensed surveyor, engineer, or architect who is authorized by state or local law to certify elevation information. (Indicate the source and date of the elevation data in the Comments area below.)

G2. ☐ A community official completed Section E for a building located in Zone A (without a FEMA-issued or community-issued BFE) or Zone AO.

G3. ☐ The following information (Items G4-G9) is provided for community floodplain management purposes.

G4. PERMIT NUMBER	G5. DATE PERMIT ISSUED	G6. DATE CERTIFICATE OF COMPLIANCE/OCCUPANCY ISSUED
-------------------	------------------------	---

G7. This permit has been issued for: ☐ New Construction ☐ Substantial Improvement

G8. Elevation of as-built lowest floor (including basement) of the building is:

__ ft.(m)

Datum: __

G9. BFE or (in Zone AO) depth of flooding at the building site is:

__ ft.(m)

Datum: __

LOCAL OFFICIAL'S NAME TITLE

COMMUNITY NAME TELEPHONE

SIGNATURE DATE


COMMENTS

☐ Check here if attachments

SURVEY LOT 1283 HOLIDAY LAKE ESTATES

SEC. 34, T18N, R2W, G & SRB & M., YAVAPAI COUNTY, ARIZONA

DATE OF SURVEY
MARCH, 2001
DRAWING SCALE
1 IN = 40 FT

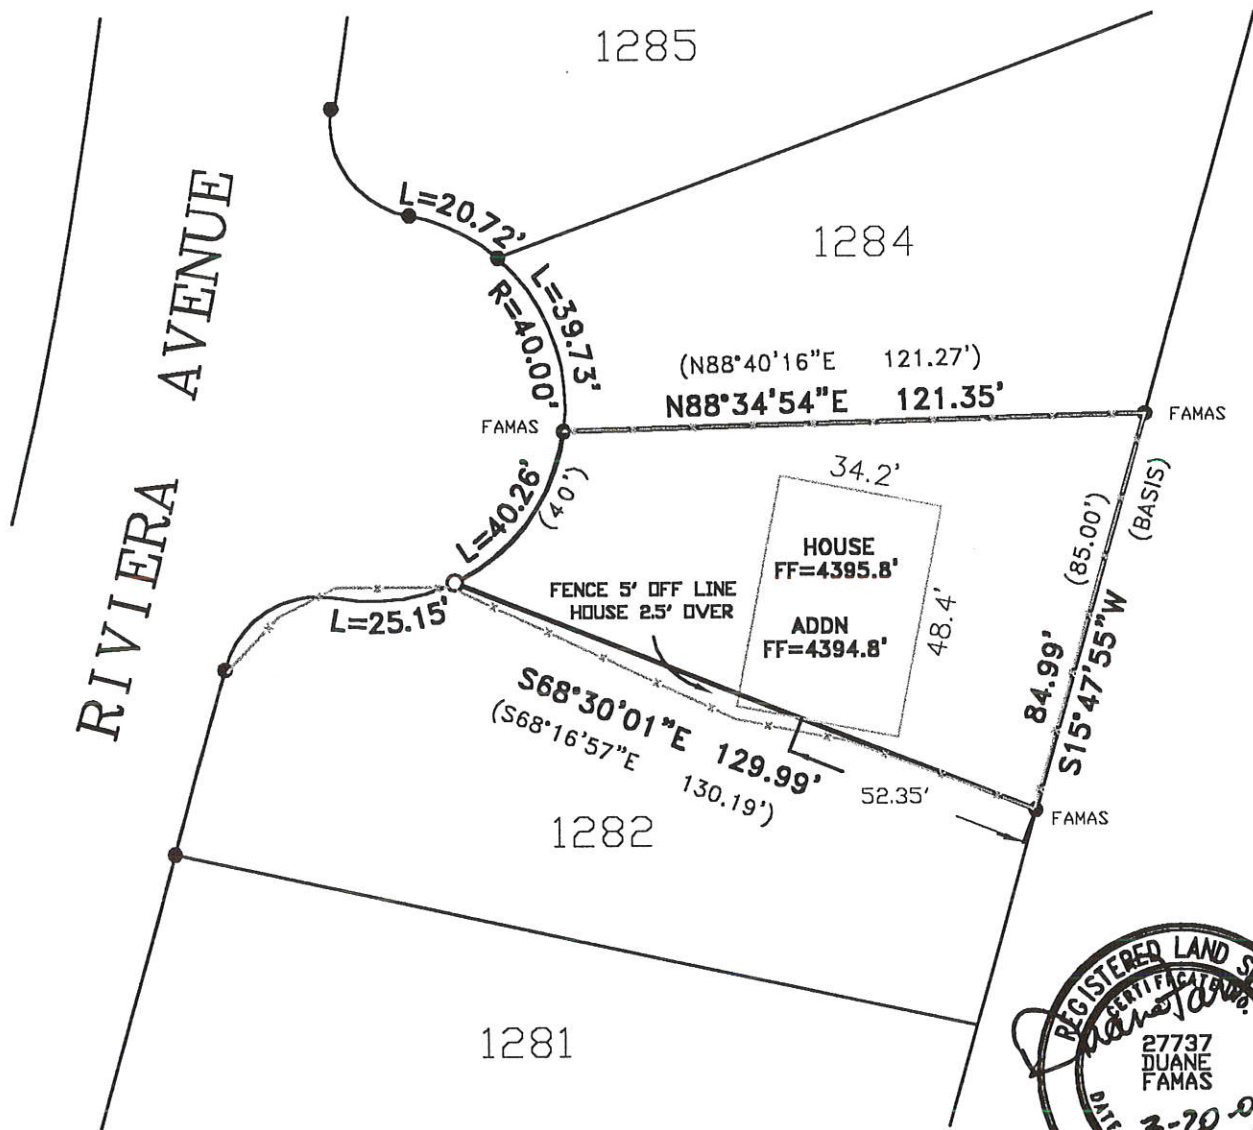

- = FOUND 1/2" REBAR OR AS NOTED
- = SET 1/2" REBAR WITH PLASTIC CAP
STAMPED " FAMAS " LS 27738
- () = RECORD INFORMATION PER
BOOK 8 MAPS PAGE 40 YCRO
- * = AFFIXED BRASS TAG " FAMAS "

BASIS OF ELEVATIONS FROM
ERM 1415 E=4400.46'



FAMAS LAND SURVEYORS, INC.

P.O. BOX 4357 PRESCOTT, AZ 86302
PHONE (520)-717-2844 FAX (520)-717-2840

DRAWN BY: DEF

FILE NO.: 105Y01

NOTE THAT ALL EASEMENTS OF RECORD MAY NOT BE SHOWN ON THIS PLAT