

# ELEVATION CERTIFICATE

Important: Read the instructions on pages 1 - 7.

## SECTION A - PROPERTY OWNER INFORMATION

BUILDING OWNER'S NAME <b>PAUL FLANNERY</b>		For Insurance Company Use:
BUILDING STREET ADDRESS (Including Apt., Unit, Suite, and/or Bldg. No.) OR P.O. ROUTE AND BOX NO. <b>24315 ST. LOUIS ST.</b>		Policy Number
CITY <b>PAULDEN</b>	STATE <b>AZ</b>	Company NAIC Number
PROPERTY DESCRIPTION (Lot and Block Numbers, Tax Parcel Number, Legal Description, etc.) <b>LOT 222 SUNSET MOBILE SITE ... APN 304-07-222</b>		ZIP CODE <b>86334</b>
BUILDING USE (e.g., Residential, Non-residential, Addition, Accessory, etc. Use Comments section if necessary.) <b>RESIDENTIAL</b>		
LATITUDE/LONGITUDE (OPTIONAL) (##° - ##' - ##"##" or ##.#####°)	HORIZONTAL DATUM: <input checked="" type="checkbox"/> NAD:1927 <input type="checkbox"/> NAD 1983	SOURCE: <input type="checkbox"/> GPS (Type): _____ <input type="checkbox"/> USGS Quad Map <input type="checkbox"/> Other: _____

## SECTION B - FLOOD INSURANCE RATE MAP (FIRM) INFORMATION

B1. NFIP COMMUNITY NAME & COMMUNITY NUMBER <b>YAVAPAI-040093</b>		B2. COUNTY NAME <b>YAVAPAI</b>		B3. STATE <b>AZ</b>	
B4. MAP AND PANEL NUMBER <b>0605-040093</b>	B5. SUFFIX <b>C</b>	B6. FIRM INDEX DATE <b>MAR 9, 1999</b>	B7. FIRM PANEL EFFECTIVE/REVISED DATE <b>9-20-1996</b>	B8. FLOOD ZONE(S) <b>A9</b>	B9. BASE FLOOD ELEVATION(S) (Zone AO, use depth of flooding) <b>4423.0</b>

B10 Indicate the source of the Base Flood Elevation (BFE) data or base flood depth entered in B9.  
 FIS Profile  FIRM  Community Determined  Other (Describe): \_\_\_\_\_

B11 Indicate the elevation datum used for the BFE in B9:  NGVD 1929  NAVD 1988  Other (Describe): \_\_\_\_\_

B12 Is the building located in a Coastal Barrier Resources System (CBRS) area or Otherwise Protected Area (OPA)?  Yes  No  
 Designation Date: \_\_\_\_\_

## SECTION C - BUILDING ELEVATION INFORMATION (SURVEY REQUIRED)


C1. Building elevations are based on:  Construction Drawings\*  Building Under Construction\*  Finished Construction  
 \*A new Elevation Certificate will be required when construction of the building is complete.

C2. Building Diagram Number **B** (Select the building diagram most similar to the building for which this certificate is being completed - see pages 6 and 7. If no diagram accurately represents the building, provide a sketch or photograph.)

C3. Elevations - Zones A1-A30, AE, AH, A (with BFE), VE, V1-V30, V (with BFE), AR, AR/A, AR/AE, AR/A1-A30, AR/AH, AR/AO  
 Complete Items C3a-i below according to the building diagram specified in Item C2. State the datum used. If the datum is different from the datum used for the BFE in Section B, convert the datum to that used for the BFE. Show field measurements and datum conversion calculation. Use the space provided or the Comments area of Section D or Section G, as appropriate, to document the datum conversion.  
 Datum \_\_\_\_\_ Conversion/Comments \_\_\_\_\_

Elevation reference mark used **ERM 1415** Does the elevation reference mark used appear on the FIRM?  Yes  No

<input type="checkbox"/> a) Top of bottom floor (including basement or enclosure)	<b>4425</b>	<b>4</b> ft. (M)
<input type="checkbox"/> b) Top of next higher floor	<b>NA</b>	ft. (B)
<input type="checkbox"/> c) Bottom of lowest horizontal structural member (Zones only)	<b>4424</b>	<b>0</b> ft. (B)
<input type="checkbox"/> d) Attached garage (top of slab)	<b>NA</b>	ft. (B)
<input type="checkbox"/> e) Lowest elevation of machinery and/or equipment servicing the building	<b>NA</b>	ft. (B)
<input type="checkbox"/> f) Lowest adjacent grade (LAG)	<b>4422</b>	<b>0</b> ft. (B)
<input type="checkbox"/> g) Highest adjacent grade (HAG)	<b>4422</b>	<b>0</b> ft. (B)
<input type="checkbox"/> h) No. of permanent openings (flood vents) within 1 ft. above adjacent grade	<b>15</b>	
<input type="checkbox"/> i) Total area of all permanent openings (flood vents) in C3h	<b>2,025</b>	sq. in. (sq. cm)

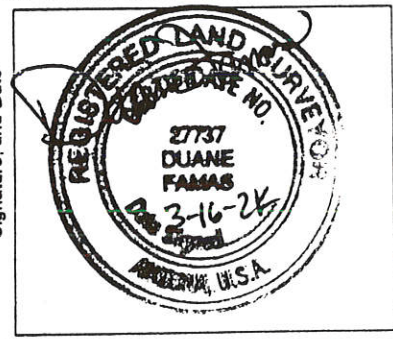

## SECTION D - SURVEYOR, ENGINEER, OR ARCHITECT CERTIFICATION

This certification is to be signed and sealed by a land surveyor, engineer, or architect authorized by law to certify elevation information. I certify that the information in Sections A, B, and C on this certificate represents my best efforts to interpret the data available. I understand that any false statement may be punishable by fine or imprisonment under 18 U.S. Code, Section 1001.

CERTIFIER'S NAME <b>DUANE FAMAS</b>	LICENSE NUMBER <b>RLS 27737</b>
TITLE <b>LAND SURVEYOR</b>	COMPANY NAME <b>FAMAS LAND SURVEYORS</b>
ADDRESS <b>131 ROBINSON DR.</b>	CITY STATE ZIP CODE <b>PRESCOTT AZ 86303</b>
SIGNATURE	DATE TELEPHONE <b>3-14-2K 520-717-2844</b>



IMPORTANT: In these spaces, copy the corresponding information from Section A.			For Insurance Company Use:
BUILDING STREET ADDRESS (Including Apt., Suite, and/or Bldg. No.) OR P.O. ROUTE AND BC			Policy Number
CITY	STATE	ZIP CODE	Company NAIC Number

**SECTION D - SURVEYOR, ENGINEER, OR ARCHITECT CERTIFICATION (CONTINUED)**

Copy both sides of this Elevation Certificate for (1) community official, (2) insurance agent/company, and (3) building owner.

COMMENTS LOWEST ELEVATION OF STRUCTURAL MEMBER OF MOBILE HOME SET ON STANDS IS 4424.0

Check here if attachments


**SECTION E - BUILDING ELEVATION INFORMATION (SURVEY NOT REQUIRED) FOR ZONE AO and ZONE A (WITHOUT BFE)**

For Zone AO and Zone A (without BFE), complete Items E1 through E3. If the Elevation Certificate is intended for use as supporting information for a LOMA or LOMR-F, Section C must be completed.

- E1. Building Diagram Number \_\_\_\_\_ (Select the building diagram most similar to the building for which this certificate is being completed – see pages 6 and 7. If no diagram accurately represents the building, provide a sketch or photograph.)
- E2. The top of the bottom floor (including basement or enclosure) of the building is \_\_\_\_\_ ft.(m) \_\_\_\_\_ in.(cm) \_\_\_\_\_ above or \_\_\_\_\_ below (check one) the highest adjacent grade.
- E3. For Zone AO only: If no flood depth number is available, is the top of the bottom floor elevated in accordance with the community's floodplain management ordinance?  Yes  No  Unknown. The local official must certify this information in Section G.

**SECTION F - PROPERTY OWNER (OR OWNER'S REPRESENTATIVE) CERTIFICATION**

The property owner or owner's authorized representative who completes Sections A, B, and E for Zone A (without a FEMA-issued or community-issued BFE) or Zone AO must sign here.

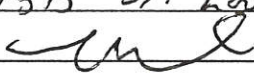PROPERTY OWNER'S OR OWNER'S AUTHORIZED REPRESENTATIVE'S NAME <u>PAUL FLANNERY</u>			
ADDRESS <u>24375 ST. LOUIS ST.</u>	CITY <u>PAULDEN</u>	STATE <u>AZ</u>	ZIP CODE <u>86334</u>
SIGNATURE 	DATE <u>4-12-00</u>	TELEPHONE <u>636-5526</u>	
COMMENTS			

Check here if attachments

**SECTION G - COMMUNITY INFORMATION (OPTIONAL)**

The local official who is authorized by law or ordinance to administer the community's floodplain management ordinance can complete Sections A, B, C (or E), and G of this Elevation Certificate. Complete the applicable item(s) and sign below.

- G1.  The information in Section C was taken from other documentation that has been signed and embossed by a licensed surveyor, engineer, or architect who is authorized by state or local law to certify elevation information. (Indicate the source and date of the elevation data in the Comments area below.)
- G2.  A community official completed Section E for a building located in Zone A (without a FEMA-issued or community-issued BFE) or Zone AO.
- G3.  The following information (Items G4-G9) is provided for community floodplain management purposes.

G4. PERMIT NUMBER	G5. DATE PERMIT ISSUED	G6. DATE CERTIFICATE OF COMPLIANCE/OCCUPANCY ISSUED
-------------------	------------------------	---

- G7. This permit has been issued for:  New Construction  Substantial Improvement
- G8. Elevation of as-built lowest floor (including basement) of the building is: \_\_\_\_\_ ft.(m) Datum: \_\_\_\_\_
- G9. BFE or (in Zone AO) depth of flooding at the building site is: \_\_\_\_\_ ft.(m) Datum: \_\_\_\_\_

LOCAL OFFICIAL'S NAME	TITLE
COMMUNITY NAME	TELEPHONE
SIGNATURE	DATE
COMMENTS	

Check here if attachments

# ELEVATION OF FLOODPLAIN PROPERTY

When Completed Return To: Yavapai County Flood Control District, 500 S. Marina St., Prescott, AZ, 86303  
(520) 771-3197 FAX 771-3427

DATE 12-21-99

ASSESSORS NUMBER 304-07-222

SUBDIVISION NAME AND NUMBER LOT 222 SUNSET MOBILE HOME SITES

OWNER VIA MIKE @ HIGH COUNTRY HOMES

SITUS ADDRESS \_\_\_\_\_

BASE BENCHMARK: Number ERM 1415 Elevation 4400.46


PROPERTY BENCHMARK 4419.3

DESCRIPTION OF PROPERTY BENCHMARK 1/2" REBAR @ SW COR. LOT 222


GROUND ELEVATIONS AT BUILDING SITE 4422.0

(Please provide a minimum of three (3) elevations points, representative of the site)

Sketch of Lot  
(include location of property benchmark and building site elevations)

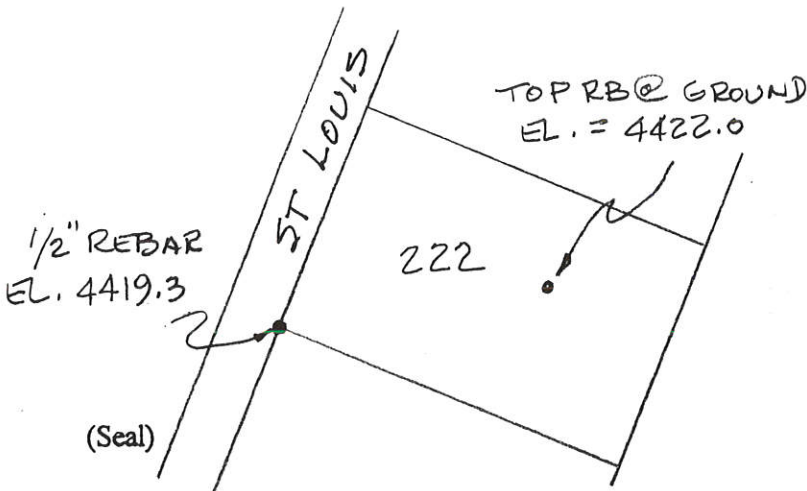

Remarks \_\_\_\_\_

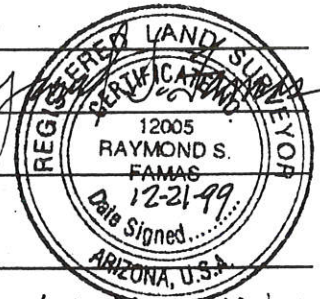

Signed FAMAS LAND SURVEYORS

Company Name 131 ROBINSON DR.

Address PRESCOTT AZ. 86302

Telephone 717-2844

FOR YAVAPAI COUNTY FLOOD CONTROL DISTRICT USE:

Date: 12/23/99

Base Flood Elevation 4423.0 + 1.0' = Regulatory Elevation 4424.0'

\* ELEVATION DETERMINATIONS ARE BASED ON BEST AVAILABLE DATA WHEN CALCULATED. ELEVATIONS ARE SUBJECT TO CHANGE WHEN NEW OR REVISED FLOOD STUDIES, OR DATA IS SUPPLIED TO THE DISTRICT.