

# ELEVATION CERTIFICATE

Important: Read the instructions on pages 1 - 7.

## SECTION A - PROPERTY OWNER INFORMATION

BUILDING OWNER'S NAME

GREAT REPUBLIC MORTGAGE

For Insurance Company Use:

BUILDING STREET ADDRESS (Including Apt., Unit, Suite, and/or Bldg. No.) OR P.O. ROUTE AND BOX NO.  
24350 N. ST. LOUIS

Policy Number

CITY  
PAULDEN

Company NAIC Number

STATE

AZ

ZIP CODE

860334

PROPERTY DESCRIPTION (Lot and Block Numbers, Tax Parcel Number, Legal Description, etc.)  
APN 304-07-235 LOT 235 SUNSET MAP

BUILDING USE (e.g., Residential, Non-residential, Addition, Accessory, etc. Use Comments section if necessary.)  
RESIDENTIAL

LATITUDE/LONGITUDE (OPTIONAL)  
(#°-##'-###" or ###.###)

HORIZONTAL DATUM:

NAD 1927  NAD 1983

SOURCE:  GPS (Type):

USGS Quad Map  Other:

## SECTION B - FLOOD INSURANCE RATE MAP (FIRM) INFORMATION

B1. NFIP COMMUNITY NAME & COMMUNITY NUMBER

YAVAPI COUNTY 040093

B2. COUNTY NAME

YAVAPI

B3. STATE

AZ

B4. MAP AND PANEL NUMBER

040093 1005

B5. SUFFIX

C

B6. FIRM INDEX DATE

3.9.99

B7. FIRM PANEL EFFECTIVE/REVISED DATE

1-26-2000

B8. FLOOD ZONE(S)

AE

B9. BASE FLOOD ELEVATION(S)  
(Zone AO, use depth of flooding)

4421.0

B10. Indicate the source of the Base Flood Elevation (BFE) data or base flood depth entered in B9.  
 FIS Profile  FIRM  Community Determined  Other (Describe):

B11. Indicate the elevation datum used for the BFE in B9:  NGVD 1929  NAVD 1988  Other (Describe):

B12. Is the building located in a Coastal Barrier Resources System (CBRS) area or Otherwise Protected Area (OPA)?  Yes  No  
Designation Date:

## SECTION C - BUILDING ELEVATION INFORMATION (SURVEY REQUIRED)

C1. Building elevations are based on:  Construction Drawings\*  Building Under Construction\*  Finished Construction  
\*A new Elevation Certificate will be required when construction of the building is complete.

C2. Building Diagram Number 8 (Select the building diagram most similar to the building for which this certificate is being completed - see pages 6 and 7. If no diagram accurately represents the building, provide a sketch or photograph.)

C3. Elevations - Zones A1-A30, AE, AH, A (with BFE), VE, V1-V30, V (with BFE), AR, AR/A, AR/AE, AR/A1-A30, AR/AH, AR/AO  
Complete Items C3a-i below according to the building diagram specified in Item C2. State the datum used. If the datum is different from the datum used for the BFE in Section B, convert the datum to that used for the BFE. Show field measurements and datum conversion calculation. Use the space provided or the Comments area of Section D or Section G, as appropriate, to document the datum conversion.

Datum \_\_\_\_\_ Conversion/Comments \_\_\_\_\_  
Elevation reference mark used \_\_\_\_\_ Does the elevation reference mark used appear on the FIRM?  Yes  No

a) Top of bottom floor (including basement or enclosure) \_\_\_\_\_ 44 19 . 80 ft. (m)

b) Top of next higher floor \_\_\_\_\_ 44 23 . 40 ft. (m)

c) Bottom of lowest horizontal structural member (V zones only) \_\_\_\_\_ 44 22 . 10 ft. (m)

d) Attached garage (top of slab) \_\_\_\_\_ N/A ft. (m)

e) Lowest elevation of machinery and/or equipment servicing the building \_\_\_\_\_ N/A ft. (m)


f) Lowest adjacent grade (LAG) \_\_\_\_\_ 44 19 . 07 ft. (m)

g) Highest adjacent grade (HAG) \_\_\_\_\_ 44 19 . 38 ft. (m)

h) No. of permanent openings (flood vents) within 1 ft. above adjacent grade 2

i) Total area of all permanent openings (flood vents) in C3h 1020 sq. in. (sq. cm)

License Number, Embossed Seal, Signature, and Date

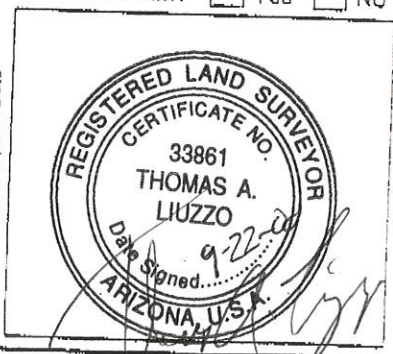

## SECTION D - SURVEYOR, ENGINEER, OR ARCHITECT CERTIFICATION

This certification is to be signed and sealed by a land surveyor, engineer, or architect authorized by law to certify elevation information.

I certify that the information in Sections A, B, and C on this certificate represents my best efforts to interpret the data available.

I understand that any false statement may be punishable by fine or imprisonment under 18 U.S. Code, Section 1001.

CERTIFIER'S NAME  
Thomas A. Liuzzo

LICENSE NUMBER  
#33861

TITLE  
Survey Manager

COMPANY NAME  
Swire Engineering Inc

ADDRESS  
2432 8183 N. Verde Lane

CITY  
Prescott Valley

STATE

AZ

ZIP CODE

86314

SIGNATURE  
Thomas A. Liuzzo

DATE  
9-28-00

TELEPHONE

520-772-2924



<b>IMPORTANT: In these spaces, copy the corresponding information from Section A.</b> BUILDING STREET ADDRESS (Including Apt., Unit, Suite, and/or Bldg. No.) OR P.O. ROUTE AND BOX NO. <u>24350 N. ST. LOUIS</u>	For Insurance Company Use:	
	Policy Number:	
	Company NAIC Number:	
CITY <u>PAULDEN</u>	STATE <u>AZ</u>	ZIP CODE <u>86334</u>

**SECTION D - SURVEYOR, ENGINEER, OR ARCHITECT CERTIFICATION (CONTINUED)**

Copy both sides of this Elevation Certificate for (1) community official, (2) insurance agent/company, and (3) building owner.

COMMENTS

Check here if attachments

**SECTION E - BUILDING ELEVATION INFORMATION (SURVEY NOT REQUIRED) FOR ZONE AO AND ZONE A (WITHOUT BFE)**

For Zone AO and Zone A (without BFE), complete Items E1 through E4. If the Elevation Certificate is intended for use as supporting information for a LOMA or LOMR-F, Section C must be completed.

- E1. Building Diagram Number \_\_\_\_\_ (Select the building diagram most similar to the building for which this certificate is being completed - see pages 6 and 7. If no diagram accurately represents the building, provide a sketch or photograph.)
- E2. The top of the bottom floor (including basement or enclosure) of the building is \_\_\_\_\_ ft.(m) \_\_\_\_\_ in.(cm) \_\_\_\_\_ above or \_\_\_\_\_ below (check one) the highest adjacent grade.
- E3. For Building Diagrams 6-8 with openings (see page 7), the next higher floor or elevated floor (elevation b) of the building is \_\_\_\_\_ ft.(m) \_\_\_\_\_ in.(cm) above the highest adjacent grade.
- E4. For Zone AO only: If no flood depth number is available, is the top of the bottom floor elevated in accordance with the community's floodplain management ordinance?  Yes  No  Unknown. The local official must certify this information in Section G.

**SECTION F - PROPERTY OWNER (OR OWNER'S REPRESENTATIVE) CERTIFICATION**

The property owner or owner's authorized representative who completes Sections A, B, and E for Zone A (without a FEMA-issued or community-issued BFE) or Zone AO must sign here.

PROPERTY OWNER'S OR OWNER'S AUTHORIZED REPRESENTATIVE'S NAME

ADDRESS	CITY	STATE	ZIP CODE
SIGNATURE	DATE	TELEPHONE	
COMMENTS			

Check here if attachments

**SECTION G - COMMUNITY INFORMATION (OPTIONAL)**

The local official who is authorized by law or ordinance to administer the community's floodplain management ordinance can complete Sections A, B, C (or E), and G of this Elevation Certificate. Complete the applicable item(s) and sign below.

- G1.  The information in Section C was taken from other documentation that has been signed and embossed by a licensed surveyor, engineer, or architect who is authorized by state or local law to certify elevation information. (Indicate the source and date of the elevation data in the Comments area below.)
- G2.  A community official completed Section E for a building located in Zone A (without a FEMA-issued or community-issued BFE) or Zone AO.
- G3.  The following information (Items G4-G9) is provided for community floodplain management purposes.

G4. PERMIT NUMBER	G5. DATE PERMIT ISSUED	G6. DATE CERTIFICATE OF COMPLIANCE/OCCUPANCY ISSUED
-------------------	------------------------	---

- G7. This permit has been issued for:  New Construction  Substantial Improvement
- G8. Elevation of as-built lowest floor (including basement) of the building is: \_\_\_\_\_ ft.(m) Datum: \_\_\_\_\_
- G9. BFE or (in Zone AO) depth of flooding at the building site is: \_\_\_\_\_ ft.(m) Datum: \_\_\_\_\_

LOCAL OFFICIAL'S NAME	TITLE
COMMUNITY NAME	TELEPHONE
SIGNATURE	DATE
COMMENTS	

Check here if attachments

### ELEVATION OF FLOODPLAIN PROPERTY

When Completed Return To: Yavapai County Flood Control District, 500 S. Marina St., Prescott, AZ, 86303  
(520) 771-3197 FAX 771-3427

DATE 20 July 2000

ASSESSOR'S PARCEL NUMBER 304-07-235

SUBDIVISION NAME UNIT/PHASE AND LOT NUMBER SUNSET ESTATES LOT 235

OWNER HIGH COUNTRY HOMES

SITUS ADDRESS \_\_\_\_\_

BASE BENCHMARK: Number ERM 1415 Elevation 4400.46

PROPERTY BENCHMARK 4420.00

DESCRIPTION OF PROPERTY BENCHMARK 5/8" REBAR WITH PLASTIC CAP MARKED

SUNRISE MARKER LOCATED IN THE NORTH EAST CORNER OF LOT 235

GROUND ELEVATIONS AT BUILDING SITE 4419.47

(Please provide a minimum of three (3) elevations points, representative of the site)



Sketch of Lot  
(include location of property benchmark and building site elevations)

Remarks SEE 5/8" REBAR WITH

RED PLASTIC CAP MARKED

SUNRISE MARKER FOR GROUND

ELEVATION AT BUILDING SITE

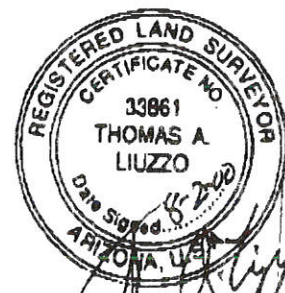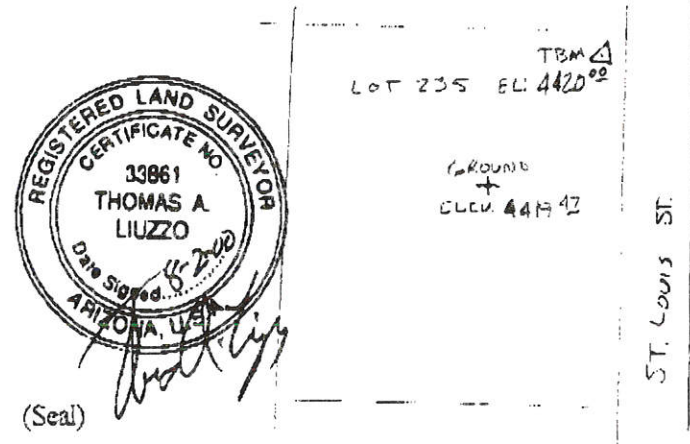

(Seal)

Signed Wes A. Lizzo

Company Name SUNRISE ENGINEERING, INC.

Address 2183 E FLORENCE AVE.

PRESCOTT VALLEY AZ. 86314

Telephone (520) 772-2924

FOR YAVAPAI COUNTY FLOOD CONTROL DISTRICT USE:

Date: \_\_\_\_\_

Base Flood Elevation 4421.0' + 1.0' = Regulatory Elevation 4422.0'

\* ELEVATION DETERMINATIONS ARE BASED ON BEST AVAILABLE DATA WHEN CALCULATED. ELEVATIONS ARE SUBJECT TO CHANGE WHEN NEW OR REVISED FLOOD STUDIES, OR DATA IS SUPPLIED TO THE DISTRICT.