

ELEVATION CERTIFICATE

Important: Read the instructions on pages 1 - 7.

SECTION A - PROPERTY OWNER INFORMATION		For Insurance Company Use:
BUILDING OWNER'S NAME <u>GREAT REPUBLIC MORTGAGE</u>		Policy Number
BUILDING STREET ADDRESS (Including Apt., Unit, Suite, and/or Bldg. No.) OR P.O. ROUTE AND BOX NO. <u>380 E. HOUSTON ROAD</u>		Company NAIC Number
CITY	STATE	ZIP CODE

PROPERTY DESCRIPTION (Lot and Block Numbers, Tax Parcel Number, Legal Description, etc.)
A.P.N. 304-07-330

BUILDING USE (e.g., Residential, Non-residential, Addition, Accessory, etc. Use Comments area if necessary.)
RESIDENTIAL

LATITUDE/LONGITUDE (OPTIONAL) (##° - ##' - ##.###" or ##.#####°) _____

HORIZONTAL DATUM: NAD 1927 NAD 1983

SOURCE: GPS (Type): _____
 USGS Quad Map Other: _____

SECTION B - FLOOD INSURANCE RATE MAP (FIRM) INFORMATION

B1. NFIP COMMUNITY NAME & COMMUNITY NUMBER <u>YAVAPAI COUNTY 040093</u>		B2. COUNTY NAME <u>YAVAPAI</u>		B3. STATE <u>AZ</u>	
B4. MAP AND PANEL NUMBER <u>04025C0990</u>	B5. SUFFIX <u>F</u>	B6. FIRM INDEX DATE <u>6-06-01</u>	B7. FIRM PANEL EFFECTIVE/REVISED DATE <u>6-06-01</u>	B8. FLOOD ZONES <u>AE</u>	B9. BASE FLOOD ELEVATION(S) <u>4406.70'</u>

B10. Indicate the source of the Base Flood Elevation (BFE) data or base flood depth entered in B9.
 FIS Profile FIRM Community Determined Other (Describe): _____

B11. Indicate the elevation datum used for the BFE in B9: NGVD 1929 NAVD 1988 Other (Describe): _____

B12. Is the building located in a Coastal Barrier Resources System (CBRS) area or Otherwise Protected Area (OPA)? Yes No
Designation Date: _____

SECTION C - BUILDING ELEVATION INFORMATION (SURVEY REQUIRED)

C1. Building elevations are based on: Construction Drawings* Building Under Construction* Finished Construction
*A new Elevation Certificate will be required when construction of the building is complete.


C2. Building Diagram Number B (Select the building diagram most similar to the building for which this certificate is being completed - see pages 6 and 7. If no diagram accurately represents the building, provide a sketch or photograph.)

C3. Elevations - Zones A1-A30, AE, AH, A (with BFE), VE, V1-V30, V (with BFE), AR, AR/A, AR/AE, AR/A1-A30, AR/AH, AR/AO
Complete Items C3.a-i below according to the building diagram specified in Item C2. State the datum used. If the datum is different from the datum used for the BFE in Section B, convert the datum to that used for the BFE. Show field measurements and datum conversion calculation. Use the space provided or the Comments area of Section D or Section G, as appropriate, to document the datum conversion.
Datum _____ Conversion/Comments _____

Elevation reference mark used RM 23 (ERM-1415) Does the elevation reference mark used appear on the FIRM? Yes No

- a) Top of bottom floor (including basement or enclosure) 4405.05 ft.(m)
- b) Top of next higher floor 4409.80 ft.(m)
- * c) Bottom of lowest horizontal structural member (V zones only) 4408.25 ft.(m)
- d) Attached garage (top of slab) N/A ft.(m)
- e) Lowest elevation of machinery and/or equipment servicing the building (Describe in a Comments area.) N/A ft.(m)
- f) Lowest adjacent (finished) grade (LAG) 4404.90 ft.(m)
- g) Highest adjacent (finished) grade (HAG) 4406.15 ft.(m)
- h) No. of permanent openings (flood vents) within 1 ft. above adjacent grade 16
- i) Total area of all permanent openings (flood vents) in C3.h 2506 sq. in. (sq. cm)

License Number, Embossed Seal, Signature, and Date

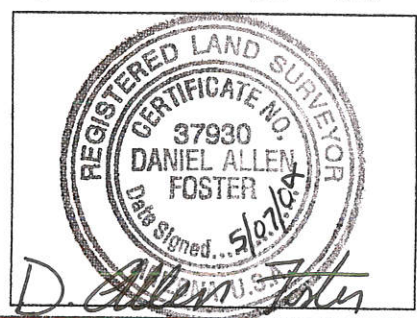

SECTION D - SURVEYOR, ENGINEER, OR ARCHITECT CERTIFICATION

This certification is to be signed and sealed by a land surveyor, engineer, or architect authorized by law to certify elevation information. I certify that the information in Sections A, B, and C on this certificate represents my best efforts to interpret the data available. I understand that any false statement may be punishable by fine or imprisonment under 18 U.S. Code, Section 1001.

CERTIFIER'S NAME <u>D. ALLEN FOSTER</u>	LICENSE NUMBER <u>RLS #37930</u>
TITLE <u>OWNER</u>	COMPANY NAME <u>FOSTCO SURVEYING INC.</u>
ADDRESS <u>P.O. Box 4363</u>	CITY <u>CHINO VALLEY</u>
SIGNATURE <u>D. Allen Foster</u>	DATE <u>5-07-04</u>
	STATE <u>AZ</u>
	ZIP CODE <u>86323</u>
	TELEPHONE <u>928-636-9184</u>

IMPORTANT: In these spaces, copy the corresponding information from Section A.			For Insurance Company Use:
BUILDING STREET ADDRESS (Including Apt., Unit, Suite, and/or Bldg. No.) OR P.O. ROUTE AND BOX NO. 380 E. HOUSTON ROAD			Policy Number
CITY	STATE	ZIP CODE	Company NAIC Number

SECTION D - SURVEYOR, ENGINEER, OR ARCHITECT CERTIFICATION (CONTINUED)

Copy both sides of this Elevation Certificate for (1) community official, (2) insurance agent/company, and (3) building owner.

COMMENTS * ELEVATION OF C3-C IS TO THE BOTTOM OF THE STRUCTURAL FRAME OF A MANUFACTURED HOME. THE HOME IS ELEVATED ON JACKS AND IS ON A CONCRETE BLOCK STEM WALL.

Check here if attachments

SECTION E - BUILDING ELEVATION INFORMATION (SURVEY NOT REQUIRED) FOR ZONE AO AND ZONE A (WITHOUT BFE)

For Zone AO and Zone A (without BFE), complete Items E1. through E4. If the Elevation Certificate is intended for use as supporting information for a LOMA or LOMR-F, Section C must be completed.

- E1. Building Diagram Number _____ (Select the building diagram most similar to the building for which this certificate is being completed - see pages 6 and 7. If no diagram accurately represents the building, provide a sketch or photograph.)
- E2. The top of the bottom floor (including basement or enclosure) of the building is _____ ft.(m) _____ in.(cm) _____ above or _____ below (check one) the highest adjacent grade. (Use natural grade, if available.)
- E3. For Building Diagrams 6-8 with openings (see page 7), the next higher floor or elevated floor (elevation b) of the building is _____ ft.(m) _____ in.(cm) above the highest adjacent grade.
- E4. The top of the platform of machinery and/or equipment servicing the building is _____ ft. (m) _____ in. (cm) _____ above or _____ below (check one) the highest adjacent grade. (Use natural grade, if available.)
- E5. For Zone AO only: If no flood depth number is available, is the top of the bottom floor elevated in accordance with the community's floodplain management ordinance? Yes No Unknown. The local official must certify this information in Section G.

SECTION F - PROPERTY OWNER (OR OWNER'S REPRESENTATIVE) CERTIFICATION

The property owner or owner's authorized representative who completes Sections A, B, C (Items C3.h and C3.i only), and E for Zone A (without a FEMA-issued or community-issued BFE) or Zone AO must sign here. The statements in Sections A, B, C, and E are correct to the best of my knowledge.

PROPERTY OWNER'S OR OWNER'S AUTHORIZED REPRESENTATIVE'S NAME _____

ADDRESS _____	CITY _____	STATE _____	ZIP CODE _____
SIGNATURE _____	DATE _____	TELEPHONE _____	

COMMENTS _____

Check here if attachments

SECTION G - COMMUNITY INFORMATION (OPTIONAL)

The local official who is authorized by law or ordinance to administer the community's floodplain management ordinance can complete Sections A, B, C (or E), and G of this Elevation Certificate. Complete the applicable item(s) and sign below.

- G1. The information in Section C was taken from other documentation that has been signed and embossed by a licensed surveyor, engineer, or architect who is authorized by state or local law to certify elevation information. (Indicate the source and date of the elevation data in the Comments area below.)
- G2. A community official completed Section E for a building located in Zone A (without a FEMA-issued or community-issued BFE) or Zone AO.
- G3. The following information (Items G4-G9) is provided for community floodplain management purposes.

G4. PERMIT NUMBER _____	G5. DATE PERMIT ISSUED _____	G6. DATE CERTIFICATE OF COMPLIANCE/OCCUPANCY ISSUED _____
-------------------------	------------------------------	---

G7. This permit has been issued for: New Construction Substantial Improvement

G8. Elevation of as-built lowest floor (including basement) of the building is: _____ . _____ ft.(m) Datum: _____

G9. BFE or (in Zone AO) depth of flooding at the building site is: _____ . _____ ft.(m) Datum: _____

LOCAL OFFICIAL'S NAME _____	TITLE _____
COMMUNITY NAME _____	TELEPHONE _____
SIGNATURE _____	DATE _____

COMMENTS _____

Check here if attachments

ELEVATION OF FLOODPLAIN PROPERTY

When Completed Return To: **Yavapai County Development Services – Floodplain Unit**
 500 S. Marina St., Prescott, AZ, 86303 (928) 771-3197 FAX 771-3427

DATE 2/19/04

ASSESSOR'S PARCEL NUMBER 304-07-330

SUBDIVISION NAME UNIT/PHASE AND LOT NUMBER SUNSET MOBILE SITES LOT 330

OWNER 1ST AMERICAN TITLE AGENCY

SITUS ADDRESS 24050 N. St. Louis St.

BASE BENCHMARK: Number RM23(ERM-1415) Elevation 4400.46'


PROPERTY BENCHMARK NW. PROPERTY CORNER 1/2" FEMAS REBAR ELEV.= 4405.65 ①

DESCRIPTION OF PROPERTY BENCHMARK 1/2" REBAR (± .20' ABOVE GROUND) ELEV.= 4405.75 ②

GROUND ELEVATIONS AT BUILDING SITE NW. PAD = 4405.08' ③, SW. PAD = 4404.94' ④, NE. PAD = 4405.96' ⑤
 (Please provide a minimum of three (3) elevations points, representative of the site)


Sketch of Lot
 (include location of property benchmark and building site elevations)

Remark

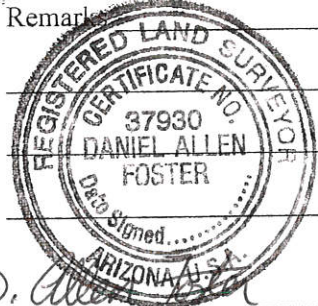

D. Allen Foster

Signed FOSTCO SURVEYING INC.
 Company Name P.O. BOX 4363
 Address CHINO VALLEY, AZ 86323
 Telephone (928)-636-9184

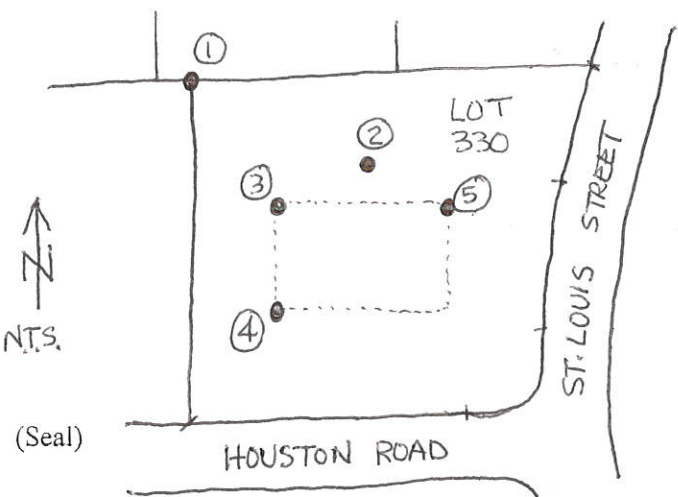

FOR YAVAPAI COUNTY FLOOD CONTROL DISTRICT USE: Date: _____

Base Flood Elevation	+ 1.0' = Regulatory Elevation
----------------------	-------------------------------

** ELEVATION DETERMINATIONS ARE BASED ON BEST AVAILABLE DATA WHEN CALCULATED. ELEVATIONS ARE SUBJECT TO CHANGE WHEN NEW OR REVISED FLOOD STUDIES OR DATA IS SUPPLIED TO THE DISTRICT.*