

FEDERAL EMERGENCY MANAGEMENT AGENCY
NATIONAL FLOOD INSURANCE PROGRAM

O.M.B. No. 3067-0077
Expires July 31, 2002

ELEVATION CERTIFICATE

Important: Read the instructions on pages 1 - 7.

SECTION A - PROPERTY OWNER INFORMATION			For Insurance Company Use:
BUILDING OWNER'S NAME DENNIS McKNIGHT		Policy Number	
BUILDING STREET ADDRESS (Including Apt., Unit, Suite, and/or Bldg. No.) OR P.O. ROUTE AND BOX NO. 679 VALLERI ANN RD		Company NAIC Number	
CITY PAULDEN	STATE AZ	ZIP CODE 86334	
PROPERTY DESCRIPTION (Lot and Block Numbers, Tax Parcel Number, Legal Description, etc.) LOT 85 ANTELOPE LAKES UNIT 5 APN 304-08-212			
BUILDING USE (e.g., Residential, Non-residential, Addition, Accessory, etc. Use a Comments area, if necessary.) RESIDENTIAL			
LATITUDE/LONGITUDE (OPTIONAL) (##° -##' -###.###" or ###.#####") NA		HORIZONTAL DATUM: SOURCE: <input type="checkbox"/> GPS (Type): _____ <input type="checkbox"/> NAD 1927 <input type="checkbox"/> NAD 1983 <input type="checkbox"/> USGS Quad Map <input type="checkbox"/> Other: _____	

SECTION B - FLOOD INSURANCE RATE MAP (FIRM) INFORMATION

B1. NFIP COMMUNITY NAME & COMMUNITY NUMBER YAVAPAI COUNTY UNINCORPORATED 040093		B2. COUNTY NAME YAVAPAI		B3. STATE AZ	
B4. MAP AND PANEL NUMBER 04Q25C0990	B5. SUFFIX F	B6. FIRM INDEX DATE 6/6/2001	B7. FIRM PANEL EFFECTIVE/REVISED DATE 6/6/2001	B8. FLOOD ZONE(S) AE	B9. BASE FLOOD ELEVATION(S) (Zone AO, use depth of flooding) 4565.5

B10. Indicate the source of the Base Flood Elevation (BFE) data or base flood depth entered in B9.
 FIS Profile FIRM Community Determined Other (Describe): _____

B11. Indicate the elevation datum used for the BFE in B9: NGVD 1929 NAVD 1988 Other (Describe): _____

B12. Is the building located in a Coastal Barrier Resources System (CBRS) area or Otherwise Protected Area (OPA)? Yes No Designation Date _____

SECTION C - BUILDING ELEVATION INFORMATION (SURVEY REQUIRED)

C1. Building elevations are based on: Construction Drawings* Building Under Construction* Finished Construction
 *A new Elevation Certificate will be required when construction of the building is complete.

C2. Building Diagram Number 8 (Select the building diagram most similar to the building for which this certificate is being completed - see pages 6 and 7. If no diagram accurately represents the building, provide a sketch or photograph.)

C3. Elevations - Zones A1-A30, AE, AH, A (with BFE), VE, V1-V30, V (with BFE), AR, AR/A, AR/AE, AR/A1-A30, AR/AH, AR/AO
 Complete Items C3.-a-i below according to the building diagram specified in Item C2. State the datum used. If the datum is different from the datum used for the BFE in Section B, convert the datum to that used for the BFE. Show field measurements and datum conversion calculation. Use the space provided or the Comments area of Section D or Section G, as appropriate, to document the datum conversion.
 Datum NA Conversion/Comments _____

Elevation reference mark used RM190 Does the elevation reference mark used appear on the FIRM? Yes No

a) Top of bottom floor (including basement or enclosure) BOTTOM FRAME 4563.66 ft.(m)

b) Top of next higher floor FINISHED FLOOR 4565.1 ft.(m)

c) Bottom of lowest horizontal structural member (V zones only) NA. ft.(m)

d) Attached garage (top of slab) NA. ft.(m)

e) Lowest elevation of machinery and/or equipment servicing the building (Describe in a Comments area) NA. ft.(m)

f) Lowest adjacent (finished) grade (LAG) 4562.5 ft.(m)

g) Highest adjacent (finished) grade (HAG) 4562.5 ft.(m)

h) No. of permanent openings (flood vents) within 1 ft. above adjacent grade NONE

i) Total area of all permanent openings (flood vents) in C3.h NA sq. in. (sq. cm)

License Number, Embossed Seal, Signature, and Date



SECTION D - SURVEYOR, ENGINEER, OR ARCHITECT CERTIFICATION

This certification is to be signed and sealed by a land surveyor, engineer, or architect authorized by law to certify elevation information.
 I certify that the information in Sections A, B, and C on this certificate represents my best efforts to interpret the data available.
 I understand that any false statement may be punishable by fine or imprisonment under 18 U.S. Code, Section 1001.

CERTIFIER'S NAME DUANE FAMAS LICENSE NUMBER AZ RLS 27737

TITLE LAND SURVEYOR/PRESIDENT COMPANY NAME FAMAS LAND SURVEYORS, INC.

ADDRESS P.O. BOX 4357 CITY PRESCOTT STATE AZ ZIP CODE 86302

SIGNATURE *Duane Famás* AZ RLS 27737 DATE 8/5/2002 TELEPHONE 928-717-2844

IMPORTANT: In these spaces, copy the corresponding information from Section A.			For Insurance Company Use:
BUILDING STREET ADDRESS (Including Apt., Unit, Suite, or Bldg. No.) OR P.O. ROUTE AND BOX NO. 679 VALLERI ANN RD			Policy Number
CITY PAULDEN	STATE AZ	ZIP CODE 86334	Company NAIC Number

SECTION D - SURVEYOR, ENGINEER, OR ARCHITECT CERTIFICATION (CONTINUED)

Copy both sides of this Elevation Certificate for (1) community official, (2) insurance agent/company, and (3) building owner.

COMMENTS

SINGLE WIDE MANUFACTURED HOME ON STANDS, NO PERMANENT FLOOD VENTS SEE MAP ATTACHED FOR LOCATION ON LOT

Check here if attachments

SECTION E - BUILDING ELEVATION INFORMATION (SURVEY NOT REQUIRED) FOR ZONE AO AND ZONE A (WITHOUT BFE)

For Zone AO and Zone A (without BFE), complete Items E1 through E4. If the Elevation Certificate is intended for use as supporting information for a LOMA or LOMR-F, Section C must be completed.

- E1. Building Diagram Number (Select the building diagram most similar to the building for which this certificate is being completed – see pages 6 and 7. If no diagram accurately represents the building, provide a sketch or photograph.)
- E2. The top of the bottom floor (including basement or enclosure) of the building is ___ ft.(m) ___ in.(cm) above or below (check one) the highest adjacent grade. (Use natural grade, if available).
- E3. For Building Diagrams 6-8 with openings (see page 7), the next higher floor or elevated floor (elevation b) of the building is ___ ft.(m) ___ in.(cm) above the highest adjacent grade. Complete items C3.h and C3.i on front of form.
- E4. For Zone AO only: If no flood depth number is available, is the top of the bottom floor elevated in accordance with the community's floodplain management ordinance?
 Yes No Unknown. The local official must certify this information in Section G.

SECTION F - PROPERTY OWNER (OR OWNER'S REPRESENTATIVE) CERTIFICATION

The property owner or owner's authorized representative who completes Sections A, B, C (Items C3.h and C3.i only), and E for Zone A (without a FEMA-issued or community-issued BFE) or Zone AO must sign here. The statements in Sections A, B, C, and E are correct to the best of my knowledge.

PROPERTY OWNER'S OR OWNER'S AUTHORIZED REPRESENTATIVE'S NAME

ADDRESS	CITY	STATE	ZIP CODE
SIGNATURE	DATE	TELEPHONE	

COMMENTS

Check here if attachments

SECTION G - COMMUNITY INFORMATION (OPTIONAL)

The local official who is authorized by law or ordinance to administer the community's floodplain management ordinance can complete Sections A, B, C (or E), and G of this Elevation Certificate. Complete the applicable item(s) and sign below.

- G1. The information in Section C was taken from other documentation that has been signed and embossed by a licensed surveyor, engineer, or architect who is authorized by state or local law to certify elevation information. (Indicate the source and date of the elevation data in the Comments area below.)
- G2. A community official completed Section E for a building located in Zone A (without a FEMA-issued or community-issued BFE) or Zone AO.
- G3. The following information (Items G4-G9) is provided for community floodplain management purposes.

G4. PERMIT NUMBER	G5. DATE PERMIT ISSUED	G6. DATE CERTIFICATE OF COMPLIANCE/OCCUPANCY ISSUED
-------------------	------------------------	---

G7. This permit has been issued for: New Construction Substantial Improvement

G8. Elevation of as-built lowest floor (including basement) of the building is: _____ ft.(m) Datum: _____

G9. BFE or (in Zone AO) depth of flooding at the building site is: _____ ft.(m) Datum: _____


LOCAL OFFICIAL'S NAME	TITLE
COMMUNITY NAME	TELEPHONE
SIGNATURE	DATE
COMMENTS	

Check here if attachments

SURVEY AND ELEVATION

LOT 85 ANTELOPE LAKES UNIT 5
 SEC. 21, T18N, R2W, G & SRB & M,
 YAVAPAI COUNTY, ARIZONA

VALLERI ANN

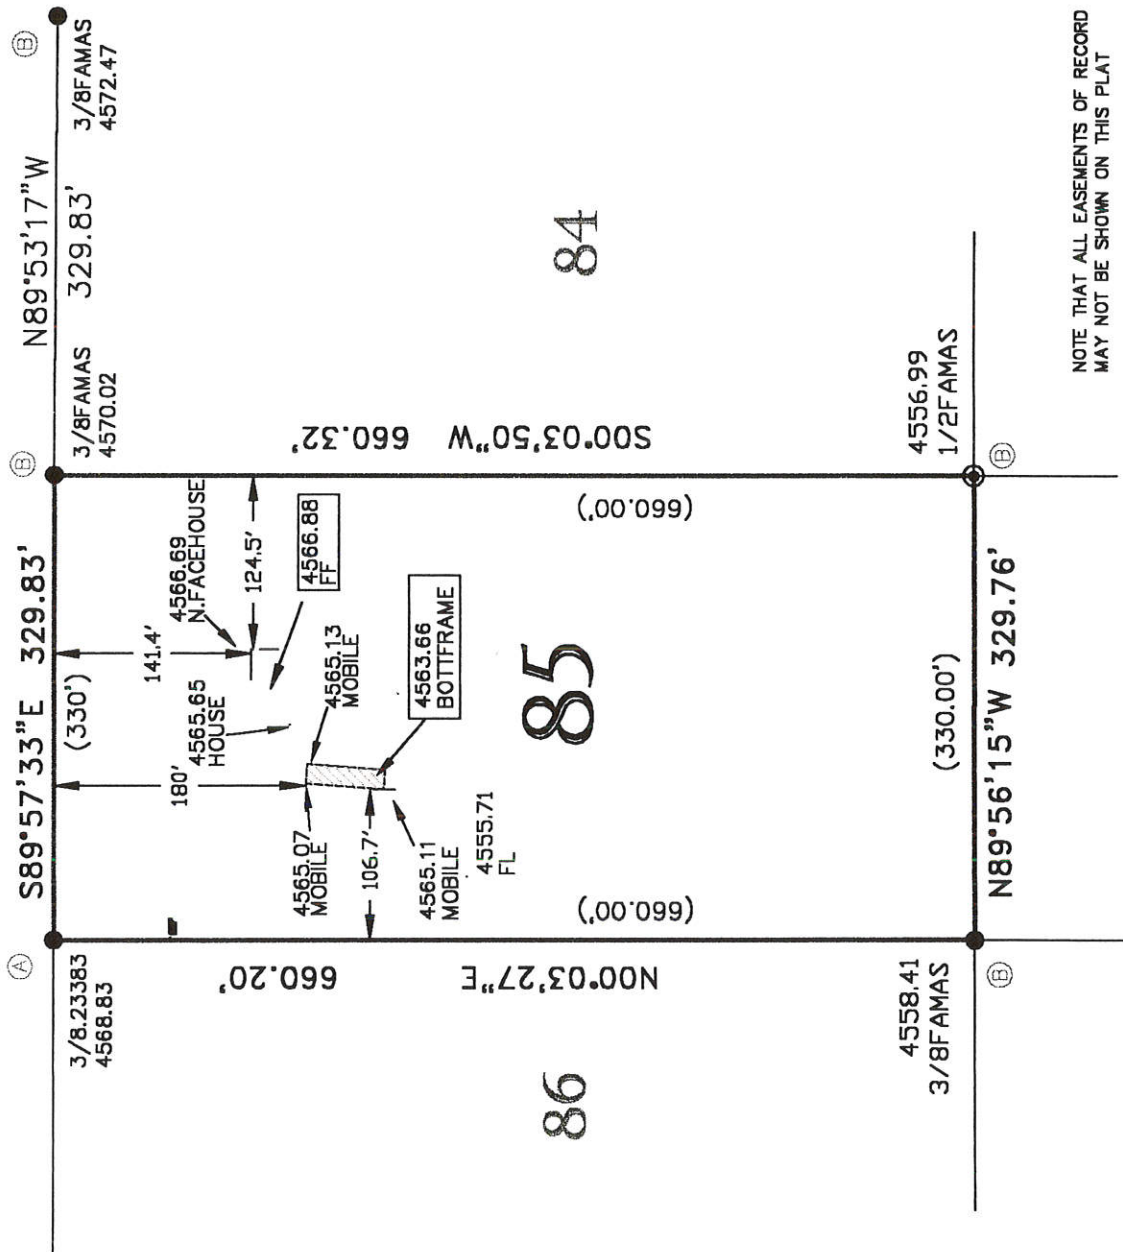

SCALE 1 INCH = 70 FEET



LEGEND


- ⊙ = FOUND 1/2" REBAR OR AS NOTED
- = FOUND 3/8" REBAR OR AS NOTED
- = SET 1/2" REBAR WITH PLASTIC CAP STAMPED " FAMAS "
- * = AFFIXED BRASS TAG " FAMAS "
- () = RECORD INFORMATION
- Ⓐ = FOUND TAGGED RLS 23383
- Ⓑ = FOUND TAGGED FAMAS



FAMAS LAND SURVEYORS, INC.
 P.O. BOX 4357 PRESCOTT, AZ 86302
 PHONE (928)-717-2844 FAX 717-2840

SURVEY FOR: DENNIS McKNIGHT	
DATE DRAWN: 8/5/02	FILE NO.: Y02301
DRAWN BY: DLF	DRAWING: 301Y02

NOTE THAT ALL EASEMENTS OF RECORD
 MAY NOT BE SHOWN ON THIS PLAT

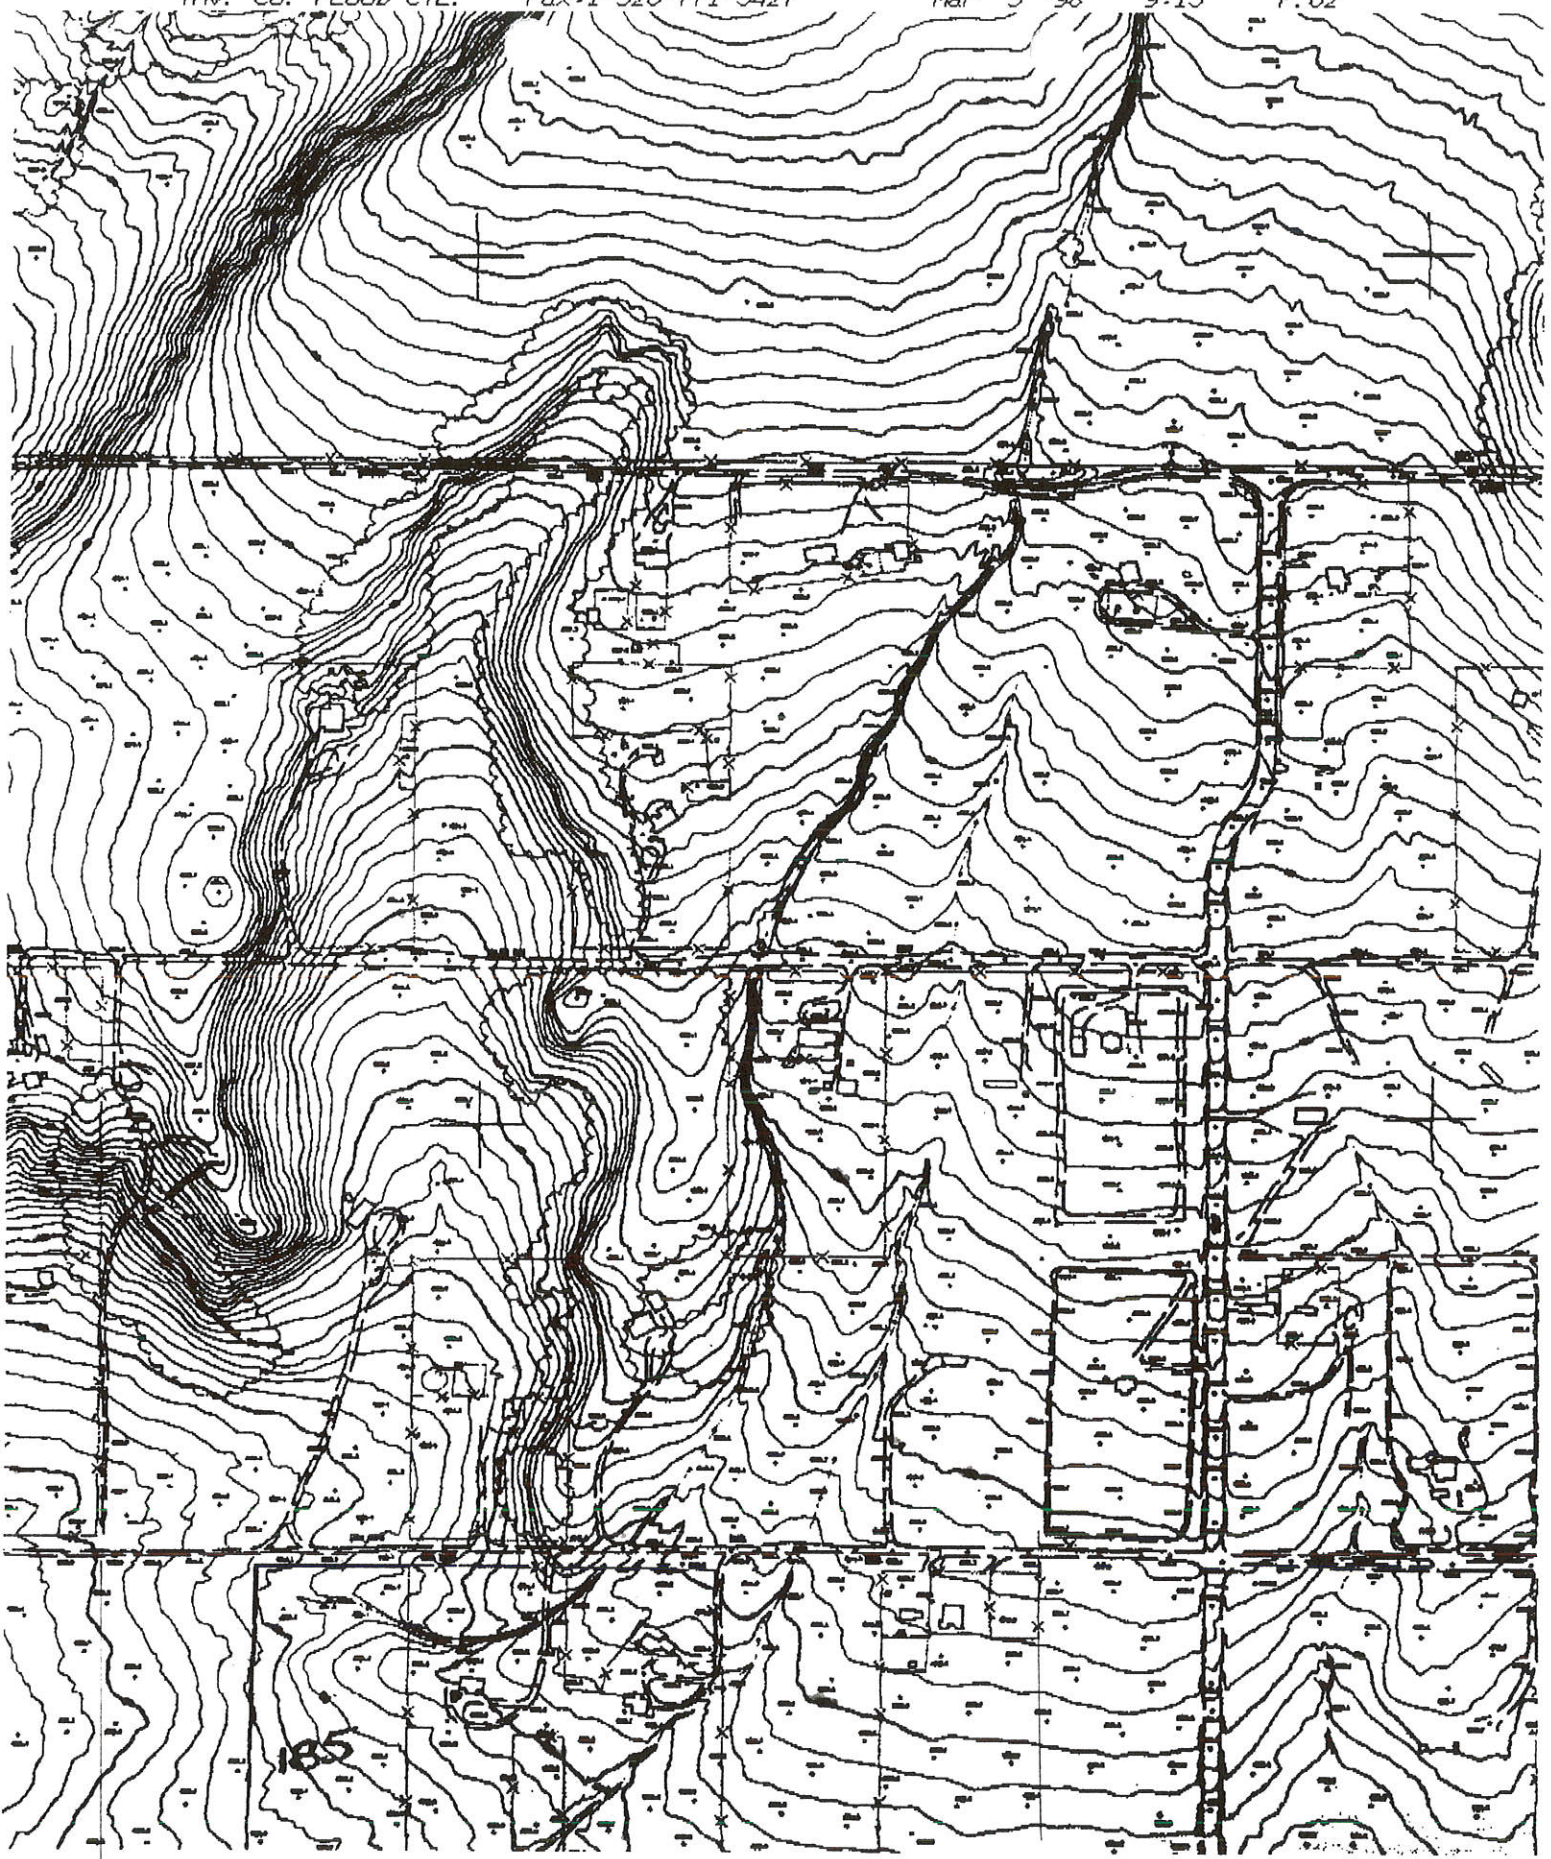

185

4425.95

