

# ELEVATION CERTIFICATE

Important: Read the instructions on pages 1-8.

## SECTION A - PROPERTY INFORMATION

A1. Building Owner's Name <b>Juan Millan and Maria del Rosario</b>		For Insurance Company Use:
A2. Building Street Address (including Apt., Unit, Suite, and/or Bldg. No.) or P.O. Route and Box No. 257 E Bayberry Dr		Policy Number
City : <b>Paulden</b> State <b>AZ</b> ZIP Code <b>86334</b>		Company NAIC Number

A3. Property Description (Lot and Block Numbers, Tax Parcel Number, Legal Description, etc.)  
**305-03-010**

A4. Building Use (e.g., Residential, Non-Residential, Addition, Accessory, etc.) **Residential - Sub MH Home**

A5. Latitude/Longitude: Lat. 34 54'36.3223 Long. 112 27'57.4669

Horizontal Datum:  NAD 1927  NAD 1983

A6. Attach at least 2 photographs of the building if the Certificate is being used to obtain flood insurance.

A7. Building Diagram Number 8

A8. For a building with a crawl space or enclosure(s), provide

- a) Square footage of crawl space or enclosure(s) 1,400 sq ft  
b) No. of permanent flood openings in the crawl space or enclosure(s) walls within 1.0 foot above adjacent grade 14  
c) Total net area of flood openings in A8.b 1,400 sq in

A9. For a building with an attached garage, provide:

- a) Square footage of attached garage NA sq ft  
b) No. of permanent flood openings in the attached garage walls within 1.0 foot above adjacent grade NA  
c) Total net area of flood openings in A9.b NA sq in

## SECTION B - FLOOD INSURANCE RATE MAP (FIRM) INFORMATION

B1. NFIP Community Name & Community Number <b>:Yavapai County 040093</b>		B2. County Name <b>:Yavapai</b>		B3. State <b>AZ</b>	
B4. Map/Panel Number <b>04025C0900</b>	B5. Suffix <b>F</b>	B6. FIRM Index Date <b>6-6-01</b>	B7. FIRM Panel Effective/Revised Date <b>6-6-01</b>	B8. Flood Zone(s) <b>AE</b>	B9. Base Flood Elevation(s) (Zone AO, use base flood depth) <b>4444.8'</b>

B10. Indicate the source of the Base Flood Elevation (BFE) data or base flood depth entered in Item B9.

- FIS Profile  FIRM  Community Determined  Other (Describe) \_\_\_\_\_

B11. Indicate elevation datum used for BFE in Item B9:  NGVD 1929  NAVD 1988  Other (Describe) \_\_\_\_\_

B12. Is the building located in a Coastal Barrier Resources System (CBRS) area or Otherwise Protected Area (OPA)?  Yes  No  
Designation Date \_\_\_\_\_  CBRS  OPA

## SECTION C - BUILDING ELEVATION INFORMATION (SURVEY REQUIRED)

C1. Building elevations are based on:  Construction Drawings\*  Building Under Construction\*  Finished Construction

\*A new Elevation Certificate will be required when construction of the building is complete.

C2. Elevations - Zones A1-A30, AE, AH, A (with BFE), VE, V1-V30, V (with BFE), AR, AR/A, AR/AE, AR/A1-A30, AR/AH, AR/AO. Complete Items C2.a-g below according to the building diagram specified in Item A7.

Benchmark Utilized RM24 Vertical Datum 4455.79'

Conversion/Comments \_\_\_\_\_

Check the measurement used.


- a) Top of bottom floor (including basement, crawl space, or enclosure floor) 4444.0  feet  meters (Puerto Rico only)  
b) Top of the next higher floor 4447.7  feet  meters (Puerto Rico only)  
c) Bottom of the lowest horizontal structural member (V Zones only) N/A  feet  meters (Puerto Rico only)  
d) Attached garage (top of slab) N/A  feet  meters (Puerto Rico only)  
e) Lowest elevation of machinery or equipment servicing the building 4447.4  feet  meters (Puerto Rico only)  
(Describe type of equipment in Comments)  
f) Lowest adjacent (finished) grade (LAG) 4443.8  feet  meters (Puerto Rico only)  
g) Highest adjacent (finished) grade (HAG) 4444.2  feet  meters (Puerto Rico only)

## SECTION D - SURVEYOR, ENGINEER, OR ARCHITECT CERTIFICATION

This certification is to be signed and sealed by a land surveyor, engineer, or architect authorized by law to certify elevation information. I certify that the information on this Certificate represents my best efforts to interpret the data available. I understand that any false statement may be punishable by fine or imprisonment under 18 U.S. Code, Section 1001.

Check here if comments are provided on back of form.

Certifier's Name **DALE FAMAS** License Number **AZ LS27738**  
Title **LAND SURVEYOR** Company Name **EMPIRE SURVEYING**  
Address **PO BOX 67** City **PAULDEN** State **AZ** ZIP Code **86334**

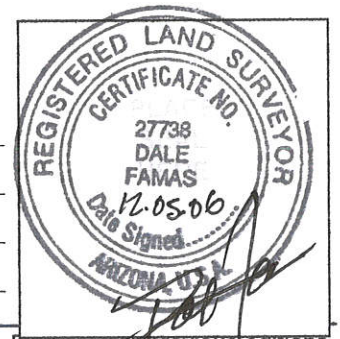

<b>IMPORTANT: In these spaces, copy the corresponding information from Section A.</b>	For Insurance Company Use:
Building Street Address (including Apt., Unit, Street and/or Bldg. No.) or P.O. Route and Box No. 257 E. BAYBERRY	Policy Number
City PAULDEN StateAZZIP Code 86334	Company NAIC Number

**SECTION D - SURVEYOR, ENGINEER, OR ARCHITECT CERTIFICATION (CONTINUED)**

Copy both sides of this Elevation Certificate for (1) community official, (2) insurance agent/company, and (3) building owner.

Comments MANUFACTURED HOME ON CINDERBLOCK SKIRTING BOTTOM FRAME E=4446.6'  
AC UNIT E=4447.4'  
BOTTOM ELECTRIC METER PANEL E=4448.6'

Signature

Date 12-05-06

Check here if attachments

**SECTION E - BUILDING ELEVATION INFORMATION (SURVEY NOT REQUIRED) FOR ZONE AO AND ZONE A (WITHOUT BFE)**

For Zones AO and A (without BFE), complete Items E1-E5. If the Certificate is intended to support a LOMA or LOMR-F request, complete Sections A, B, and C. For Items E1-E4, use natural grade, if available. Check the measurement used. In Puerto Rico only, enter meters.

- E1. Provide elevation information for the following and check the appropriate boxes to show whether the elevation is above or below the highest adjacent grade (HAG) and the lowest adjacent grade (LAG).  
 a) Top of bottom floor (including basement, crawl space, or enclosure) is \_\_\_\_\_  feet  meters  above or  below the HAG.  
 b) Top of bottom floor (including basement, crawl space, or enclosure) is \_\_\_\_\_  feet  meters  above or  below the LAG.
- E2. For Building Diagrams 6-8 with permanent flood openings provided in Section A Items 8 and/or 9 (see page 8 of Instructions), the next higher floor (elevation C2.b in the diagrams) of the building is \_\_\_\_\_  feet  meters  above or  below the HAG.
- E3. Attached garage (top of slab) is \_\_\_\_\_  feet  meters  above or  below the HAG.
- E4. Top of platform of machinery and/or equipment servicing the building is \_\_\_\_\_  feet  meters  above or  below the HAG.
- E5. Zone AO only: If no flood depth number is available, is the top of the bottom floor elevated in accordance with the community's floodplain management ordinance?  Yes  No  Unknown. The local official must certify this information in Section G.

**SECTION F - PROPERTY OWNER (OR OWNER'S REPRESENTATIVE) CERTIFICATION**

The property owner or owner's authorized representative who completes Sections A, B, and E for Zone A (without a FEMA-issued or community-issued BFE) or Zone AO must sign here. *The statements in Sections A, B, and E are correct to the best of my knowledge.*

Property Owner's or Owner's Authorized Representative's Name

Address	City	State	ZIP Code
Signature	Date	Telephone	
Comments			

Check here if attachments

**SECTION G - COMMUNITY INFORMATION (OPTIONAL)**

The local official who is authorized by law or ordinance to administer the community's floodplain management ordinance can complete Sections A, B, C (or E), and G of this Elevation Certificate. Complete the applicable item(s) and sign below. Check the measurement used in Items G8. and G9.

- G1.  The information in Section C was taken from other documentation that has been signed and sealed by a licensed surveyor, engineer, or architect who is authorized by law to certify elevation information. (Indicate the source and date of the elevation data in the Comments area below.)
- G2.  A community official completed Section E for a building located in Zone A (without a FEMA-issued or community-issued BFE) or Zone AO.
- G3.  The following information (Items G4.-G9.) is provided for community floodplain management purposes.

G4. Permit Number	G5. Date Permit Issued	G6. Date Certificate Of Compliance/Occupancy Issued
-------------------	------------------------	---

G7. This permit has been issued for:  New Construction  Substantial Improvement

G8. Elevation of as-built lowest floor (including basement) of the building: \_\_\_\_\_  feet  meters (PR) Datum \_\_\_\_\_

G9. BFE or (in Zone AO) depth of flooding at the building site: \_\_\_\_\_  feet  meters (PR) Datum \_\_\_\_\_

Local Official's Name	Title
Community Name	Telephone
Signature	Date
Comments	

Check here if attachments

# ELEVATION CERTIFICATE SKETCH

## LOT 10 ANTELOPE LAKES UNIT 2



SEC. 27, T18N, R2W, G & SRB & M., YAVAPAI COUNTY, ARIZONA

DATE OF SURVEY

DEC 2006

DRAWING SCALE

1 IN = 50 FT

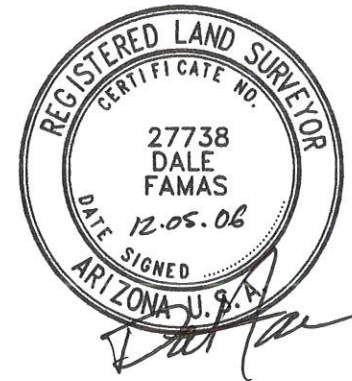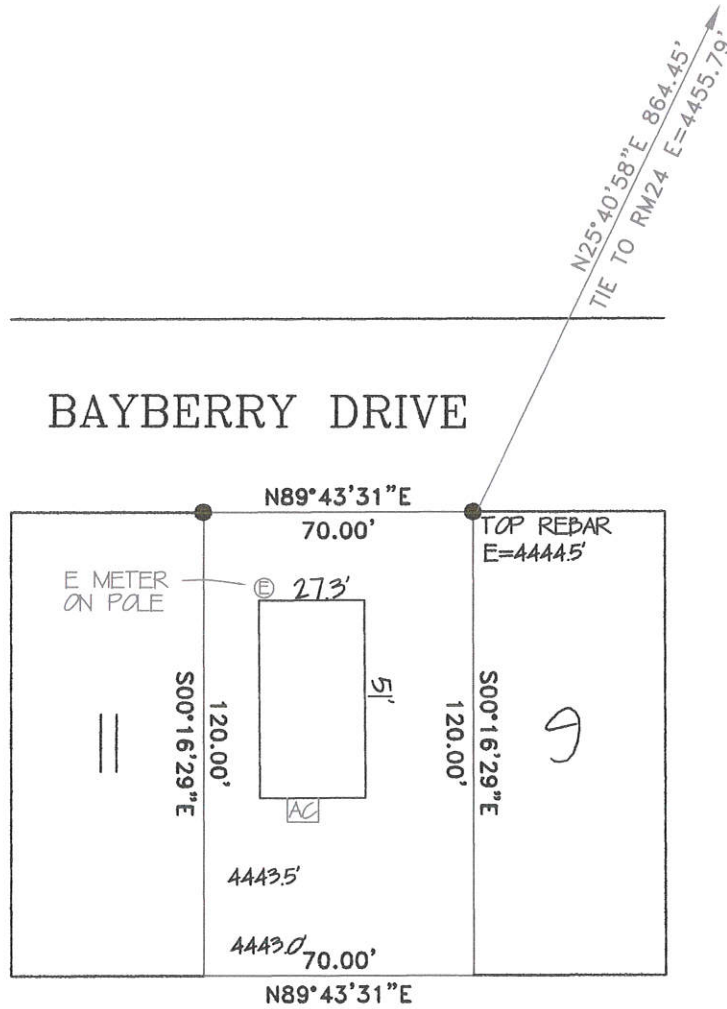

DATUM PER 0401560990F  
 ELEVATION DATA USING RM24 E=4455.79'

MANUFACTURED HOME ON CINDERBLOCK SKIRTING  
 BOTTOM FRAME E=4446.6'  
 BOTTOM AC UNIT E=4447.4'  
 BOTTOM E PANEL E=4448.6'  
 AREA OF FLOOD VENTS =1,400 SQ.IN.

**EMPIRE SURVEYING, INC.**

P.O. BOX 67, PAULDEN, AZ 86334  
 PHONE (928)-636-6992 FAX 636-6993

DRAWN BY: DEF FILE NO.: 260Y06

● = 1/2" REBAR

# Building Photographs

See Instructions for Item A6.

For Insurance Company Use:

Building Street Address (including Apt., Unit, Suite, and/or Bldg. No.) or P.O. Route and Box No.  
257 E. BAYBERRY

Policy Number

City PAULDEN State AZ ZIP Code 86334

Company NAIC Number

If using the Elevation Certificate to obtain NFIP flood insurance, affix at least two building photographs below according to the instructions for Item A6. Identify all photographs with: date taken; "Front View" and "Rear View"; and, if required, "Right Side View" and "Left Side View." If submitting more photographs than will fit on this page, use the Continuation Page, following.

