

### ELEVATION CERTIFICATE

Important: Read the instructions on pages 1 - 7.

#### SECTION A - PROPERTY OWNER INFORMATION

|  |                    |  |  |
|--|--------------------|--|--|
| BUILDING OWNER'S NAME<br><i>Karen Moore or Brenda Allen</i>  |                    | For Insurance Company Use:   |  |
| BUILDING STREET ADDRESS (Including Apt., Unit, Suite, and/or Bldg. No.) OR P.O. ROUTE AND BOX NO.<br><i>25345 N Cedar Dr</i>       |                    | Policy Number  |  |
| CITY<br><i>Paulden</i>   | STATE<br><i>AZ</i> | ZIP CODE   |  |
| PROPERTY/DESCRIPTION (Lot and Block Numbers, Tax Parcel Number, Legal Description, etc.)<br><i>Apr 305-03-461</i>                  |                    |  |  |
| BUILDING USE (e.g., Residential, Non-residential, Addition, Accessory, etc. Use Comments area if necessary.)<br><i>Residential</i> |                    |  |  |
| LATITUDE/LONGITUDE (OPTIONAL)<br>(##° - ##' - ##.###" or ##.#####")  |                    | HORIZONTAL DATUM: <input type="checkbox"/> NAD 1927 <input type="checkbox"/> NAD 1983  |  |
|  |                    | SOURCE: <input type="checkbox"/> GPS (Type: _____)<br><input type="checkbox"/> USGS Quad Map <input type="checkbox"/> Other: _____ |  |

#### SECTION B - FLOOD INSURANCE RATE MAP (FIRM) INFORMATION

|  |                        |                                      |  |                              |  |
|--|------------------------|--------------------------------------|--|------------------------------|--|
| B1. NFIP COMMUNITY NAME & COMMUNITY NUMBER<br><i>Yavapai County 040093</i> |                        | B2. COUNTY NAME<br><i>Yavapai</i>    |  | B3. STATE<br><i>AZ</i>       |  |
| B4. MAP AND PANEL NUMBER<br><i>04025C0990</i>                              | B5. SUFFIX<br><i>F</i> | B6. FIRM INDEX DATE<br><i>6-6-01</i> | B7. FIRM PANEL EFFECTIVE/REVISED DATE<br><i>6-6-01</i> | B8. FLOOD ZONES<br><i>AE</i> | B9. BASE FLOOD ELEVATION(S)<br><i>4468.7</i> |

B10. Indicate the source of the Base Flood Elevation (BFE) data or base flood depth entered in B9.

FIS Profile  FIRM  Community Determined  Other (Describe): \_\_\_\_\_

B11. Indicate the elevation datum used for the BFE in B9:  NGVD 1929  NAVD 1988  Other (Describe): \_\_\_\_\_

B12. Is the building located in a Coastal Barrier Resources System (CBRS) area or Otherwise Protected Area (OPA)?  Yes  No  
Designation Date: \_\_\_\_\_

#### SECTION C - BUILDING ELEVATION INFORMATION (SURVEY REQUIRED)

C1. Building elevations are based on:  Construction Drawings\*  Building Under Construction\*  Finished Construction  
\*A new Elevation Certificate will be required when construction of the building is complete.

C2. Building Diagram Number *6* (Select the building diagram most similar to the building for which this certificate is being completed - see pages 6 and 7. If no diagram accurately represents the building, provide a sketch or photograph.)

C3. Elevations - Zones A1-A30, AE, AH, A (with BFE), VE, V1-V30, V (with BFE), AR, AR/A, AR/AE, AR/A1-A30, AR/AH, AR/AO  
Complete Items C3.a-i below according to the building diagram specified in Item C2. State the datum used. If the datum is different from the datum used for the BFE in Section B, convert the datum to that used for the BFE. Show field measurements and datum conversion calculation. Use the space provided or the Comments area of Section D or Section G, as appropriate, to document the datum conversion.  
Datum \_\_\_\_\_ Conversion/Comments \_\_\_\_\_

Elevation reference mark used *Rm 24* Does the elevation reference mark used appear on the FIRM?  Yes  No

- a) Top of bottom floor (including basement or enclosure) *4470.07* ft.(m)
- b) Top of next higher floor *N/A* ft.(m)
- c) Bottom of lowest horizontal structural member (V zones only) *N/A* ft.(m)
- d) Attached garage (top of slab) *N/A* ft.(m)
- e) Lowest elevation of machinery and/or equipment servicing the building (Describe in a Comments area.) *N/A* ft.(m)
- f) Lowest adjacent (finished) grade (LAG) *4466.73* ft.(m)
- g) Highest adjacent (finished) grade (HAG) *4467.26* ft.(m)
- h) No. of permanent openings (flood vents) within 1 ft. above adjacent grade *N/A*
- i) Total area of all permanent openings (flood vents) in C3.h *N/A* sq. in. (sq. cm)

License Number, Embossed Seal, Signature, and Date



#### SECTION D - SURVEYOR, ENGINEER, OR ARCHITECT CERTIFICATION

This certification is to be signed and sealed by a land surveyor, engineer, or architect authorized by law to certify elevation information. I certify that the information in Sections A, B, and C on this certificate represents my best efforts to interpret the data available. I understand that any false statement may be punishable by fine or imprisonment under 18 U.S. Code, Section 1001.

|  |                                |   |                          |
|--|--------------------------------|---|--------------------------|
| CERTIFIER'S NAME<br><i>Lauri Hopps</i>   |                                | LICENSE NUMBER<br><i>33876</i>              |                          |
| TITLE<br><i>Registered Land Surveyor</i> |                                | COMPANY NAME<br><i>Advanced Surveys Inc</i> |                          |
| ADDRESS<br><i>PO BOX 24031</i>           | CITY<br><i>Prescott Valley</i> | STATE<br><i>AZ</i>                          | ZIP CODE<br><i>86312</i> |
| SIGNATURE<br><i>Lauri Hopps</i>          | DATE<br><i>6-30-05</i>         | TELEPHONE<br><i>928 772-4716</i>            |                          |



|  |       |          |                            |
|--|-------|----------|----------------------------|
| <b>IMPORTANT: In these spaces, copy the corresponding information from Section A.</b>                                |       |          | For Insurance Company Use: |
| BUILDING STREET ADDRESS (Including Apt., Suite, and/or Bldg. No.) OR P.O. ROUTE AND BOX NO.<br><i>APN. 305-03-46</i> |       |          | Policy Number              |
| CITY   | STATE | ZIP CODE | Company NAIC Number        |

**SECTION D - SURVEYOR, ENGINEER, OR ARCHITECT CERTIFICATION (CONTINUED)**

Copy both sides of this Elevation Certificate for (1) community official, (2) insurance agent/company, and (3) building owner.

COMMENTS *I-Beam Elev. 4468.7'*

---

Check here if attachments

**SECTION E - BUILDING ELEVATION INFORMATION (SURVEY NOT REQUIRED) FOR ZONE AO AND ZONE A (WITHOUT BFE)**

For Zone AO and Zone A (without BFE), complete Items E1. through E4. If the Elevation Certificate is intended for use as supporting information for a LOMA or LOMR-F, Section C must be completed.

- E1. Building Diagram Number \_\_\_\_\_ (Select the building diagram most similar to the building for which this certificate is being completed – see pages 6 and 7. If no diagram accurately represents the building, provide a sketch or photograph.)
- E2. The top of the bottom floor (including basement or enclosure) of the building is \_\_\_\_\_ ft.(m) \_\_\_\_\_ in.(cm) \_\_\_\_\_ above or \_\_\_\_\_ below (check one) the highest adjacent grade. (Use natural grade, if available.)
- E3. For Building Diagrams 6-8 with openings (see page 7), the next higher floor or elevated floor (elevation b) of the building is \_\_\_\_\_ ft.(m) \_\_\_\_\_ in.(cm) above the highest adjacent grade.
- E4. The top of the platform of machinery and/or equipment servicing the building is \_\_\_\_\_ ft. (m) \_\_\_\_\_ in. (cm) \_\_\_\_\_ above or \_\_\_\_\_ below (check one) the highest adjacent grade. (Use natural grade, if available.)
- E5. For Zone AO only: If no flood depth number is available, is the top of the bottom floor elevated in accordance with the community's floodplain management ordinance?  Yes  No  Unknown. The local official must certify this information in Section G.

**SECTION F - PROPERTY OWNER (OR OWNER'S REPRESENTATIVE) CERTIFICATION**

The property owner or owner's authorized representative who completes Sections A, B, C (Items C3.h and C3.i only), and E for Zone A (without a FEMA-issued or community-issued BFE) or Zone AO must sign here. The statements in Sections A, B, C, and E are correct to the best of my knowledge.

PROPERTY OWNER'S OR OWNER'S AUTHORIZED REPRESENTATIVE'S NAME \_\_\_\_\_

|           |      |           |          |
|-----------|------|-----------|----------|
| ADDRESS   | CITY | STATE     | ZIP CODE |
| SIGNATURE | DATE | TELEPHONE |          |

COMMENTS \_\_\_\_\_

Check here if attachments

**SECTION G - COMMUNITY INFORMATION (OPTIONAL)**

The local official who is authorized by law or ordinance to administer the community's floodplain management ordinance can complete Sections A, B, C (or E), and G of this Elevation Certificate. Complete the applicable item(s) and sign below.

- G1.  The information in Section C was taken from other documentation that has been signed and embossed by a licensed surveyor, engineer, or architect who is authorized by state or local law to certify elevation information. (Indicate the source and date of the elevation data in the Comments area below.)
- G2.  A community official completed Section E for a building located in Zone A (without a FEMA-issued or community-issued BFE) or Zone AO.
- G3.  The following information (Items G4-G9) is provided for community floodplain management purposes.

|                   |                        |   |
|-------------------|------------------------|---|
| G4. PERMIT NUMBER | G5. DATE PERMIT ISSUED | G6. DATE CERTIFICATE OF COMPLIANCE/OCCUPANCY ISSUED |
|-------------------|------------------------|---|

- G7. This permit has been issued for:  New Construction  Substantial Improvement
- G8. Elevation of as-built lowest floor (including basement) of the building is: \_\_\_\_\_ . \_\_\_\_\_ ft.(m) Datum: \_\_\_\_\_
- G9. BFE or (in Zone AO) depth of flooding at the building site is: \_\_\_\_\_ . \_\_\_\_\_ ft.(m) Datum: \_\_\_\_\_

|                       |           |
|-----------------------|-----------|
| LOCAL OFFICIAL'S NAME | TITLE     |
| COMMUNITY NAME        | TELEPHONE |
| SIGNATURE             | DATE      |
| COMMENTS _____        |           |

Check here if attachments



# ELEVATION OF FLOODPLAIN PROPERTY

When Completed Return To: YAVAPAI COUNTY DEVELOPMENT SERVICES - FLOODPLAIN UNIT

500 S. Marina St., Prescott, AZ, 86303 (928) 771-3197 FAX (928) 771-3427 Office: Prescott \_\_\_\_\_  
10 S. 6<sup>th</sup> St., Cottonwood, AZ 86326 (928) 639-8151 FAX (928) 639-8118 Cottonwood \_\_\_\_\_

DATE 2-22-05

ASSESSOR'S PARCEL NUMBER 305-03-461

SUBDIVISION NAME UNIT/PHASE AND LOT NUMBER Antelope Lakes #2 Lot 461

OWNER Karen K Moore / Patrick Dale

SITUS ADDRESS 25345 N. Cedar Dr.

BASE BENCHMARK: Number Rm 24 Elevation 4455.79'

PROPERTY BENCHMARK 4466.70'

DESCRIPTION OF PROPERTY BENCHMARK NE Prop Cor. 1/2" RB 37930 Lot 461

GROUND ELEVATIONS AT BUILDING SITE 4463.62, 4464.09, 4465.52  
(Please provide a minimum of three (3) elevation points, representative of the site)

Sketch of Lot (include location of property benchmark and building site elevations) \_\_\_\_\_  
Remarks \_\_\_\_\_

*see attached sketch.*



Signed Lauri Hopps  
Company Name Advanced Surveys, Inc  
Address PO Box 26031 Prescott Valley, AZ 86312  
Telephone 928-772-4716

(Seal)

FOR YAVAPAI COUNTY FLOOD CONTROL DISTRICT USE: Date: \_\_\_\_\_

Base Flood Elevation 4468.7' + 1.0' = Regulatory Elevation 4469.7'



\* ELEVATION DETERMINATIONS ARE BASED ON BEST AVAILABLE DATA WHEN CALCULATED. ELEVATIONS ARE SUBJECT TO CHANGE WHEN NEW OR REVISED FLOOD STUDIES OR DATA IS SUPPLIED TO THE DISTRICT.

# Advanced Surveys

Gary McCorkle, RLS

INC

Lauri Hopps, RLS

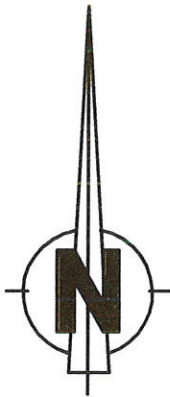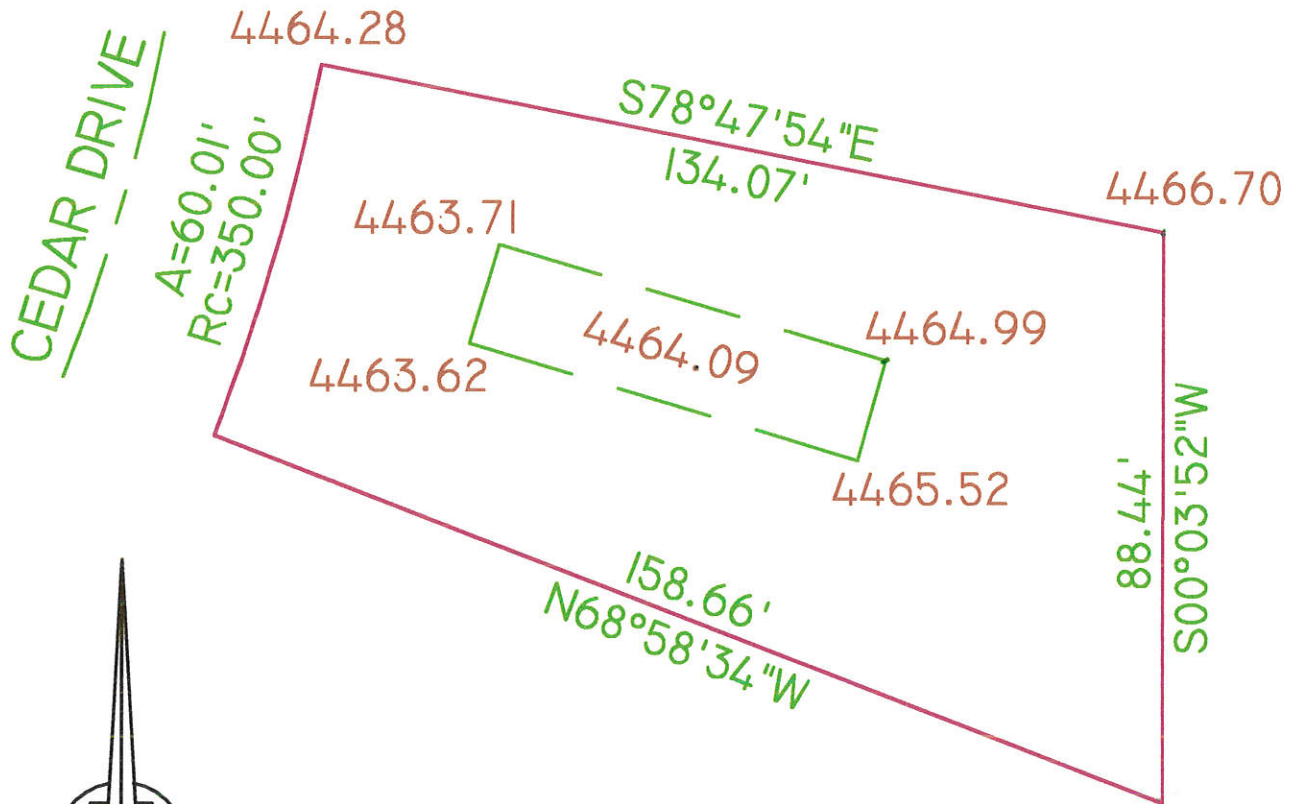

SCALE: 1"=30'

P.O. Box 26031 Prescott Valley, AZ 86312

Voice 928-772-4716

Mobile 928-713-2237

Fax 928-772-4716

rls@commspeed.net