

ELEVATION CERTIFICATE

OMB No. 1660-0008
Expires February 28, 2009

Important: Read the instructions on pages 1-8.

SECTION A - PROPERTY INFORMATION

A1. Building Owner's Name Kenneth & Betty Whitaker		For Insurance Company Use:
A2. Building Street Address (including Apt., Unit, Suite, and/or Bldg. No.) or P.O. Route and Box No. 675 S. Equestrian Trail		Policy Number
City Chino Valley State AZ ZIP Code 86323		Company NAIC Number
A3. Property Description (Lot and Block Numbers, Tax Parcel Number, Legal Description, etc.) Tax Parcel Number 306-02-510X <u>now 524B</u>		
A4. Building Use (e.g., Residential, Non-Residential, Addition, Accessory, etc.) <u>Residential Site Built Home</u>		
A5. Latitude/Longitude: Lat. <u>34°44'07.7"</u> Long. <u>112°29'33.5"</u>		Horizontal Datum: <input type="checkbox"/> NAD 1927 <input checked="" type="checkbox"/> NAD 1983
A6. Attach at least 2 photographs of the building if the Certificate is being used to obtain flood insurance.		
A7. Building Diagram Number <u>1</u>		
A8. For a building with a crawl space or enclosure(s), provide		A9. For a building with an attached garage, provide:
a) Square footage of crawl space or enclosure(s) <u>n/a</u> sq ft		a) Square footage of attached garage <u>493.5</u> sq ft
b) No. of permanent flood openings in the crawl space or enclosure(s) walls within 1.0 foot above adjacent grade <u>n/a</u>		b) No. of permanent flood openings in the attached garage walls within 1.0 foot above adjacent grade <u>n/a</u>
c) Total net area of flood openings in A8.b <u>n/a</u> sq in		c) Total net area of flood openings in A9.b <u>n/a</u> sq in

SECTION B - FLOOD INSURANCE RATE MAP (FIRM) INFORMATION

B1. NFIP Community Name & Community Number Yavapai County - 040093		B2. County Name Yavapai		B3. State Arizona	
B4. Map/Panel Number 04025C01705	B5. Suffix F	B6. FIRM Index Date 6/6/01	B7. FIRM Panel Effective/Revised Date 6/6/01	B8. Flood Zone(s) AE	B9. Base Flood Elevation(s) (Zone AO, use base flood depth) 4794.6

B10. Indicate the source of the Base Flood Elevation (BFE) data or base flood depth entered in Item B9.
 FIS Profile FIRM Community Determined Other (Describe) _____

B11. Indicate elevation datum used for BFE in Item B9: NGVD 1929 NAVD 1988 Other (Describe) _____

B12. Is the building located in a Coastal Barrier Resources System (CBRS) area or Otherwise Protected Area (OPA)? Yes No
 Designation Date _____ CBRS OPA

SECTION C - BUILDING ELEVATION INFORMATION (SURVEY REQUIRED)

C1. Building elevations are based on: Construction Drawings* Building Under Construction* Finished Construction
 *A new Elevation Certificate will be required when construction of the building is complete.

C2. Elevations - Zones A1-A30, AE, AH, A (with BFE), VE, V1-V30, V (with BFE), AR, AR/A, AR/AE, AR/A1-A30, AR/AH, AR/AO. Complete Items C2.a-g below according to the building diagram specified in Item A7.
 Benchmark Utilized RM 78 Vertical Datum 4808.67' NGVD 1929
 Conversion/Comments n/a

Check the measurement used.

a) Top of bottom floor (including basement, crawl space, or enclosure floor) 4805.69 feet meters (Puerto Rico only)

b) Top of the next higher floor n/a feet meters (Puerto Rico only)

c) Bottom of the lowest horizontal structural member (V Zones only) n/a feet meters (Puerto Rico only)

d) Attached garage (top of slab) 4805.40 feet meters (Puerto Rico only)

e) Lowest elevation of machinery or equipment servicing the building (Describe type of equipment in Comments) 4804.02 feet meters (Puerto Rico only)

f) Lowest adjacent (finished) grade (LAG) 4800.85 feet meters (Puerto Rico only)


g) Highest adjacent (finished) grade (HAG) 4805.18 feet meters (Puerto Rico only)

SECTION D - SURVEYOR, ENGINEER, OR ARCHITECT CERTIFICATION

This certification is to be signed and sealed by a land surveyor, engineer, or architect authorized by law to certify elevation information. I certify that the information on this Certificate represents my best efforts to interpret the data available. I understand that any false statement may be punishable by fine or imprisonment under 18 U.S. Code, Section 1001.

Check here if comments are provided on back of form.

Certifier's Name Lauri Hopps		License Number 33876	
Title Registered Land Surveyor	Company Name Advanced Surveys, Inc.		
Address P.O. Box 26031	City Prescott Valley	State AZ	ZIP Code 86312
Signature <u>Lauri Hopps</u>	Date 4/27/07	Telephone 928-772-4716	

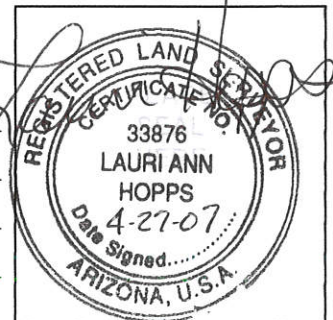

IMPORTANT: In these spaces, copy the corresponding information from Section A.	For Insurance Company Use:
Building Street Address (including Apt., Unit, S. and/or Bldg. No.) or P.O. Route and Box No. 675 S Equestrian Trail	Policy Number
City Chino Valley State AZ ZIP Code 86323	Company NAIC Number

SECTION D - SURVEYOR, ENGINEER, OR ARCHITECT CERTIFICATION (CONTINUED)

Copy both sides of this Elevation Certificate for (1) community official, (2) insurance agent/company, and (3) building owner.

Comments C2e. Heat Pump

Signature 

Date 4/27/07

Check here if attachments

SECTION E - BUILDING ELEVATION INFORMATION (SURVEY NOT REQUIRED) FOR ZONE AO AND ZONE A (WITHOUT BFE)

For Zones AO and A (without BFE), complete Items E1-E5. If the Certificate is intended to support a LOMA or LOMR-F request, complete Sections A, B, and C. For Items E1-E4, use natural grade, if available. Check the measurement used. In Puerto Rico only, enter meters.

- E1. Provide elevation information for the following and check the appropriate boxes to show whether the elevation is above or below the highest adjacent grade (HAG) and the lowest adjacent grade (LAG).
- a) Top of bottom floor (including basement, crawl space, or enclosure) is _____ feet meters above or below the HAG.
- b) Top of bottom floor (including basement, crawl space, or enclosure) is _____ feet meters above or below the LAG.
- E2. For Building Diagrams 6-8 with permanent flood openings provided in Section A Items 8 and/or 9 (see page 8 of Instructions), the next higher floor (elevation C2.b in the diagrams) of the building is _____ feet meters above or below the HAG.
- E3. Attached garage (top of slab) is _____ feet meters above or below the HAG.
- E4. Top of platform of machinery and/or equipment servicing the building is _____ feet meters above or below the HAG.
- E5. Zone AO only: If no flood depth number is available, is the top of the bottom floor elevated in accordance with the community's floodplain management ordinance? Yes No Unknown. The local official must certify this information in Section G.

SECTION F - PROPERTY OWNER (OR OWNER'S REPRESENTATIVE) CERTIFICATION

The property owner or owner's authorized representative who completes Sections A, B, and E for Zone A (without a FEMA-issued or community-issued BFE) or Zone AO must sign here. *The statements in Sections A, B, and E are correct to the best of my knowledge.*

Property Owner's or Owner's Authorized Representative's Name _____

Address _____	City _____	State _____	ZIP Code _____
Signature _____	Date _____	Telephone _____	
Comments _____			

Check here if attachments

SECTION G - COMMUNITY INFORMATION (OPTIONAL)

The local official who is authorized by law or ordinance to administer the community's floodplain management ordinance can complete Sections A, B, C (or E), and G of this Elevation Certificate. Complete the applicable item(s) and sign below. Check the measurement used in Items G8. and G9.

- G1. The information in Section C was taken from other documentation that has been signed and sealed by a licensed surveyor, engineer, or architect who is authorized by law to certify elevation information. (Indicate the source and date of the elevation data in the Comments area below.)
- G2. A community official completed Section E for a building located in Zone A (without a FEMA-issued or community-issued BFE) or Zone AO.
- G3. The following information (Items G4.-G9.) is provided for community floodplain management purposes.

G4. Permit Number _____	G5. Date Permit Issued _____	G6. Date Certificate Of Compliance/Occupancy Issued _____
-------------------------	------------------------------	---

- G7. This permit has been issued for: New Construction Substantial Improvement
- G8. Elevation of as-built lowest floor (including basement) of the building: _____ feet meters (PR) Datum _____
- G9. BFE or (in Zone AO) depth of flooding at the building site: _____ feet meters (PR) Datum _____

Local Official's Name _____	Title _____
Community Name _____	Telephone _____
Signature _____	Date _____
Comments _____	

Check here if attachments

Building Photographs

See Instructions for Item A6.

Building Street Address (including Apt., Unit, Suite, and/or Bldg. No.) or P.O. Route and Box No. 675 S. Equestrian Trail	For Insurance Company Use:
City Chino Valley State AZ ZIP Code 86323	Policy Number
	Company NAIC Number

If using the Elevation Certificate to obtain NFIP flood insurance, affix at least two building photographs below according to the instructions for Item A6. Identify all photographs with: date taken; "Front View" and "Rear View"; and, if required, "Right Side View" and "Left Side View." If submitting more photographs than will fit on this page, use the Continuation Page, following.



Building Photographs

Continuation Page

Building Street Address (including Apt., Unit, Suite, and/or Bldg. No.) or P.O. Route and Box No. 675 E. Equestrian Trail	For Insurance Company Use: Policy Number
City Chino Valley State AZ ZIP Code 86323	Company NAIC Number

If submitting more photographs than will fit on the preceding page, affix the additional photographs below. Identify all photographs with: date taken; "Front View" and "Rear View"; and, if required, "Right Side View" and "Left Side View."



ELEVATION OF FLOODPLAIN PROPERTY

When Completed Return To: YAVAPAI COUNTY DEVELOPMENT SERVICES - FLOODPLAIN UNIT

500 S. Marina St., Prescott, AZ, 86303 (928) 771-3197 FAX (928) 771-3427 Office: Prescott _____
10 S. 6th St., Cottonwood, AZ 86326 (928) 639-8151 FAX (928) 639-8118 Cottonwood _____

DATE June 21, 2006

ASSESSOR'S PARCEL NUMBER 304-02-510X

SUBDIVISION NAME UNIT/PHASE AND LOT NUMBER _____

OWNER Ken Whittaker

SITUS ADDRESS Willow Breeze Rd.

BASE BENCHMARK: Number RM 78 Elevation 4808.67

PROPERTY BENCHMARK 4807.29

DESCRIPTION OF PROPERTY BENCHMARK SE corner. 1/2" rebar 33876

GROUND ELEVATIONS AT BUILDING SITE see attached.
(Please provide a minimum of three (3) elevation points, representative of the site)

Sketch of Lot
(include location of property benchmark and building site elevations)

see Attached.

Remarks _____



(Seal)

Signed Lauri Hopps
Company Name Advanced Surveys
POB 26031
Address Prescott Valley AZ 86312
Telephone 928 772-4716

FOR YAVAPAI COUNTY FLOOD CONTROL DISTRICT USE:

Date: 6/26/06

Base Flood Elevation 4794.6 + 1.0' = Regulatory Elevation 4795.6

* ELEVATION DETERMINATIONS ARE BASED ON BEST AVAILABLE DATA WHEN CALCULATED. ELEVATIONS ARE SUBJECT TO CHANGE WHEN NEW OR REVISED FLOOD STUDIES OR DATA IS SUPPLIED TO THE DISTRICT.

DL

Advanced Surveys


Gary McCorkle, RLS

INC

Lauri Hopps, RLS

ELEVATION OF FLOODPLAIN SURVEY FOR APNS 306-02-510X AND 306-02-510Y.

ELEVATIONS BASED ON RM78,
ELEVATION 4808.67' (NGVD29)
AS SHOWN ON FIRM MAP #04025C1705F

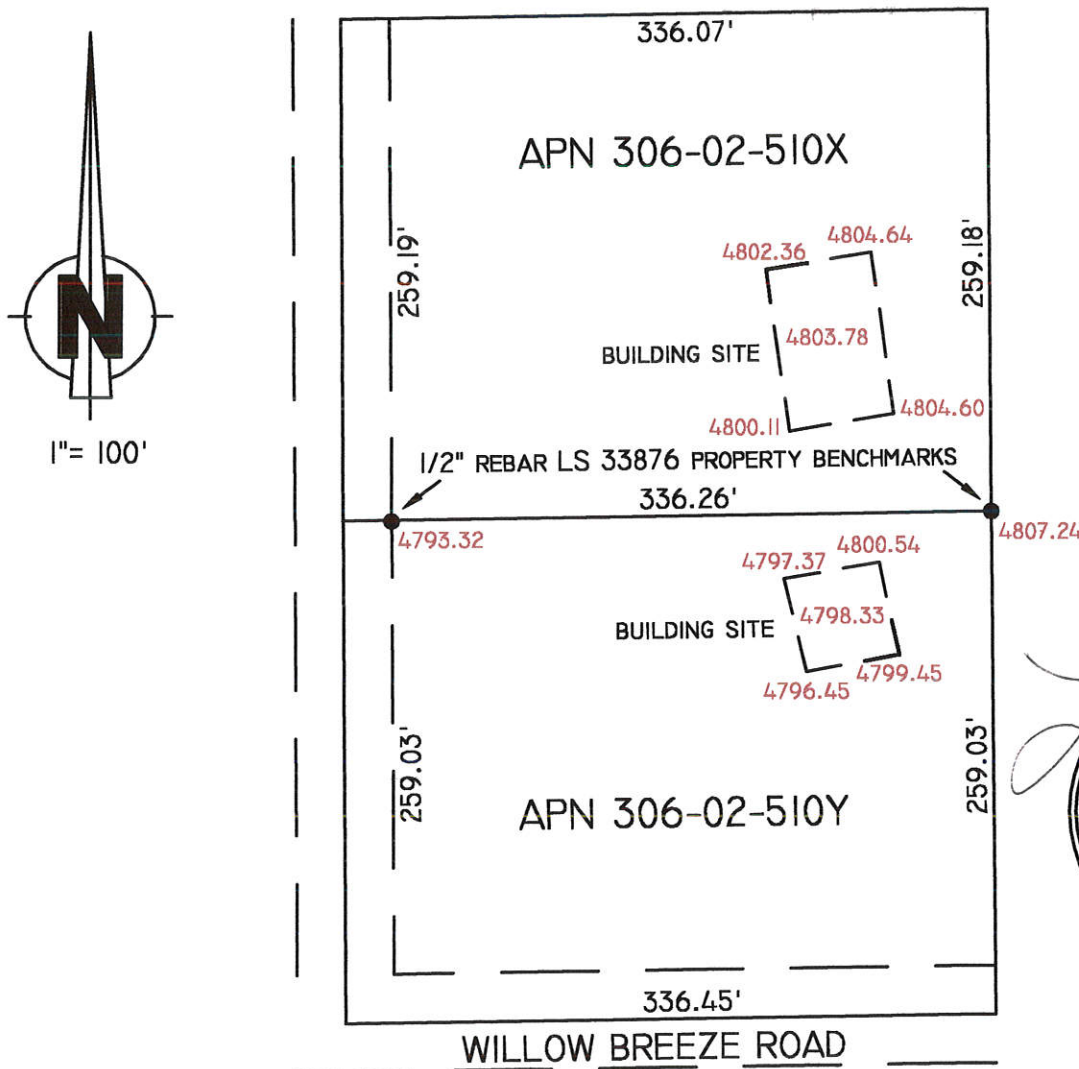

P.O. Box 26031 Prescott Valley, AZ 86312
Voice 928-772-4716 Fax 928-772-4716
Mobile 928-713-2237 rls@commspeed.net

ELEVATION OF FLOODPLAIN PROPERTY

When Completed Return To: YAVAPAI COUNTY DEVELOPMENT SERVICES – FLOODPLAIN UNIT

500 S. Marina St., Prescott, AZ, 86303 (928) 771-3197 FAX (928) 771-3427 Office: Prescott _____
10 S. 6th St., Cottonwood, AZ 86326 (928) 639-8151 FAX (928) 639-8118 Cottonwood _____

DATE June 21, 2006

ASSESSOR'S PARCEL NUMBER 306-02-510 Y

SUBDIVISION NAME UNIT/PHASE AND LOT NUMBER _____

OWNER Ken Whittaker

SITUS ADDRESS Willow Breeze Rd.

BASE BENCHMARK: Number Rm 78 Elevation 4808.67'

PROPERTY BENCHMARK 4807.24

DESCRIPTION OF PROPERTY BENCHMARK NE corner 1/2" rebar 33876

GROUND ELEVATIONS AT BUILDING SITE see attached.
(Please provide a minimum of three (3) elevation points, representative of the site)

Sketch of Lot _____ Remarks _____
(include location of property benchmark and building site elevations)

see Attached.



(Seal)

Lauri Hopps
Signed _____
Advanced Surveys Inc
Company Name _____
POB 26031
Address _____
Prescott Valley, AZ 86312
Telephone 928 772-4716

FOR YAVAPAI COUNTY FLOOD CONTROL DISTRICT USE: Date: _____

Base Flood Elevation _____ + 1.0' = Regulatory Elevation

* ELEVATION DETERMINATIONS ARE BASED ON BEST AVAILABLE DATA WHEN CALCULATED. ELEVATIONS ARE SUBJECT TO CHANGE WHEN NEW OR REVISED FLOOD STUDIES OR DATA IS SUPPLIED TO THE DISTRICT.


Advanced Surveys

Gary McCorkle, RLS

INC

Lauri Hopps, RLS

ELEVATION OF FLOODPLAIN SURVEY
FOR APNS 306-02-510X AND 306-02-510Y.
ELEVATIONS BASED ON RM78,
ELEVATION 4808.67' (NGVD29)
AS SHOWN ON FIRM MAP #04025C1705F

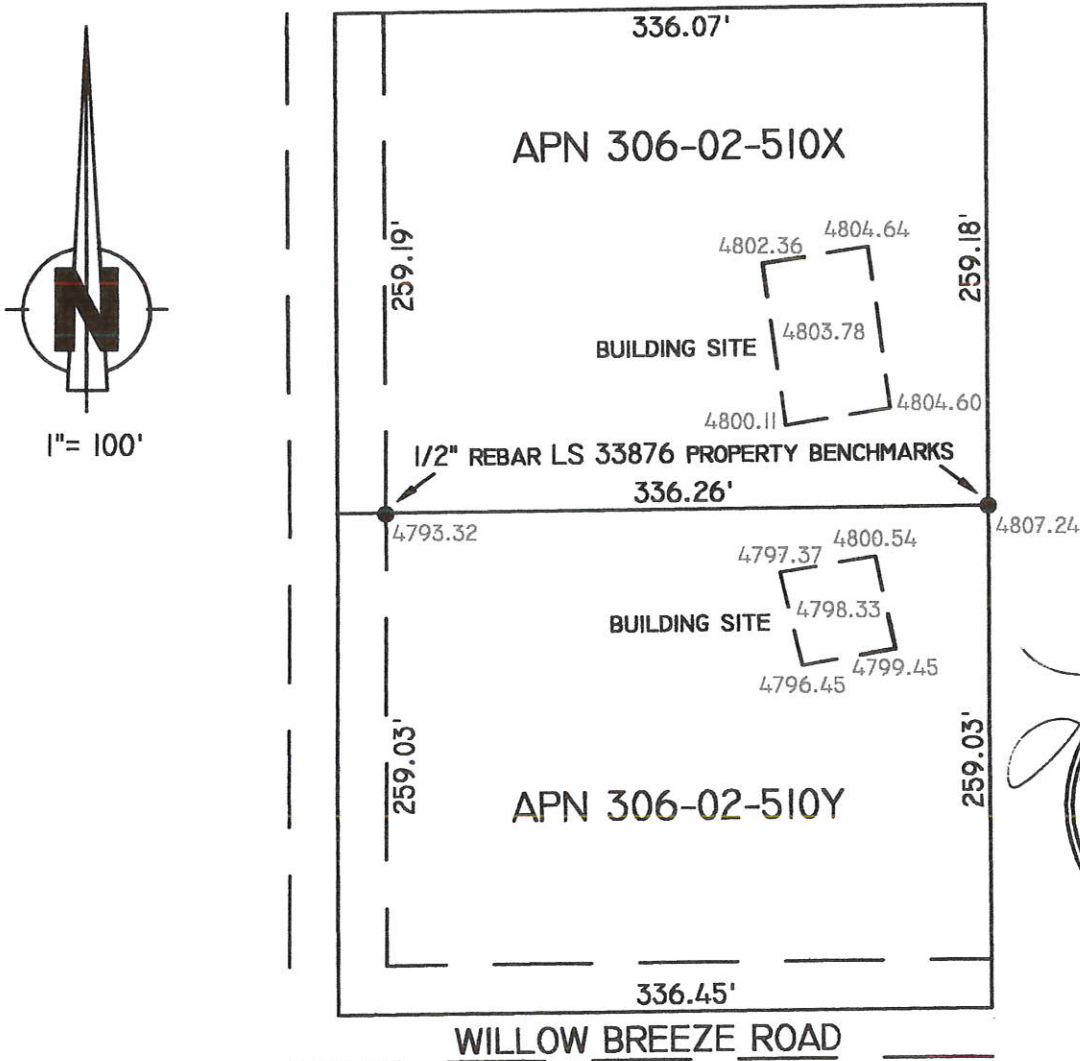

P.O. Box 26031 Prescott Valley, AZ 86312
Voice 928-772-4716 Fax 928-772-4716
Mobile 928-713-2237 rls@commspeed.net