

ELEVATION CERTIFICATE

Important: Read the instructions on pages 1 - 5.

SECTION A - PROPERTY OWNER INFORMATION			For Insurance Company Use:
BUILDING OWNER'S NAME PAUL AND NANCY NICHOLSON		Policy Number	
BUILDING STREET ADDRESS (Including Apt., Unit, Suite, and/or Bldg. No.) OR P.O. ROUTE AND BOX NO. 2460 ROAD 1 SOUTH		Company NAIC Number	
CITY CHINO VALLEY	STATE AZ	ZIP CODE 86323	
PROPERTY DESCRIPTION (Lot and Block Numbers, Tax Parcel Number, Legal Description, etc.) APN 306-02-708C			
BUILDING USE (e.g., Residential, Non-residential, Addition, Accessory, etc. Use comments section if necessary.) RESIDENTIAL			
LATITUDE/LONGITUDE (OPTIONAL) (##° - ##' - ###.###" or ##.#####°)		HORIZONTAL DATUM: SOURCE: <input type="checkbox"/> GPS (Type: _____) <input type="checkbox"/> NAD 1927 <input type="checkbox"/> NAD 1983 <input type="checkbox"/> USGS Quad Map <input type="checkbox"/> Other: _____	

SECTION B - FLOOD INSURANCE RATE MAP (FIRM) INFORMATION

B1. NFIP COMMUNITY NAME & COMMUNITY NUMBER Yavapai County 040093		B2. COUNTY NAME Yavapai County		B3. STATE AZ	
B4. MAP AND PANEL NUMBER 040093 795	B5. SUFFIX C	B6. FIRM INDEX DATE 03/09/1999	B7. FIRM PANEL EFFECTIVE/REVISED DATE 09/20/1996	B8. FLOOD ZONE(S) A4	B9. BASE FLOOD ELEVATION(S) (Zone AO, use depth of flooding) 4782.4

B10. Indicate the source of the Base Flood Elevation (BFE) data or base flood depth entered in B9.
 FIS Profile FIRM Community Determined Other (Describe: _____)

B11. Indicate the elevation datum used for the BFE in B9: NGVD 1929 NAVD 1988 Other (Describe: _____)

B12. Is the building located in a Coastal Barrier Resources System (CBRS) area or Otherwise Protected Area (OPA)? Yes No
 Designation Date: _____

SECTION C - BUILDING ELEVATION INFORMATION (SURVEY REQUIRED)


C1. Building elevations are based on: Construction Drawings* Building Under Construction* Finished Construction
 *A new Elevation Certificate will be required when construction of the building is complete.

C2. Building Diagram Number 1 (Select the building diagram most similar to the building for which this certificate is being completed - see pages 4 and 5. If no diagram accurately represents the building, provide a sketch or photograph.)

C3. Elevations - Zones A1-A30, AE, AH, A (with BFE), VE, V1-V30, V (with BFE), AR, AR/A, AR/AE, AR/A1-A30, AR/AH, AR/AO
 Complete Items C3a-i below according to the building diagram specified in Item C2. State the datum used. If the datum is different from the datum used for the BFE in Section B, convert the datum to that used for the BFE. Show field measurements and datum conversion calculation. Use the space provided or the Comments area of Section D or Section G, as appropriate, to document the datum conversion.
 Datum County Conversion/Comments RM 785.1

Elevation reference mark used 4758.55 Does the elevation reference mark used appear on the FIRM? Yes No

a) Top of bottom floor (including basement or enclosure) 4783.5 ft.(m)
 b) Top of next higher floor N/A ft.(m)
 c) Bottom of lowest horizontal structural member (V zones only) _____ ft.(m)
 d) Attached garage (top of slab) _____ ft.(m)
 e) Lowest elevation of machinery and/or equipment servicing the building _____ ft.(m)
 f) Lowest adjacent grade (LAG) 4780.2 ft.(m)
 g) Highest adjacent grade (HAG) 4781.5 ft.(m)
 h) No. of permanent openings (flood vents) within 1 ft. above adjacent grade _____
 i) Total area of all permanent openings (flood vents) in C3h _____ sq. in. (sq. cm)

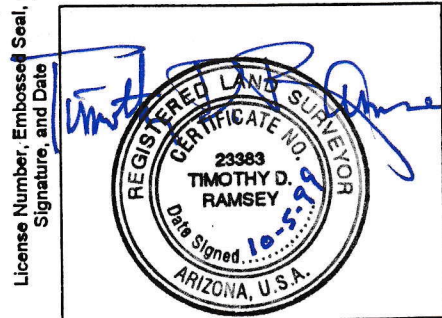

SECTION D - SURVEYOR, ENGINEER, OR ARCHITECT CERTIFICATION

This certification is to be signed and sealed by a land surveyor, engineer, or architect authorized by law to certify elevation information.
 I certify that the information in Sections A, B, and C on this certificate represents my best efforts to interpret the data available.
 I understand that any false statement may be punishable by fine or imprisonment under 18 U.S. Code, Section 1001.

CERTIFIER'S NAME TIMOTHY D. RAMSEY	LICENSE NUMBER R.L.S. 23383
TITLE PRESIDENT	COMPANY NAME RAMSEY SURVEYING, INC.
ADDRESS 2255 WEST KRIS COURT	CITY PRESCOTT
	STATE AZ
	ZIP CODE 86305
SIGNATURE <i>Timothy D. Ramsey</i>	DATE 10/05/99
	TELEPHONE (520) 778-5043

IMPORTANT: In these spaces, copy the responding information from Section A.	For Insurance Company Use:
BUILDING STREET ADDRESS (Including Apt., Unit, Suite, and/or Bldg. No.) OR P.O. ROUTE AND BOX NO. 2460 ROAD 1 SOUTH	Policy Number
CITY CHINO VALLEY	STATE AZ
86323	ZIP CODE
Company NAIC Number	

SECTION D - SURVEYOR, ENGINEER, OR ARCHITECT CERTIFICATION (CONTINUED)

Copy both sides of this Elevation Certificate for (1) community official, (2) insurance agent/company, and (3) building owner.

COMMENTS SECTION B NOT FILLED OUT BY THIS SURVEYOR. ELEVATION DATUM PER COUNTY OF YAVAPAI BENCH MARK RM 7851, ELEVATION 4758.55. ATTACHED IS COPY OF "ELEVATION OF FLOODPLAIN PROPERTY" DATED BY COUNTY 1-13-99.

Check here if attachments

SECTION E - BUILDING ELEVATION INFORMATION (SURVEY NOT REQUIRED) FOR ZONES AO and A (WITHOUT BFE)

For Zones AO and A (without BFE), complete Items E1 through E3. *If the Elevation Certificate is intended for use as supporting information for a LOMA or LOMR-F, Section C must be completed.*

- E1. Building Diagram Number _____ (Select the building diagram most similar to the building for which this certificate is being completed – see pages 4 and 5. If no diagram accurately represents the building, provide a sketch or photograph.)
- E2. The top of the bottom floor (including basement or enclosure) of the building is ft.(m) in.(cm) above or below (check one) the highest adjacent grade.
- E3. For Zone AO only: If no flood depth number is available, is the top of the bottom floor elevated in accordance with the community's floodplain management ordinance? Yes No Unknown. The local official must certify this information in Section G.

SECTION F - PROPERTY OWNER (OR OWNER'S REPRESENTATIVE) CERTIFICATION

The property owner or owner's authorized representative who completes Sections A, B, and E for Zone A (without a FEMA-issued or community-issued BFE) or Zone AO must sign here.

PROPERTY OWNER'S OR OWNER'S AUTHORIZED REPRESENTATIVE'S NAME			
ADDRESS	CITY	STATE	ZIP CODE
SIGNATURE	DATE	TELEPHONE	
COMMENTS			

Check here if attachments

SECTION G - COMMUNITY INFORMATION (OPTIONAL)

The local official who is authorized by law or ordinance to administer the community's floodplain management ordinance can complete Sections A, B, C (or E), and G of this Elevation Certificate. Check the applicable box(es) and sign below.

- G1. The information in Section C was taken from other documentation that has been signed and embossed by a licensed surveyor, engineer, or architect who is authorized by state or local law to certify elevation information. (Indicate the source and date of the elevation data in the Comments area below.)
- G2. A community official completed Section E for a building located in Zone A (without a FEMA-issued or community-issued BFE) or Zone AO.
- G3. The following information (Items G4-G9) is provided for community floodplain management purposes.

G4. PERMIT NUMBER	G5. DATE PERMIT ISSUED	G6. DATE CERTIFICATE OF COMPLIANCE/OCCUPANCY ISSUED
-------------------	------------------------	-----------------------------------------------------

- G7. This permit has been issued for: New Construction Substantial Improvement
- G8. Elevation of as-built lowest floor (including basement) of the building is: _____ ft.(m) Datum: _____
- G9. BFE or (in Zone AO) depth of flooding at the building site is: _____ ft.(m) Datum: _____

LOCAL OFFICIAL'S NAME	TITLE
COMMUNITY NAME	TELEPHONE
SIGNATURE	DATE
COMMENTS	

Check here if attachments

ELEVATION OF FLOODPLAIN PROPERTY

When Completed Return To: Yavapai County Flood Control District

DATE JAN. 9, 1999

ASSESSORS NUMBER PORTION 306-02-317 "K" (FORMERLY)

SUBDIVISION NAME AND NUMBER POR. SEC. 29, T.16N., R. 2W., G. & S. R. B. & M.

OWNER PAUL NICHOLSON, PAUL NICHOLSON CUSTOM HOMES

BASE BENCHMARK NUMBER RM 785.1
(on floodplain circuit)


BASE BENCHMARK ELEVATION 4758.55

PROPERTY BENCHMARK TOP REBAR ELEV. 4779.78

GROUND ELEVATION AT BUILDING SITE 4780.76

DESCRIPTION OF PROPERTY BENCHMARK REBAR PROP. CORNER AT ANGLE POINT ON EAST LINE

Sketch of Lot

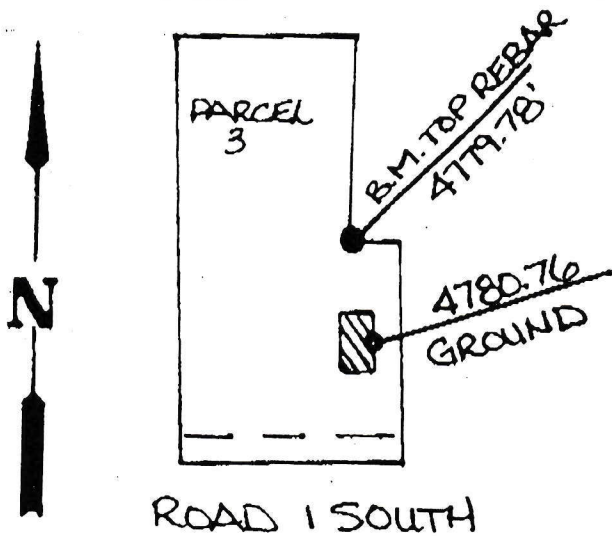

Remarks PARCEL 3 OF PROPOSED PROPERTY SPLIT

[Signature]

REGISTERED LAND SURVEYOR
CERTIFICATE NO. 23363
TIMOTHY D. RAMSEY
Signed 1-9-99
ARIZONA, U.S.A.

99.108

(seal)

Signed

1/13/99

FOR YAVAPAI COUNTY FLOOD CONTROL DISTRICT USE:

Base Flood Elevation <u>4782.4'</u> + 1.0' = Regulatory Elevation <u>4783.4'</u>

ELEVATION OF FLOODPLAIN PROPERTY

When Completed Return To: Yavapai County Flood Control District

DATE JAN. 9, 1999

ASSESSORS NUMBER PORTION 306-02-317 "R" (FORMERLY) NOW 708C

SUBDIVISION NAME AND NUMBER POR. SEC. 29, T. 16N., R. 2W., G. & S. R. B. & M.

OWNER PAUL NICHOLSON, PAUL NICHOLSON CUSTOM HOMES

BASE BENCHMARK NUMBER RM 785.1
(on floodplain circuit)


BASE BENCHMARK ELEVATION 4758.55

PROPERTY BENCHMARK TOP REBAR ELEV. 479.78

GROUND ELEVATION AT BUILDING SITE 4780.76

DESCRIPTION OF PROPERTY BENCHMARK REBAR PROP. CORNER AT ANGLE POINT ON EAST LINE

Sketch of Lot

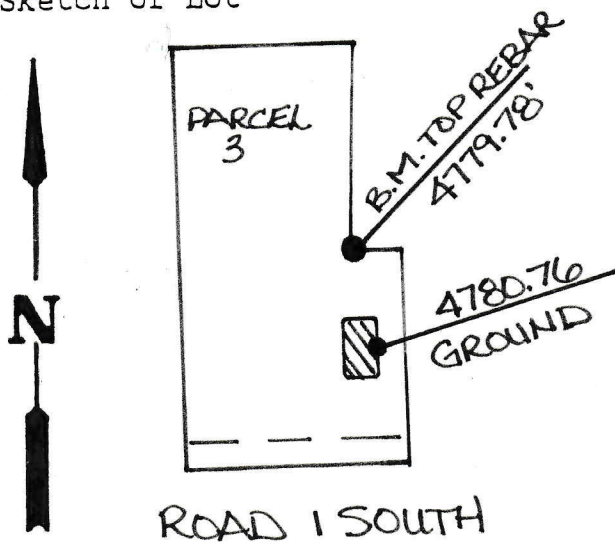

Remarks PARCEL 3 OF PROPOSED PROPERTY SPLIT

[Handwritten signature]

(seal)

Signed

1/13/99

FOR YAVAPAI COUNTY FLOOD CONTROL DISTRICT USE:

Base Flood Elevation 4782.4' + 1.0' = Regulatory Elevation 4783.4'