

ELEVATION CERTIFICATE

Important: Read the instructions on pages 1 - 5.

SECTION A - PROPERTY OWNER INFORMATION

BUILDING OWNER'S NAME <u>VIM LAWLER</u>		For Insurance Company Use: Policy Number
BUILDING STREET ADDRESS (Including Apt., Unit, Suite, and/or Bldg. No.) OR P.O. ROUTE AND BOX NO. <u>1500 PARADISE DR</u>		Company NAIC Number
CITY <u>COTTON WOOD</u>	STATE <u>AZ</u>	ZIP CODE <u>86326</u>
PROPERTY DESCRIPTION (Lot and Block Numbers, Tax Parcel Number, Legal Description, etc.) <u>LOT 3829 VERDE VILLAGE, UNIT 8 APN # 406-50-010</u>		
BUILDING USE (e.g., Residential, Non-residential, Addition, Accessory, etc. Use comments section if necessary.) <u>RESIDENTIAL</u>		
LATITUDE/LONGITUDE (OPTIONAL) (##°-##'-###" or #######")	HORIZONTAL DATUM: <input type="checkbox"/> NAD 1927 <input type="checkbox"/> NAD 1983	SOURCE: <input type="checkbox"/> GPS (Type: _____) <input type="checkbox"/> USGS Quad Map <input type="checkbox"/> Other: _____

SECTION B - FLOOD INSURANCE RATE MAP (FIRM) INFORMATION

B1. NFIP COMMUNITY NAME & COMMUNITY NUMBER <u>YAVAPAI COUNTY 040093</u>		B2. COUNTY NAME <u>YAVAPAI</u>		B3. STATE <u>AZ</u>	
B4. MAP AND PANEL NUMBER <u>04025C1784</u>	B5. SUFFIX <u>F</u>	B6. FIRM INDEX DATE <u>JUNE 6, 2002</u>	B7. FIRM PANEL EFFECTIVE/REVISED DATE <u>JUNE 6 2002</u>	B8. FLOOD ZONE(S) <u>UNSHADED X</u>	B9. BASE FLOOD ELEVATION(S) (Zone AO, use depth of flooding) <u>-</u>

B10. Indicate the source of the Base Flood Elevation (BFE) data or base flood depth entered in B9.
 FIS Profile FIRM Community Determined Other (Describe: See Comment Sheet)

B11. Indicate the elevation datum used for the BFE in B9: NGVD 1929 NAVD 1988 Other (Describe: See Comment Sheet)

B12. Is the building located in a Coastal Barrier Resources System (CBRS) area or Otherwise Protected Area (OPA)? Yes No
 Designation Date: _____

SECTION C - BUILDING ELEVATION INFORMATION (SURVEY REQUIRED)

C1. Building elevations are based on: Construction Drawings* Building Under Construction* Finished Construction
 *A new Elevation Certificate will be required when construction of the building is complete.

C2. Building Diagram Number 1 (Select the building diagram most similar to the building for which this certificate is being completed - see pages 4 and 5. If no diagram accurately represents the building, provide a sketch or photograph.)

C3. Elevations - Zones A1-A30, AE, AH, A (with BFE), VE, V1-V30, V (with BFE), AR, AR/A, AR/AE, AR/A1-A30, AR/AH, AR/AO
 Complete Items C3a-i below according to the building diagram specified in Item C2. State the datum used. If the datum is different from the datum used for the BFE in Section B, convert the datum to that used for the BFE. Show field measurements and datum conversion calculation. Use the space provided or the Comments area of Section D or Section G, as appropriate, to document the datum conversion

Datum _____ Conversion/Comments _____

Elevation reference mark used West CMP Does the elevation reference mark used appear on the FIRM? Yes No

<input type="checkbox"/> a) Top of bottom floor (including basement or enclosure)	_____ ft. (m)
<input type="checkbox"/> b) Top of next higher floor	_____ ft. (m)
<input type="checkbox"/> c) Bottom of lowest horizontal structural member (V zones only)	_____ ft. (m)
<input type="checkbox"/> d) Attached garage (top of slab)	_____ ft. (m)
<input type="checkbox"/> e) Lowest elevation of machinery and/or equipment servicing the building	_____ ft. (m)
<input type="checkbox"/> f) Lowest adjacent grade (LAG)	_____ ft. (m)
<input type="checkbox"/> g) Highest adjacent grade (HAG)	_____ ft. (m)
<input type="checkbox"/> h) No. of permanent openings (flood vents) within 1 ft. above adjacent grade	_____
<input type="checkbox"/> i) Total area of all permanent openings (flood vents) in C3h	_____ sq. in. (sq. cm)

SEE COMMENTS

License Number, Embossed Seal, Signature, and Date

SECTION D - SURVEYOR, ENGINEER, OR ARCHITECT CERTIFICATION

This certification is to be signed and sealed by a land surveyor, engineer, or architect authorized by law to certify elevation information. I certify that the information in Sections A, B, and C on this certificate represents my best efforts to interpret the data available. I understand that any false statement may be punishable by fine or imprisonment under 18 U.S. Code, Section 1001.

CERTIFIER'S NAME <u>STANLEY L NIENHUSER</u>	LICENSE NUMBER <u>29884</u>
TITLE <u>SURVEYOR</u>	COMPANY NAME <u>ARIZONA LAND SOLUTIONS</u>
ADDRESS <u>2673 N OAKMONT</u>	CITY <u>FLAGSTAFF</u>
SIGNATURE <u>[Signature]</u>	STATE <u>AZ</u>
	ZIP CODE <u>86001</u>
	DATE <u>10-8-03</u>
	TELEPHONE <u>928-773-9204</u>

IMPORTANT: In these spaces, copy the corresponding information from Section A.

For Insurance Company Use:	
Policy Number	
Company NAIC Number	

BUILDING STREET ADDRESS (Including Apt., Unit, Suite, and/or Bldg. No.) OR P.O. ROUTE AND BOX NO.
 1500 Paradise Dr.
 CITY Cottonwood STATE AZ ZIP CODE 86326

SECTION D - SURVEYOR, ENGINEER, OR ARCHITECT CERTIFICATION (CONTINUED)

Copy both sides of this Elevation Certificate for (1) community official, (2) insurance agent/company, and (3) building owner.

COMMENTS Elevation benchmark: West Camp, Elevation = 100⁰⁰ per Ted Luther site plan dated 9-13-99 and sealed 2-28-00 approved by Kauai County. FF = 103⁷⁴, Attached garage 103²⁰, Lowest machinery 105⁷⁹, Lowest 102⁸⁰
 Highest grade 103⁰⁹

Check here if attachments

SECTION E - BUILDING ELEVATION INFORMATION (SURVEY NOT REQUIRED) FOR ZONE AO AND ZONE A (WITHOUT BFE)

For Zone AO and Zone A (without BFE), complete Items E1. through E5. If the Elevation Certificate is intended for use as supporting information for a LOMA or LOMR-F, Section C must be completed.

- E1. Building Diagram Number _____ (Select the building diagram most similar to the building for which this certificate is being completed - see pages 6 and 7. If no diagram accurately represents the building, provide a sketch or photograph.)
- E2. The top of the bottom floor (including basement or enclosure) of the building is _____ ft. (m) _____ in. (cm) _____ above or _____ below (check one) the highest adjacent grade. (Use natural grade, if available.)
- E3. For Building Diagrams 6-8 with openings (see page 7), the next higher floor or elevated floor (elevation b) of the building is _____ ft. (m) _____ in. (cm) above the highest adjacent grade. Complete Items C3.h and C3.i on front of form.
- E4. The top of the platform of machinery and/or equipment servicing the building is _____ ft. (m) _____ in. (cm) _____ above or _____ below (check one) the highest adjacent grade. (Use natural grade, if available.)
- E5. For Zone AO only: If no flood depth number is available, is the top of the bottom floor elevated in accordance with the community's floodplain management ordinance? Yes No Unknown. The local official must certify this information in Section G.

SECTION F - PROPERTY OWNER (OR OWNER'S REPRESENTATIVE) CERTIFICATION

The property owner or owner's authorized representative who completes Sections A, B, C (Items C3.h and C3.i only), and E for Zone A (without a FEMA-issued or community-issued BFE) or Zone AO must sign here. The statements in Sections A, B, C, and E are correct to the best of my knowledge.

PROPERTY OWNER'S OR OWNER'S AUTHORIZED REPRESENTATIVE'S NAME _____

ADDRESS _____	CITY _____	STATE _____	ZIP CODE _____
SIGNATURE _____	DATE _____	TELEPHONE _____	

COMMENTS _____

Check here if attachments

SECTION G - COMMUNITY INFORMATION (OPTIONAL)

The local official who is authorized by law or ordinance to administer the community's floodplain management ordinance can complete Sections A, B, C (or E), and G of this Elevation Certificate. Complete the applicable item(s) and sign below.

- G1. The information in Section C was taken from other documentation that has been signed and embossed by a licensed surveyor, engineer, or architect who is authorized by state or local law to certify elevation information. (Indicate the source and date of the elevation data in the Comments area below.)
- G2. A community official completed Section E for a building located in Zone A (without a FEMA-issued or community-issued BFE) or Zone AO.
- G3. The following information (Items G4-G9) is provided for community floodplain management purposes.

G4. PERMIT NUMBER _____	G5. DATE PERMIT ISSUED _____	G6. DATE CERTIFICATE OF COMPLIANCE/OCCUPANCY ISSUED _____
-------------------------	------------------------------	---

G7. This permit has been issued for: New Construction Substantial Improvement _____ ft. (m) Datum: _____

G8. Elevation of as-built lowest floor (including basement) of the building is: _____ ft. (m) Datum: _____

G9. BFE or (in Zone AO) depth of flooding at the building site is: _____

LOCAL OFFICIAL'S NAME _____	TITLE _____
COMMUNITY NAME _____	TELEPHONE _____
SIGNATURE _____	DATE _____

COMMENTS _____

Check here if attachments

Replaces all previous editions

Yavapai County Coordinate Permit Process

Area Map for parcels exceeding 2 acres or with dimensions over 300'

Plot Plan Sketch

Affidavit and E.P.A. Warning

I certify that this plot plan indicates all structures (including fences, walls, and pads), correct property and building dimensions; setback distances; legal access and easements; road cuts; walls and/or any water course (including washes and etc.) on or within 50', 100', and 200' respectively of the property. Use of solder exceeding 0.2 of 1% lead is prohibited for use in potable water systems. This Plot Plan is a part of the permit and is submitted on authority of the property owner.


Signature Walter Slott
Walter Slott

Date 4/3/02
4/3/02

13593A / 2500 / 15

Document #	13593-1389
Sec	10
Twn	15N
Rng	3E
A P N	H06-50-610

IN THE EVENT OF SEPTIC SYSTEM FAILURE AN ALTERNATE SYSTEM WILL BE INSTALLED

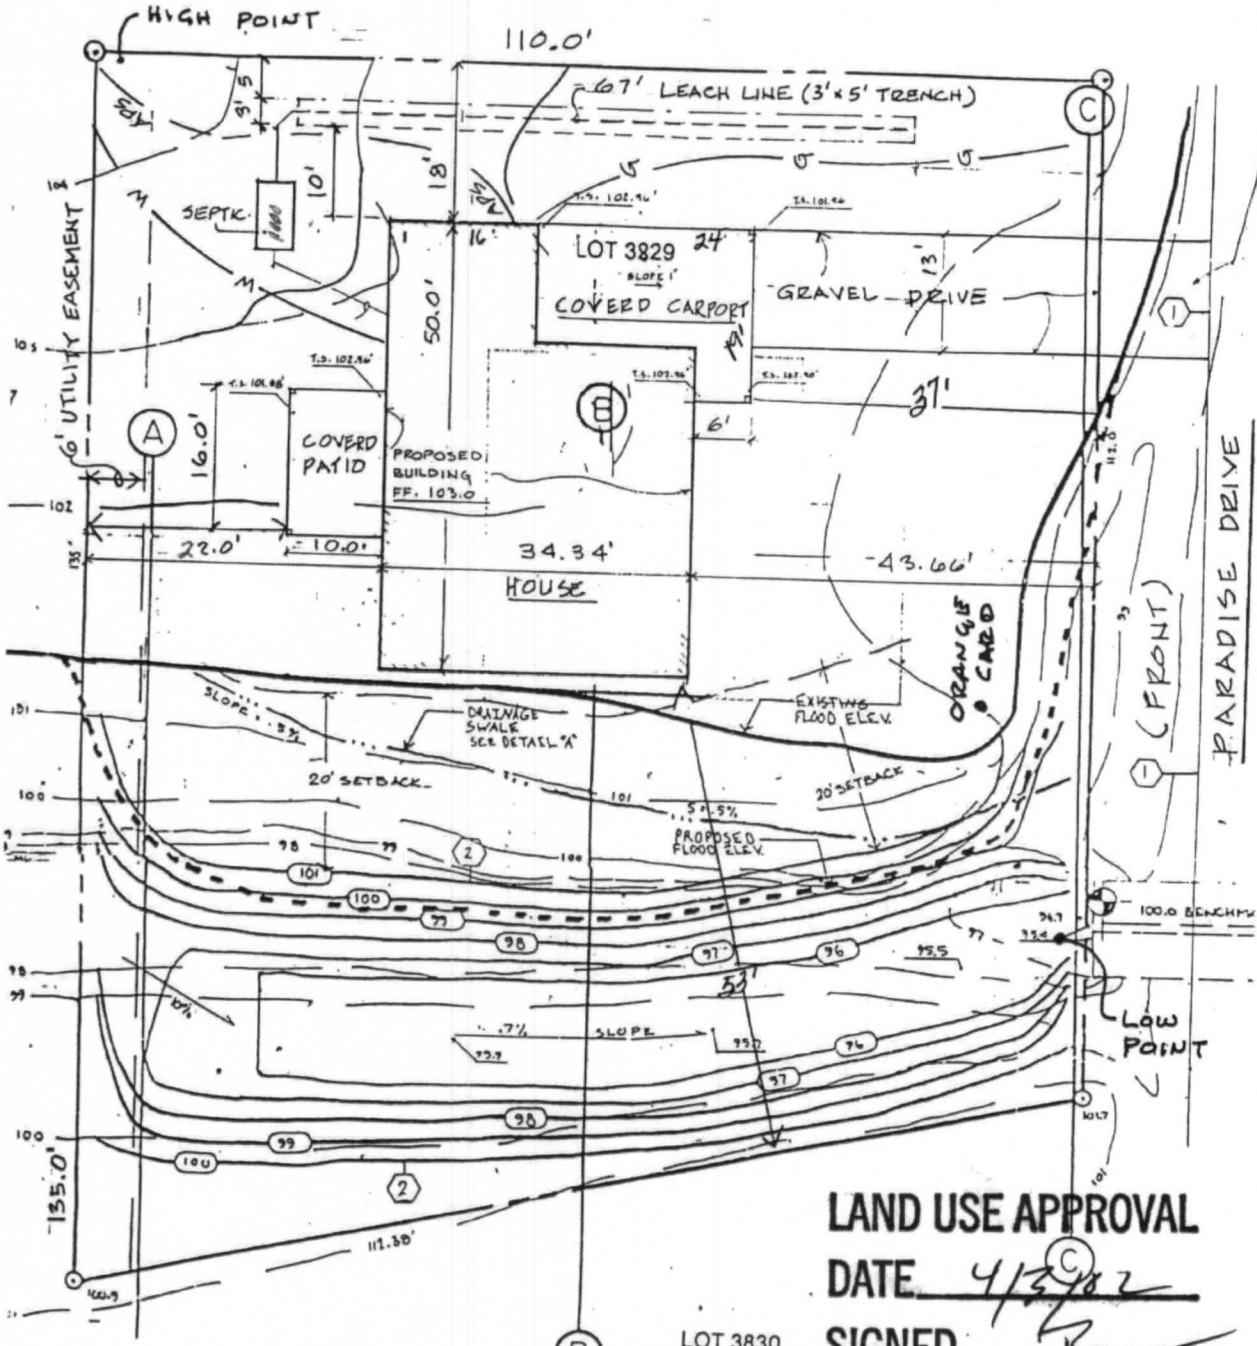

Zoning:	R1A-10
Stories:	1
Height:	13
Slope:	%
FY:	20
RY:	25
EY:	7
IY:	10
LC:	
Lot Area	
Lot %	
Density Used:	
Scale:	1" = 20'

LAND USE APPROVAL
 DATE 4/3/02
 SIGNED Bjw

Must be drawn to scale. Use Black Ink Only

