

ELEVATION CERTIFICATE

FEDERAL EMERGENCY MANAGEMENT AGENCY
NATIONAL FLOOD INSURANCE PROGRAM

O.M.B. No 3067-0077
Expires May 31, 1993

ATTENTION: Use of this certificate does not provide a waiver of the flood insurance purchase requirement. This form is used only to provide elevation information necessary to ensure compliance with applicable community floodplain management ordinances, to determine the proper insurance premium rate, and/or to support a request for a Letter of Map Amendment or Revision (LOMA or LOMR). Instructions for completing this form can be found on the following pages.

SECTION A PROPERTY INFORMATION	FOR INSURANCE COMPANY USE
BUILDING OWNER'S NAME <u>DG + Elaine Graves</u>	POLICY NUMBER
STREET ADDRESS (Including Apt., Unit, Suite and/or Bldg. Number) OR P.O. ROUTE AND BOX NUMBER <u>Po Box 2624 / 10255 E. Creekside Dr.</u>	COMPANY NAIC NUMBER
OTHER DESCRIPTION (Lot and Block Numbers, etc.) <u>Tax Parcel 407-34-118 / Lot 117 Oak Creek Valley</u>	
CITY <u>Sedona</u>	STATE <u>AZ</u>
	ZIP CODE <u>86339</u>

SECTION B FLOOD INSURANCE RATE MAP (FIRM) INFORMATION

Provide the following from the proper FIRM (See Instructions):

1. COMMUNITY NUMBER	2. PANEL NUMBER	3. SUFFIX	4. DATE OF FIRM INDEX	5. FIRM ZONE	6. BASE FLOOD ELEVATION (in AO Zones, use depth)
<u>040093</u>	<u>860</u>	<u>B</u>	<u>8/19/85</u>	<u>A14</u>	<u>3362.5</u>

7. Indicate the elevation datum system used on the FIRM for Base Flood Elevations (BFE): NGVD '29 Other (describe on back)
8. For Zones A or V, where no BFE is provided on the FIRM, and the community has established a BFE for this building site, indicate the community's BFE: feet NGVD (or other FIRM datum—see Section B, Item 7).

SECTION C BUILDING ELEVATION INFORMATION

- Using the Elevation Certificate Instructions, indicate the diagram number from the diagrams found on Pages 5 and 6 that best describes the subject building's reference level 5.
- (a). FIRM Zones A1-A30, AE, AH, and A (with BFE). The top of the reference level floor from the selected diagram is at an elevation of 3363.5 feet NGVD (or other FIRM datum—see Section B, Item 7).
 (b). FIRM Zones V1-V30, VE, and V (with BFE). The bottom of the lowest horizontal structural member of the reference level from the selected diagram, is at an elevation of feet NGVD (or other FIRM datum—see Section B, Item 7).
 (c). FIRM Zone A (without BFE). The floor used as the reference level from the selected diagram is feet above or below (check one) the highest grade adjacent to the building.
 (d). FIRM Zone AO. The floor used as the reference level from the selected diagram is feet above or below (check one) the highest grade adjacent to the building. If no flood depth number is available, is the building's lowest floor (reference level) elevated in accordance with the community's floodplain management ordinance? Yes No Unknown
- Indicate the elevation datum system used in determining the above reference level elevations: NGVD '29 Other (describe under Comments on Page 2). (NOTE: If the elevation datum used in measuring the elevations is different than that used on the FIRM [see Section B, Item 7], then convert the elevations to the datum system used on the FIRM and show the conversion equation under Comments on Page 2.)
- Elevation reference mark used appears on FIRM: Yes No (See Instructions on Page 4)
- The reference level elevation is based on: actual construction construction drawings
(NOTE: Use of construction drawings is only valid if the building does not yet have the reference level floor in place, in which case this certificate will only be valid for the building during the course of construction. A post-construction Elevation Certificate will be required once construction is complete.)
- The elevation of the lowest grade immediately adjacent to the building is: feet NGVD (or other FIRM datum—see Section B, Item 7).

SECTION D COMMUNITY INFORMATION


- If the community official responsible for verifying building elevations specifies that the reference level indicated in Section C, Item 1 is not the "lowest floor" as defined in the community's floodplain management ordinance, the elevation of the building's "lowest floor" as defined by the ordinance is: feet NGVD (or other FIRM datum—see Section B, Item 7).
- Date of the start of construction or substantial improvement 5-9-94.

SECTION E CERTIFICATION

This certification is to be signed by a land surveyor, engineer, or architect who is authorized by state or local law to certify elevation information when the elevation information for Zones A1–A30, AE, AH, A (with BFE), V1–V30, VE, and V (with BFE) is required. Community officials who are authorized by local law or ordinance to provide floodplain management information, may also sign the certification. In the case of Zones AO and A (without a FEMA or community issued BFE), a building official, a property owner, or an owner's representative may also sign the certification.


Reference level diagrams 6, 7 and 8 - Distinguishing Features—If the certifier is unable to certify to breakaway/non-breakaway wall, enclosure size, location of servicing equipment, area use, wall openings, or unfinished area Feature(s), then list the Feature(s) not included in the certification under Comments below. The diagram number, Section C, Item 1, must still be entered.

I certify that the information in Sections B and C on this certificate represents my best efforts to interpret the data available. I understand that any false statement may be punishable by fine or imprisonment under 18 U.S. Code, Section 1001.

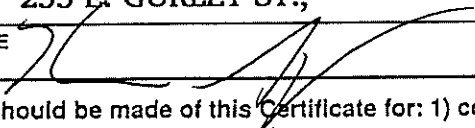CERTIFIER'S NAME KENNETH E. SPEDDING	LICENSE NUMBER (or Affix Seal)
TITLE DISTRICT DIRECTOR	COMPANY NAME YAVAPAI COUNTY FLOOD CONTROL DISTRICT
ADDRESS 255 E. GURLEY ST.,	CITY PRESCOTT
	STATE AZ
	ZIP 86301
SIGNATURE 	DATE 8/9/95
	PHONE (520) 971-3197

Copies should be made of this Certificate for: 1) community official, 2) insurance agent/company, and 3) building owner.

COMMENTS: _____

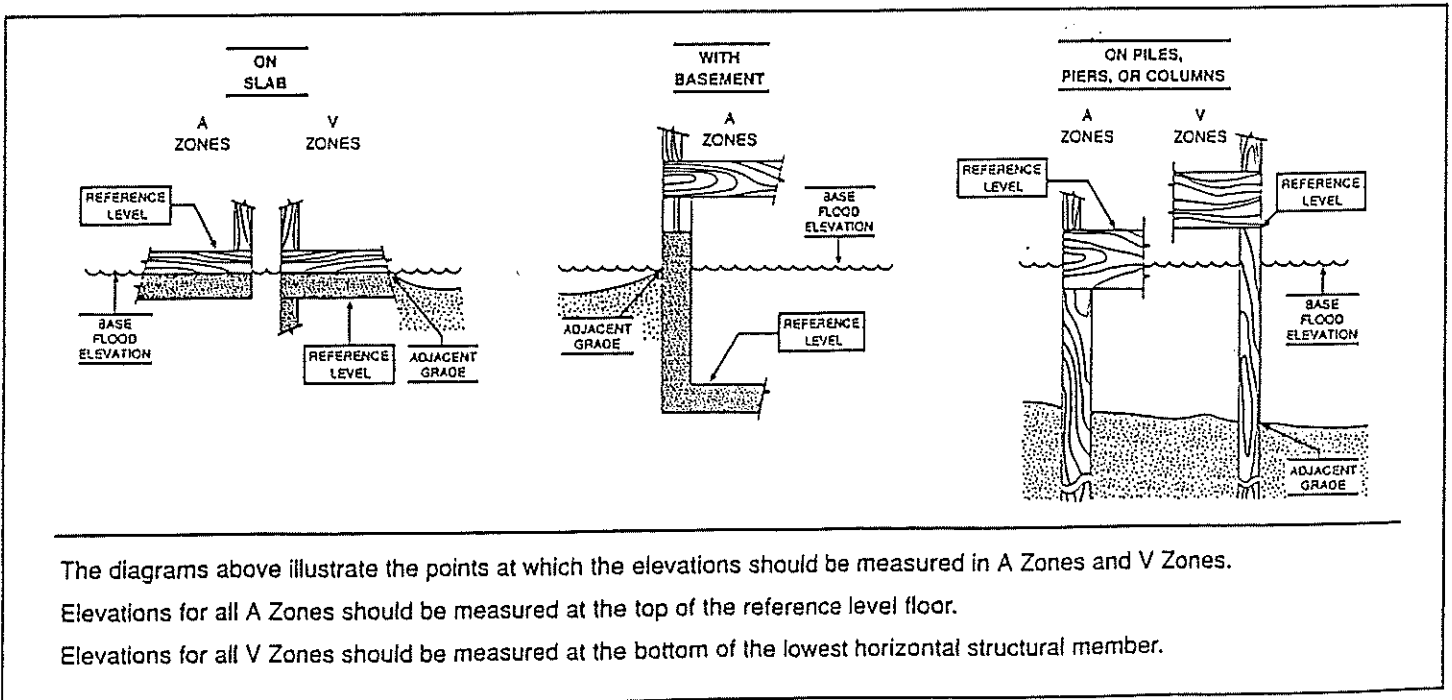

"AS BUILT" ELEVATIC FOR EITHER MANUFACTURED HOMES OR SITE BUILT HOMES

When Completed Return To: Yavapai County Flood Control District

=====
Section 1 - Complete entire section

DATE 3-11-94 ASSESSORS NUMBER 407-34-118

SUBDIVISION NAME AND LOT NUMBER OAK CREEK VALLEY UNIT #2, LOT 117

OWNER D. G. GRAVES

BASE BENCHMARK NUMBER R.M. # 29
(on floodplain circuit)

PROPERTY BENCHMARK ELEVATION 3358.72

DIAGRAM # (from Page 5 & 6 of OMB No. 3067-0070) DIAGRAM # 5

=====
Section 2 - Complete if appropriate

'As Built' Elevation for Manufactured Homes

SURVEYED BOTTOM OF STRUCTURAL FRAME _____

(seal)


Signed

=====
Section 3 - Complete if appropriate

'As Built' Elevation for Site Built Homes

DECK/PROPOSED ADDITION _____
SURVEYED LOWEST FLOOR AT _____ 3366.38
EXISTING BUILDING _____ 3363.51

(seal)

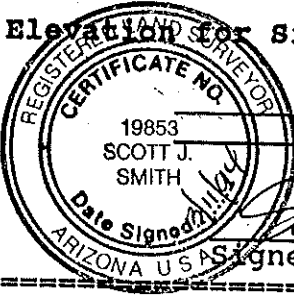

Date Signed _____
Signed _____

=====
FOR DISTRICT USE:

REQUIRED ELEVATION TO BOTTOM OF STRUCTURAL FRAME

(As Per Development Permit

DIFFERENCE _____


REQUIRED LOWEST FLOOR ELEVATION

(As Per Development Permit)

DIFFERENCE _____

=====
F/Elevatn.Frm 7/91

Received 3/16/94 by FCD

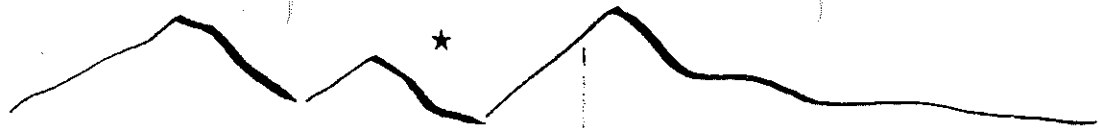

TRUE NORTH SURVEYS, INC.

Job # 94027
March 11, 1994

Yavapai County Flood Control District
255 East Gurley
Prescott, AZ 86302

Re: AS BUILT ELEVATIONS FOR SITE BUILT HOMES
D. G. GRAVES - ASSESSORS # 407-34-118
OAK CREEK VALLEY #2, LOT 117

To Whom It May Concern:

Attached please find your "As Built" Elevations for Site Built Home' Form for the above named property.

As you can see we have included an extra line of information in Section 3.

Please note that the "Surveyed Lowest Floor" represents the elevation at the existing, approved house. The "Deck/Proposed Addition" elevation, approximately 3 feet higher, represents the finished floor at an existing deck which is the subject of the proposed addition/improvement.

Please do not hesitate to call if you have any questions regarding any of this information.

Respectfully
TRUE NORTH SURVEYS, INC.

Scott J. Smith
Registered Land Surveyor