

# 09114

199 VERMILION VILLAGE UNIT 1

# YAVAPAI COUNTY FLOOD CONTROL DISTRICT MONUMENT RECORD FORM

4/6/93  
193

### CORNER LOCATION INFORMATION

SECTION 18 CORNER INDEX CODE \_\_\_\_\_  
TOWNSHIP 15 NORTH, RANGE 4 EAST  
GERR MERIDIAN YAVAPAI COUNTY  
CORNER TYPE:  
 ALIQUOT GOV'T COR.  NON-ALIQUOT GOV'T COR.  OTHER  
FORMAL CORNER NAME: RM 135 RESET

### COUNTY FILING INFORMATION

APPLY COUNTY STICKER HERE IF APPLICABLE  
FEE # \_\_\_\_\_  
DOCKET \_\_\_\_\_ PAGE \_\_\_\_\_  
\_\_\_\_\_ COUNTY, ARIZONA  
DATE \_\_\_\_\_ HOUR \_\_\_\_\_  
FEE: \_\_\_\_\_ PAGES \_\_\_\_\_  
REQUEST OF: \_\_\_\_\_  
TITLE: \_\_\_\_\_  
 SUBMITTED TO BE CHECKED FOR COMPLETENESS  
FILED AT REQUEST OF COUNTY REVIEWER  
TITLE: \_\_\_\_\_  
SIGNED: \_\_\_\_\_ DATE: \_\_\_\_\_

NOTES FOR USING TOWNSHIP INDEX TO DETERMINE INDEX CODE  
FOR ALIQUOT SECTION, QUARTER, AND SIXTEENTH CORNERS, PUT  
A CIRCLE AT THE CORNER LOCATION, THEN READ GRID DESIG-  
NATION (A-I THRU Z-25). A CORNER THAT APPLIES TO TWO  
OR MORE TOWNSHIPS SHOULD BE INDEXED UNDER THE TOWNSHIP  
NORTH OR WEST OF THE CORNER LOCATION AS INDICATED BY  
THE HEAVY LINE ON THE INDEX (GENERALLY THE SOUTH AND  
EAST LINES EXCEPT THE N.E. AND S.W. CORNERS). CLOSING  
CORNERS WILL BE INDEXED UNDER THE TOWNSHIP TO WHICH THEY  
APPLY. FOR 1/64 CORNERS AND FURTHER DIVISIONS, AND  
FOR NON-ALIQUOT CORNERS LYING BETWEEN GRID DESIGNATIONS  
OR WITHIN A GRID SQUARE ON THE INDEX, DRAW AN APPROPRIATE  
REFERENCE LINE OR SHAPE ON THE INDEX, THEN CIRCLE THE  
CORNER LOCATION AND SPECIFY THE NEAREST INDEX CODE TO  
THE NORTH OR WEST (IF ON A GRID LINE), OR AT THE  
NORTHWEST CORNER OF THE GRID BLOCK.

### TOWNSHIP INDEX

SCALE: 1" = 10,000'


	1	2	3	4	5	6	7	8	9	10	11	12	13	14	15	16	17	18	19	20	21	22	23	24	25
A																									
B																									
C																									
D																									
E																									
F																									
G																									
H																									
I																									
J																									
K																									
L																									
M																									
N																									
O																									
P																									
Q																									
R																									
S																									
T																									
U																									
V																									
W																									
X																									
Y																									
Z																									

### MONUMENT FIELD VISIT INFORMATION

DATE OF FIELD VISIT: \_\_\_\_\_  
MONUMENT:  
 LEFT AS FOUND  FOUND & TAGGED  FOUND & REBUILT  
 RESTORED LIST CORNER  ESTABLISHED NEW ACCESSORIES  
BE PLANE COORDINATES:  ESTABLISHED TO \_\_\_\_\_ ORDER  
ZONE:  WEST  CENTRAL  EAST  NOT ESTABLISHED  
DATA:  N.A.D. 1927 (FEET)  N.A.V.D. 1929 (FEET)  
Y= \_\_\_\_\_ X= \_\_\_\_\_ EL.= \_\_\_\_\_  
 N.A.D. 1983 (METERS)  N.A.V.D. 1988 (METERS)  
N= \_\_\_\_\_ E= \_\_\_\_\_ EL.= \_\_\_\_\_  
LAT. \_\_\_\_\_ NORTH, LONG. \_\_\_\_\_ WEST  
GEOID HEIGHT \_\_\_\_\_ SCALE FACTOR \_\_\_\_\_  
CONTROL STATIONS USED: \_\_\_\_\_

DESCRIBE RECORD EVIDENCE FOUND, INCLUDING TIES AND ACCESSORIES, OR IF A  
MONUMENT NOT OF RECORD, TELL WHY YOU ACCEPTED IT AS VALID. DESCRIBE ANY  
ACTIONS TAKEN BY YOU TO REHABILITATE OR PERPETUATE THIS MONUMENT IF  
FOUND IN PERISHABLE OR DETERIORATED CONDITION. IF NO EVIDENCE OF THE  
ORIGINAL MONUMENT OR ITS LOCATION CAN BE FOUND, DESCRIBE THE PROCEDURE  
FOLLOWED IN THE RESTORATION OF THE MONUMENT AND THE CONTROLLING CORNERS  
USED, INCLUDING ALL RECORD OF SURVEY REFERENCES. DESCRIBE ANY NEW MONU-  
MENT SET (INCLUDING ACCESSORY MONUMENTS) AS TO MATERIAL, SHAPE, MARKING,  
PROJECTION OR BURIAL, AND DISPOSITION OF OLD MONUMENT. DESCRIBE NEW  
TIES AND ACCESSORIES IN COORDINATION WITH THE SKETCH ON THE REVERSE.  
DESCRIBE ANY CONFLICTING MONUMENTS OR EVIDENCE AND YOUR CONCLUSIONS.

### CORNER MONUMENT CAP STAMPING

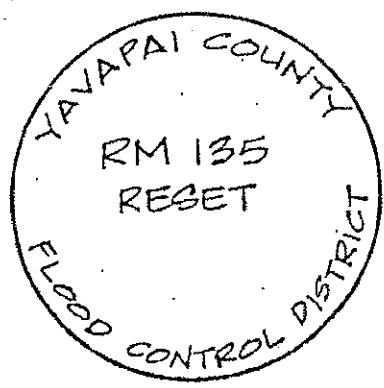

THIS MONUMENT WAS SET FOR VERTICAL  
CONTROL PURPOSES ONLY. THE ELEVATION  
(3246.06) WAS ESTABLISHED USING  
DIFFERENTIAL LEVELING FROM RM 136  
(AS SHOWN ON F.I.R.M. PANEL 865 OF 2100)  
WHICH WAS FOUND INTACT.

NAVD 88 = 3248.12

FILED RECORD OF SURVEY IN COUNTY RECORDS AT \_\_\_\_\_ BOOK \_\_\_\_\_, PAGE(S) \_\_\_\_\_  
ATTACHED SHEETS:  WRITTEN TESTIMONY  FIELD NOTE PAGE(S)  OTHER \_\_\_\_\_  
(OVER) (NOW RM 271 ON FORM 1805F)