

#09114
BRIDGEPORT

ARIZONA LAND SURVEY CORNER RECORD

MONUMENT FIELD VISIT INFORMATION

INDEX CODE

DATE OF FIELD VISIT JAN 8, 2008 MONUMENT ACCEPTED AS MARKING CORNER LOCATION:

- LEFT AS FOUND
- FOUND & TAGGED
- FOUND & REBUILT
- RESTORED LOST CORNER
- RESTORED OBLITERATED CORNER
- ESTABLISHED NEW ACCESSORIES

GLO/BLM NOTES REC. & REF. _____

ARIZONA STATE PLANE COORDINATE SYSTEM: ESTABLISHED TO _____ ORDER, CLASS _____

ZONE: WEST CENTRAL EAST QUADRANGLE DESIGNATION # _____

N.A.D. 1927 (FEET) N.A.D. 1983 (METERS) W.G.S. 1984 (METERS)

N.A.V.D. 1929 (FEET) N.A.V.D. 1988 (^{FEET} ~~METERS~~) GEOID HEIGHT _____

N. (OR) Y= _____ E. (OR) X= _____ ELEVATION _____

** LATITUDE N 34° 43' 14" ** LONGITUDE W-111° 58' 35" GRID FACTOR _____

CONTROL STATIONS USED: ELEVATION VERIFIED FROM RM 277A & RM 278A *

DESCRIBE ALL EVIDENCE FOUND, INCLUDING TIES AND ACCESSORIES TO COMPLY WITH ARIZONA

REVISED STATUTE TITLE 33, SECTION 106: RM 276 ~ FOUND 1 1/2" DIA. BRASS

DISK FLUSH W/PAVEMENT. MONUMENT IS INTACT.

ELEVATION = 3296.50 (NGVD 1929 DATUM) PER FIRM

PANEL 1805 OF 3925

3299.12 (NAVD 1988 DATUM) BASED ON

NGS VERTCON CONVERSION.


NAVD 88 (AS SHOT BY SHEPARD-WESNITZER) = 3298.42

* ELEVATION OF RM 276 VERIFIED BY GPS OBSERVATIONS

FROM RM 277A & RM 278A

** LAT/LONGS ARE BASED ON GPS RTK "AUTONOMOUS" OBSERVATION.

CORNER MONUMENT CAP STAMPING

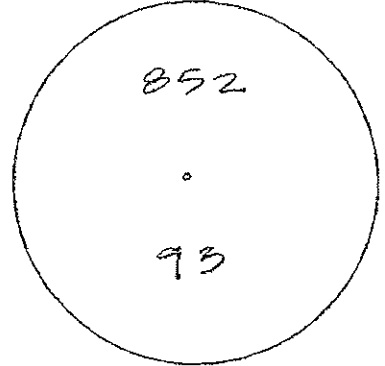

CORNER LOCATION INFORMATION

TOWNSHIP 15 NORTH RANGE 3 EAST

SECTION 1 CORNER INDEX CODE D-24

G#SRB & MERIDIAN YAVAPAL COUNTY

FORMAL CORNER NAME: RM 276

ALIQUOT GOV'T COR. NON-ALIQUOT GOV'T COR. OTHER