



Job No. 09114
Date 03-12-10
By K. CLAWSON
Sheet No. 1 OF 3

Subject VERDE RIVER WHITE BRIDGE SHOTS.

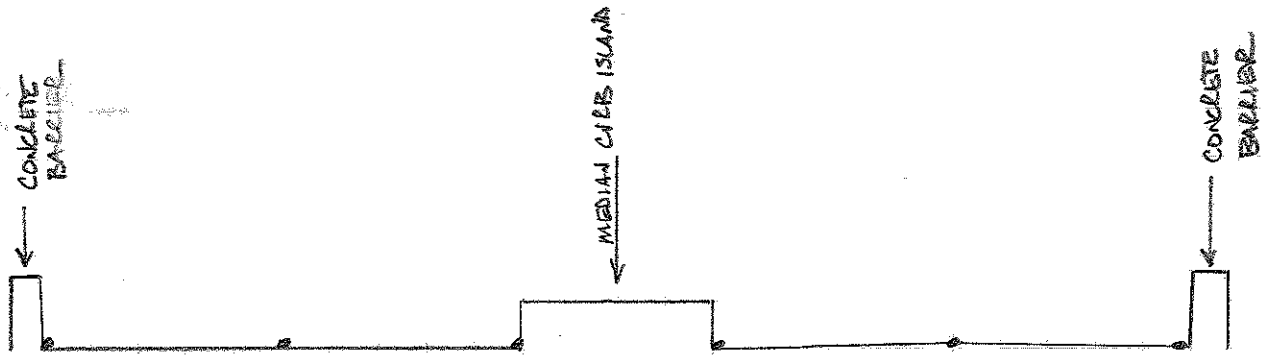

NOTE - DOTS REPRESENT AS-BUILT BRIDGE SHOTS.

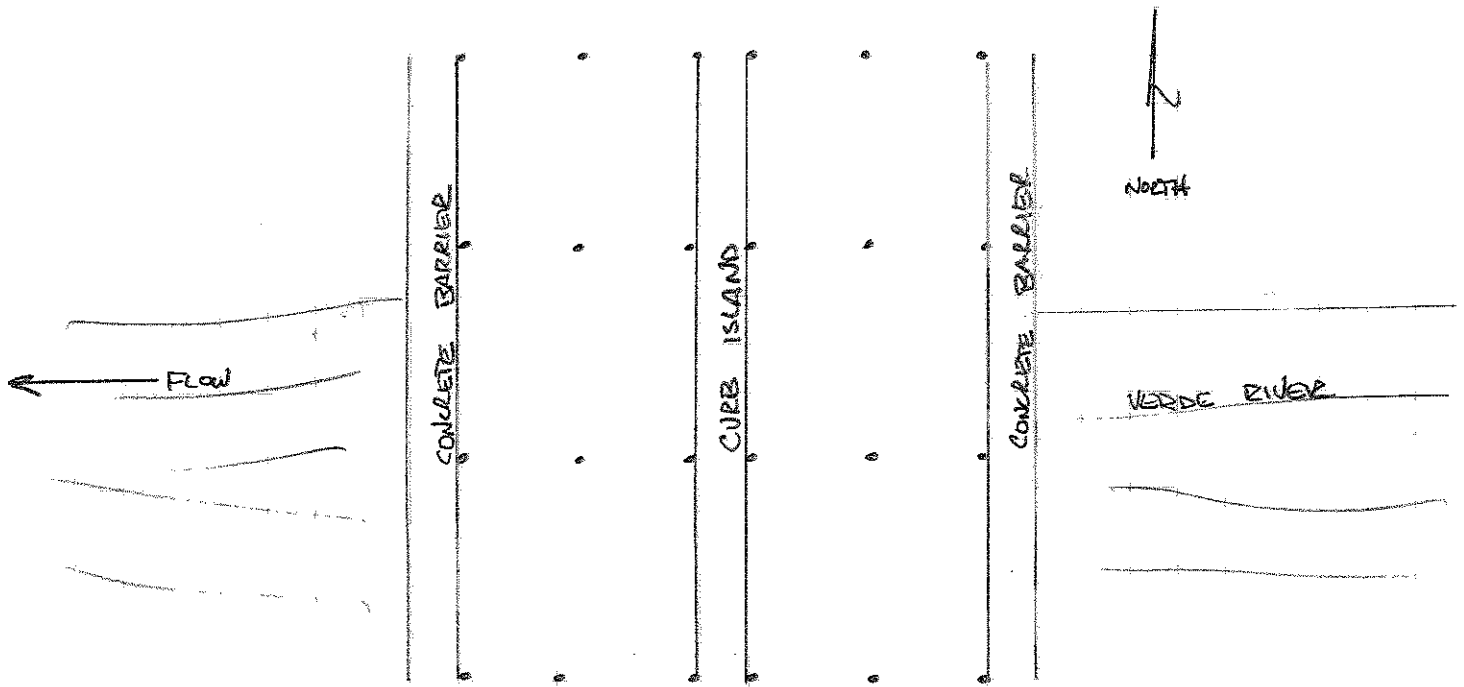

NOTE - AT EACH END OF BRIDGE - STARTED THE AS-BUILT SHOTS AT THE CONCRETE JOINT OF THE BRIDGE. THERE IS A MEAL JOINT THERE THAT SEPARATES THE BRIDGE FROM THE APPROACH SLABS.

**HDR - VERDE RIVER - WHITE BRIDGE (Top of Bridge)
SWI PROJECT #09114**

POINT #	NORTHING	EASTING	ELEVATION
200211001	1292114.83	719384.87	3086.15
200211002	1292126.59	719397.37	3086.47
200211003	1292138.03	719409.61	3086.16
200211004	1292142.16	719414.22	3086.28
200211005	1292151.69	719424.62	3085.99
200211006	1292165.29	719438.98	3085.60
200211007	1292017.14	719475.82	3086.72
200211008	1292028.18	719488.89	3087.17
200211009	1292039.32	719501.35	3086.83
200211010	1292043.57	719505.80	3086.93
200211011	1292052.12	719516.69	3086.64
200211012	1292066.26	719530.98	3086.22
200211013	1291883.44	719599.89	3087.68
200211014	1291895.05	719612.42	3088.02
200211015	1291906.55	719624.67	3087.71
200211016	1291910.86	719629.12	3087.76
200211017	1291920.76	719639.34	3087.43
200211018	1291934.58	719653.55	3087.08
200211019	1291747.37	719726.71	3088.52
200211020	1291759.17	719738.55	3088.98
200211021	1291770.90	719750.87	3088.64
200211022	1291775.08	719755.29	3088.77
200211023	1291784.84	719765.53	3088.36
200211024	1291798.37	719779.92	3087.97
200211025	1291691.65	719879.12	3088.69
200211026	1291678.22	719864.89	3089.08
200211027	1291668.59	719854.49	3089.37
200211028	1291665.16	719849.27	3089.31
200211029	1291653.46	719836.60	3089.65
200211030	1291642.19	719824.49	3089.36