

## ELEVATION REFERENCE MONUMENT

**ERM:** 301

**Panel:** 965

**Elevation (NAVD88):** 4423.51

**Elevation (NGVD29):** 4420.77

**Latitude:** 34°55'40" N

**Longitude:** 112°34'40" W

**Description:** Top of 3-inch aluminum cap in concrete, 0.2 feet above natural ground. Commencing at the Paulden Post Office, then north on U.S. Highway 89 approximately 0.7 mile to Big Chino Road, then west or left on Big Chino Road approximately 9.2 miles to Y in road, then west or left approximately 1.4 miles to fence and cattle guard, then south approximately 2.6 miles to Y in road then easterly or left approximately 0.7 mile to monument.

NATIONAL FLOOD INSURANCE PROGRAM

**FIRM**  **ORIGINAL**  
**FLOOD INSURANCE RATE MAP**

YAVAPAI COUNTY,  
ARIZONA AND  
INCORPORATED AREAS

**PANEL 965 OF 3925**

(SEE MAP INDEX FOR PANELS NOT PRINTED)

CONTAINS:  
COMMUNITY

NUMBER PANEL SUFFIX

YAVAPAI COUNTY  
UNINCORPORATED AREAS

040093

0965

F

MAP NUMBER  
04025C0965 F

EFFECTIVE DATE:  
JUNE 6, 2001



Federal Emergency Management Agency

17/18N

3W

A

B

112°37'30

34°56'15"

ELEVATION REFERENCE MARKS  
 REFERENCE ELEVATION  
 MARK (FEET NGVD) DESCRIPTION OF LOCATION

RM301	4420.77	Top of 3-inch aluminum cap in concrete, 0.2 feet above natural ground. Commencing at the Paulden Post Office, then north on U.S. Highway 89 approximately 0.7 mile to Big Chino Road, then west or left on Big Chino Road approximately 9.2 miles to Y in road, then west or left approximately 1.4 miles to fence and cattle guard, then south approximately 2.6 miles to Y in road then easterly or left approximately 0.7 mile to monument.
-------	---------	--

*was 1052*

1


2

F

G

112°33'45"

34°56'15"

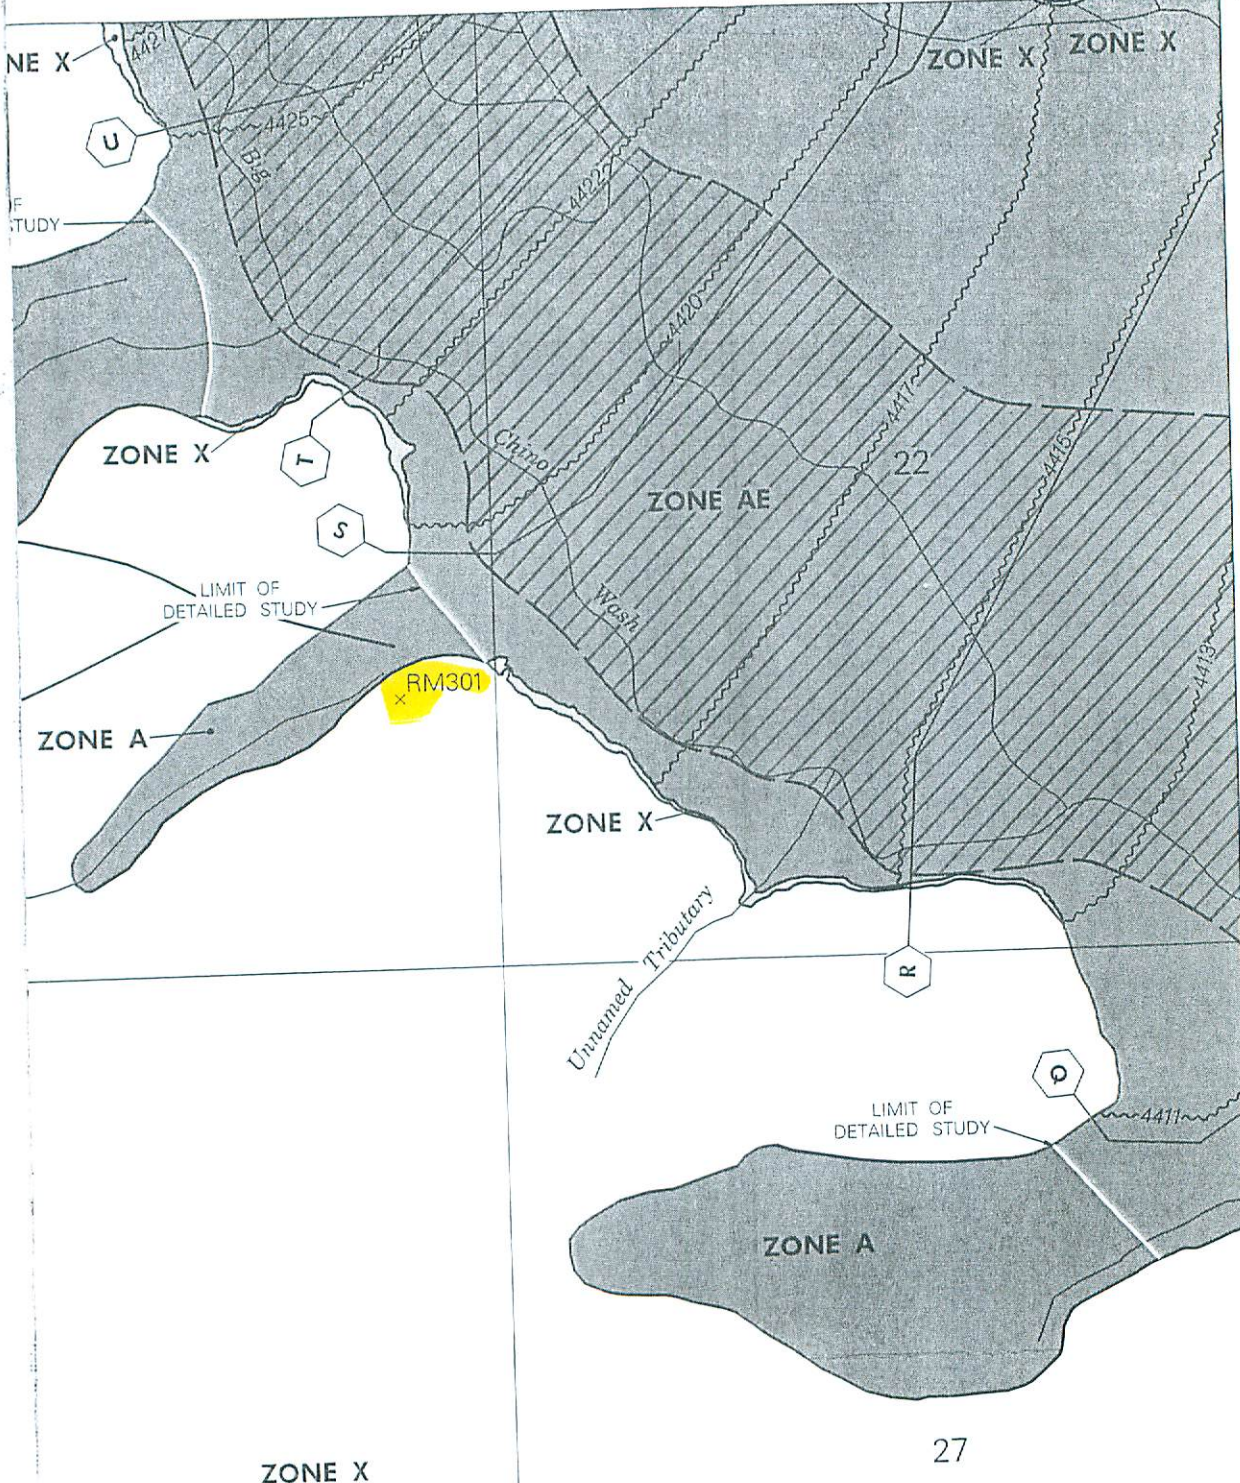



97°

This is a local Special...