

## ELEVATION REFERENCE MONUMENT

**ERM:** 265  
**Panel:** 1120

**Elevation (NAVD88):** 4581.40  
**Elevation (NGVD29):** 4578.73

**Latitude:** 34°55'00" N  
**Longitude:** 111°48'43" W

**Description:** Aerial Mapping Company 1/2 inch rebar with aluminum cap, approximately 200 feet east of Dry Creek, approximately 30 feet west of barbed wire fence, approximately 60 feet northwest of four 12 inch diameter Pine Trees, approximately 300 feet east and 1,100 feet south of the northwest corner of the section 26, T18N, R5E.

NATIONAL FLOOD INSURANCE PROGRAM

**FIRM** ORIGINAL  
FLOOD INSURANCE RATE MAP

YAVAPAI COUNTY,  
ARIZONA AND  
INCORPORATED AREAS

PANEL 1120 OF 3925

(SEE MAP INDEX FOR PANELS NOT PRINTED)

CONTAINS:  
COMMUNITY

COMMUNITY	NUMBER	PANEL	SUFFIX
SEDONA, CITY OF	040130	1120	F
YAVAPAI COUNTY, UNINCORPORATED AREAS	040093	1120	F


MAP NUMBER  
04025C1120 F

EFFECTIVE DATE:  
JUNE 6, 2001



Federal Emergency Management Agency

*Sedona*

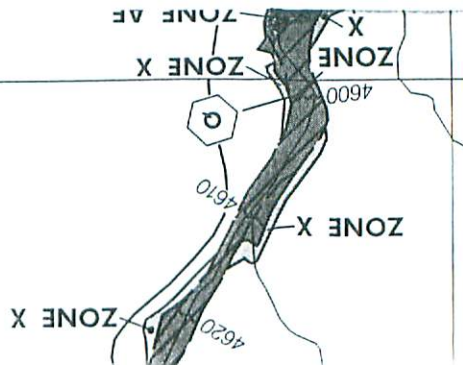

A


B

ELEVATION REFERENCE MARKS  
 REFERENCE MARK ELEVATION (FEET NGVD) DESCRIPTION OF LOCATION

RM265 4578.73 Aerial Mapping Company 1/2-inch rebar with aluminum cap, approximately 200 feet east of Dry Creek, approximately 30 feet west of barbed wire fence, approximately 60 feet northwest of four 12-inch diameter Pine trees, approximately 300 feet east and 1,100 feet south of the northwest corner of Section 26, T18N, R5E.

RM316 4351.82 A U.S. Forest Service brass cap set in bedrock stamped, "OAK A-1, 1971", located on the east side of U.S. 89A, 1.1 miles from the junction of 89A and 179 in Sedona, 300 feet north of motel on the west side of highway, 30 feet east of highway centerline and 8 feet west of powerpole.

111°48'45"  
 34°56'15"

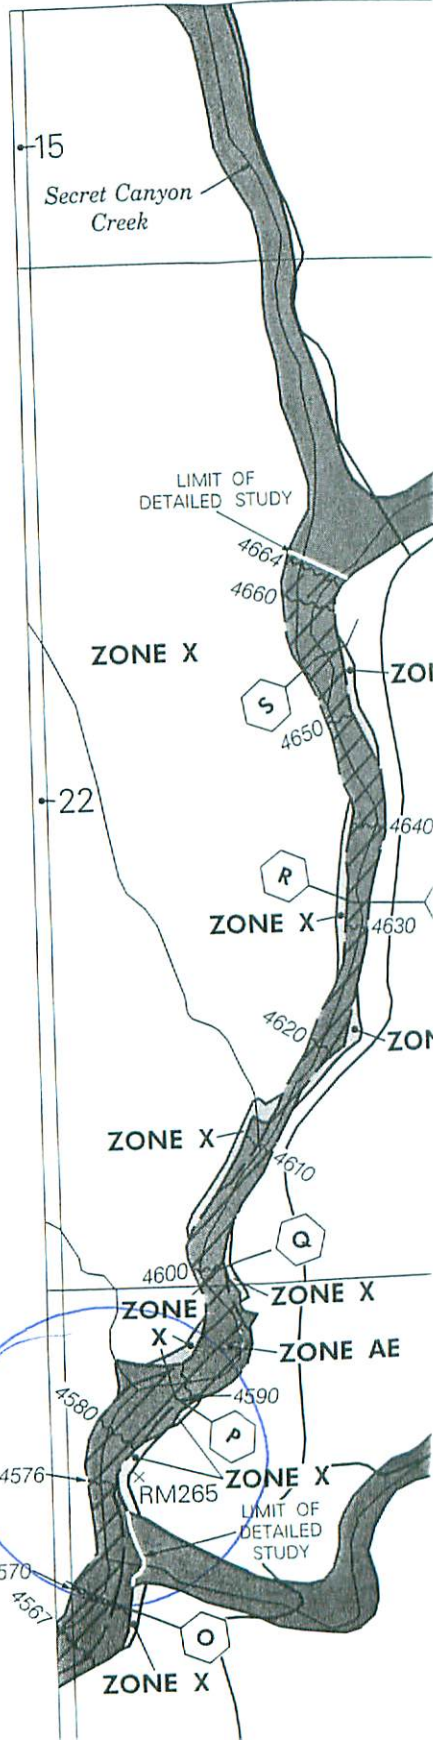

1

2

... fence, approximately  
east of four 12-inch  
trees, approximately  
and 1,100 feet south  
st corner of Section

Service brass cap set  
mped, "OAK A-1, 1971",  
o east side of U.S.  
from the junction of  
edona, 300 feet  
on ne west side of  
et east of highway  
nd 8 feet west of

