

ELEVATION REFERENCE MONUMENT

ERM: 84

Panel: 1445

Elevation (NAVD88): 4099.33

Elevation (NGVD29): 4096.80

Latitude: 34°47'01" N


Longitude: 111°53'38" W

Description: Aerial Mapping Company 1/2-inch raiser flush on hill near approximately center of Section 14, T16N, R4E.

APPROXIMATE SCALE IN FEET
1000 0 1000

1445

NATIONAL FLOOD INSURANCE PROGRAM

 **ORIGINAL**
FIRM

FLOOD INSURANCE RATE MAP

**YAVAPAI COUNTY,
ARIZONA AND
INCORPORATED AREAS**

PANEL 1445 OF 3925

(SEE MAP INDEX FOR PANELS NOT PRINTED)

CONTAINS:
COMMUNITY

NUMBER PANEL SUFFIX

YAVAPAI COUNTY,
UNINCORPORATED AREAS

040093 1445 F

**MAP NUMBER
04025C1445 F**

**EFFECTIVE DATE:
JUNE 6, 2001**




Federal Emergency Management Agency

16/17N 4/5 E A

B

111°56'15"
34°48'45"

REFERENCE MARK	ELEVATION (FEET NGVD)	ELEVATION REFERENCE MARKS DESCRIPTION OF LOCATION
RM83	3484.54	U. S. Geological Survey brass cap in concrete stamped USGS Gaging Station Reference Mark, approximately 0.5 foot northeast of the east end of the upstream headwall, approximately 1,500 feet north and 1,400 feet west of the southeast corner of Section 23, T16N, R4E.
RM84	4096.80	Aerial Mapping Company 1/2-inch rebar flush on hill near approximately center of Section 14, T16N, R4E.
RM85	3680.79	Aerial Mapping Company PK nail flush with concrete pad at top of angle point which is approximately 4.4 feet east of west face of the east concrete abutment of Old Deer Pass Ranch Bridge which crosses Oak Creek, approximately 1,250 feet east and approximately 700 feet south of the northwest corner of Section 12, T16N, R4E.
RM86	3501.49	Aerial Mapping Company PK nail in the east corner of the north concrete headwall of concrete ford which crosses Spring Creek on Oak Creek Ranch School Road, approximately 1,100 feet north and approximately 1,350 feet east of the southwest corner of Section 22, T16N, R4E.
		<i>Replaced - use RM 86A. See RM Book</i>
RM87	3628.56	U. S. Coastal and Geodetic Survey standard disk stamped K-31 Reset 1935 set in the top of a concrete post, 71 feet above premark, approximately 150 feet west of Highway 89A, approximately 1,600 feet west and 2,300 feet north of the southeast corner, Section 16, T16N, R4E.

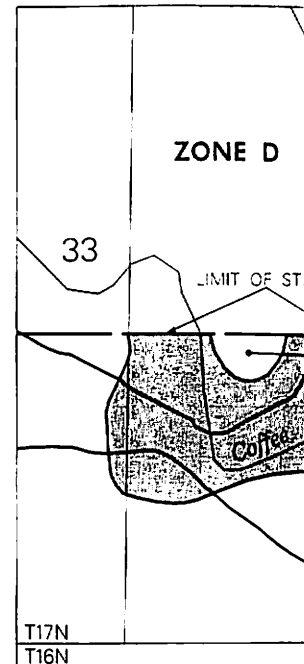


1

2

NE X

13

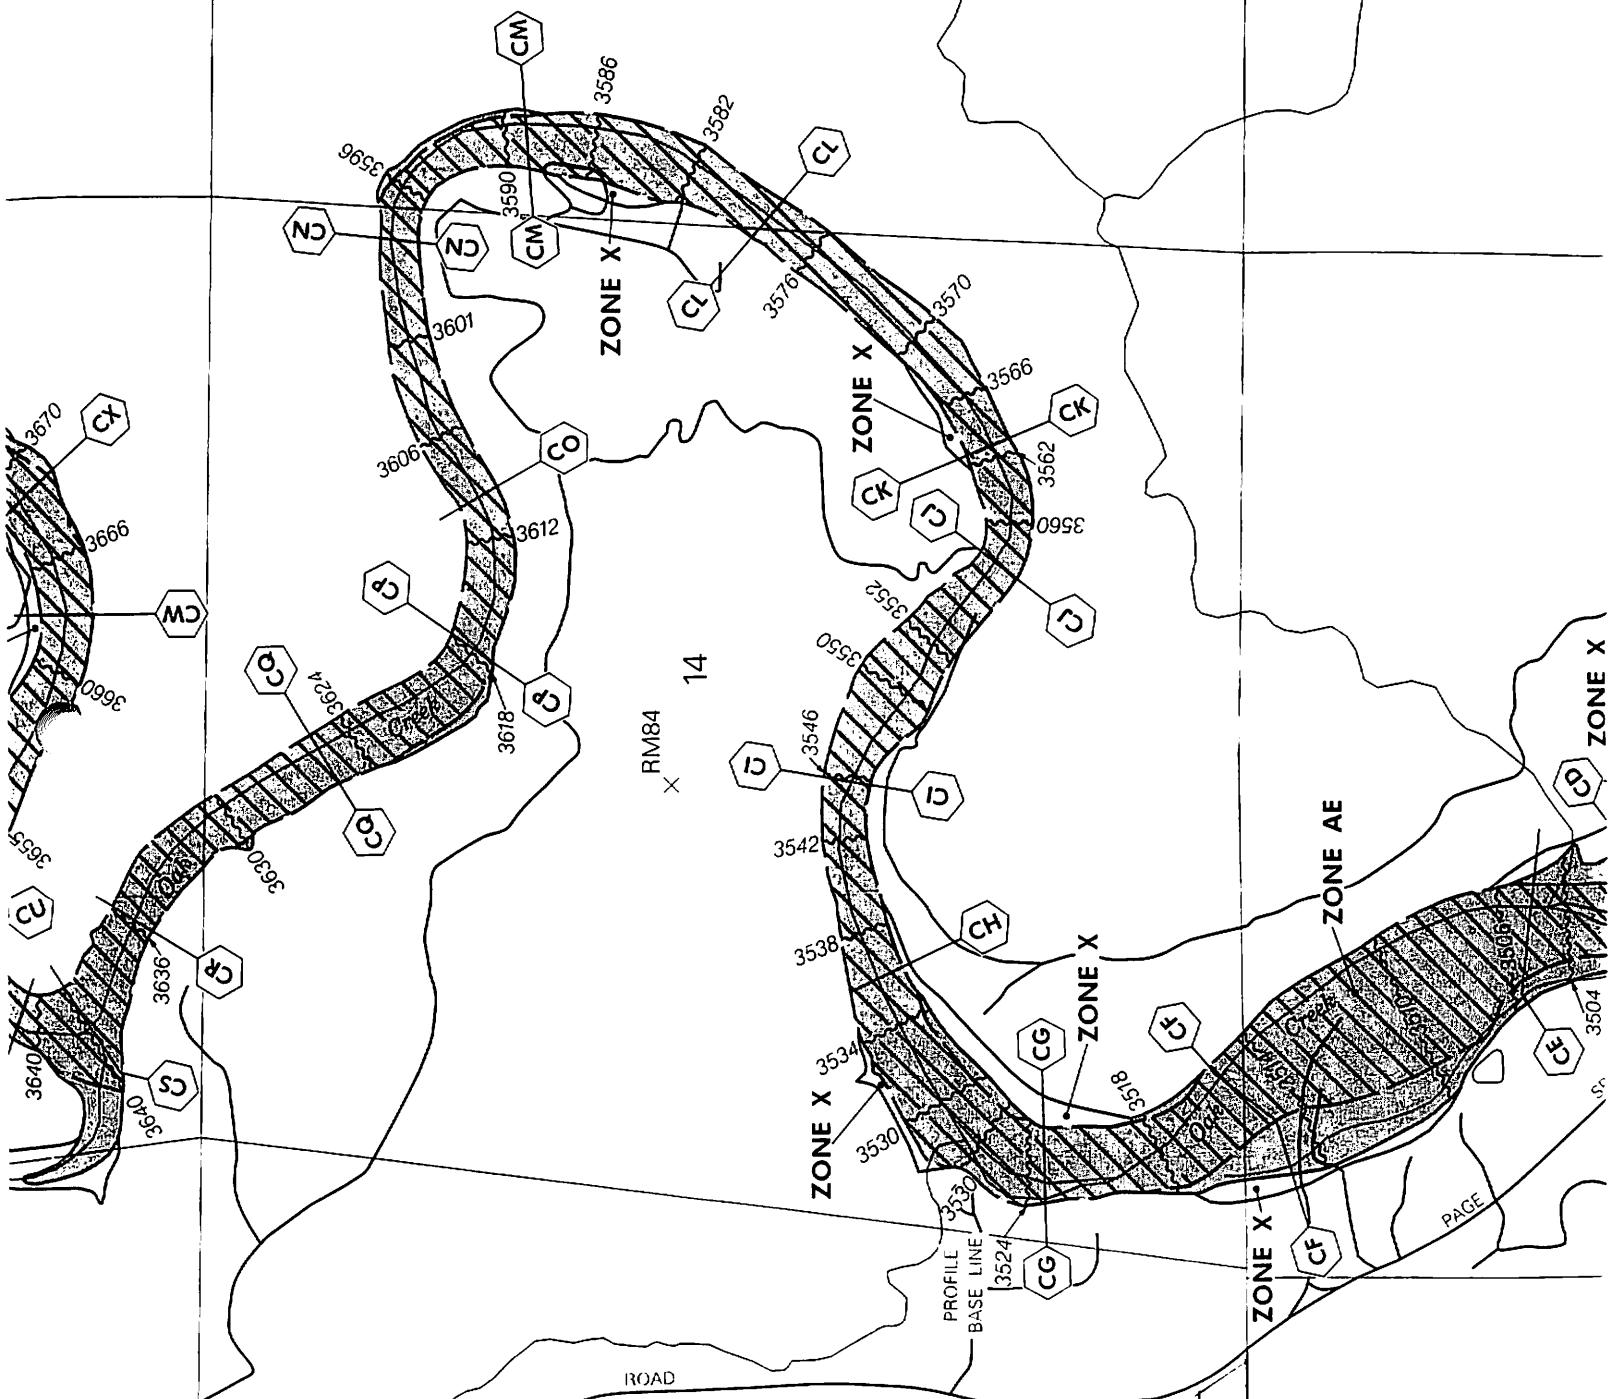

14

RMB4

ADONAL FOREST

15

ZONE X

PAGE