

ELEVATION REFERENCE MONUMENT

ERM: 283

Panel: 1470

Elevation (NAVD88): 3956.96

Elevation (NGVD29): 3954.40

Latitude: 34°45'51" N

Longitude: 111°46'00" W

Description: Aerial Mapping Company chiseled X in southwest corner of west concrete bridge abutment, approximately 24 feet west of centerline of State Highway 179, approximately 950 feet west and 1,300 feet north of southeast corner of Section 24, T16N, R5E.

Big Park

1470

NATIONAL FLOOD INSURANCE PROGRAM

FIRM

ORIGINAL

FLOOD INSURANCE RATE MAP

**YAVAPAI COUNTY,
ARIZONA AND
INCORPORATED AREAS**

PANEL 1470 OF 3925

(SEE MAP INDEX FOR PANELS NOT PRINTED)

CONTAINS:

COMMUNITY

NUMBER

PANEL

SUFFIX

YAVAPAI COUNTY,
UNINCORPORATED AREAS

04C093

1470

F

**MAP NUMBER
04025C1470 F**

**EFFECTIVE
JUNF**



Federal Emergency M

REPRODUCED FROM ORIGINAL

ENCLOSURE

16/17 N 5/6 E A

B

Big Park

111°48'45"
34°48'45"


REFERENCE MARK	ELEVATION (FEET NGVD)	DESCRIPTION OF LOCATION
----------------	-----------------------	-------------------------

RM283	3954.40	Aerial Mapping Company chiseled X in southwest corner of west concrete bridge abutment, approximately 24 feet west of centerline of State Highway 179, approximately 950 feet west and 1,300 feet north of southeast corner of Section 24, T16N, R5E.
-------	---------	---

1

2

T17N
T16N

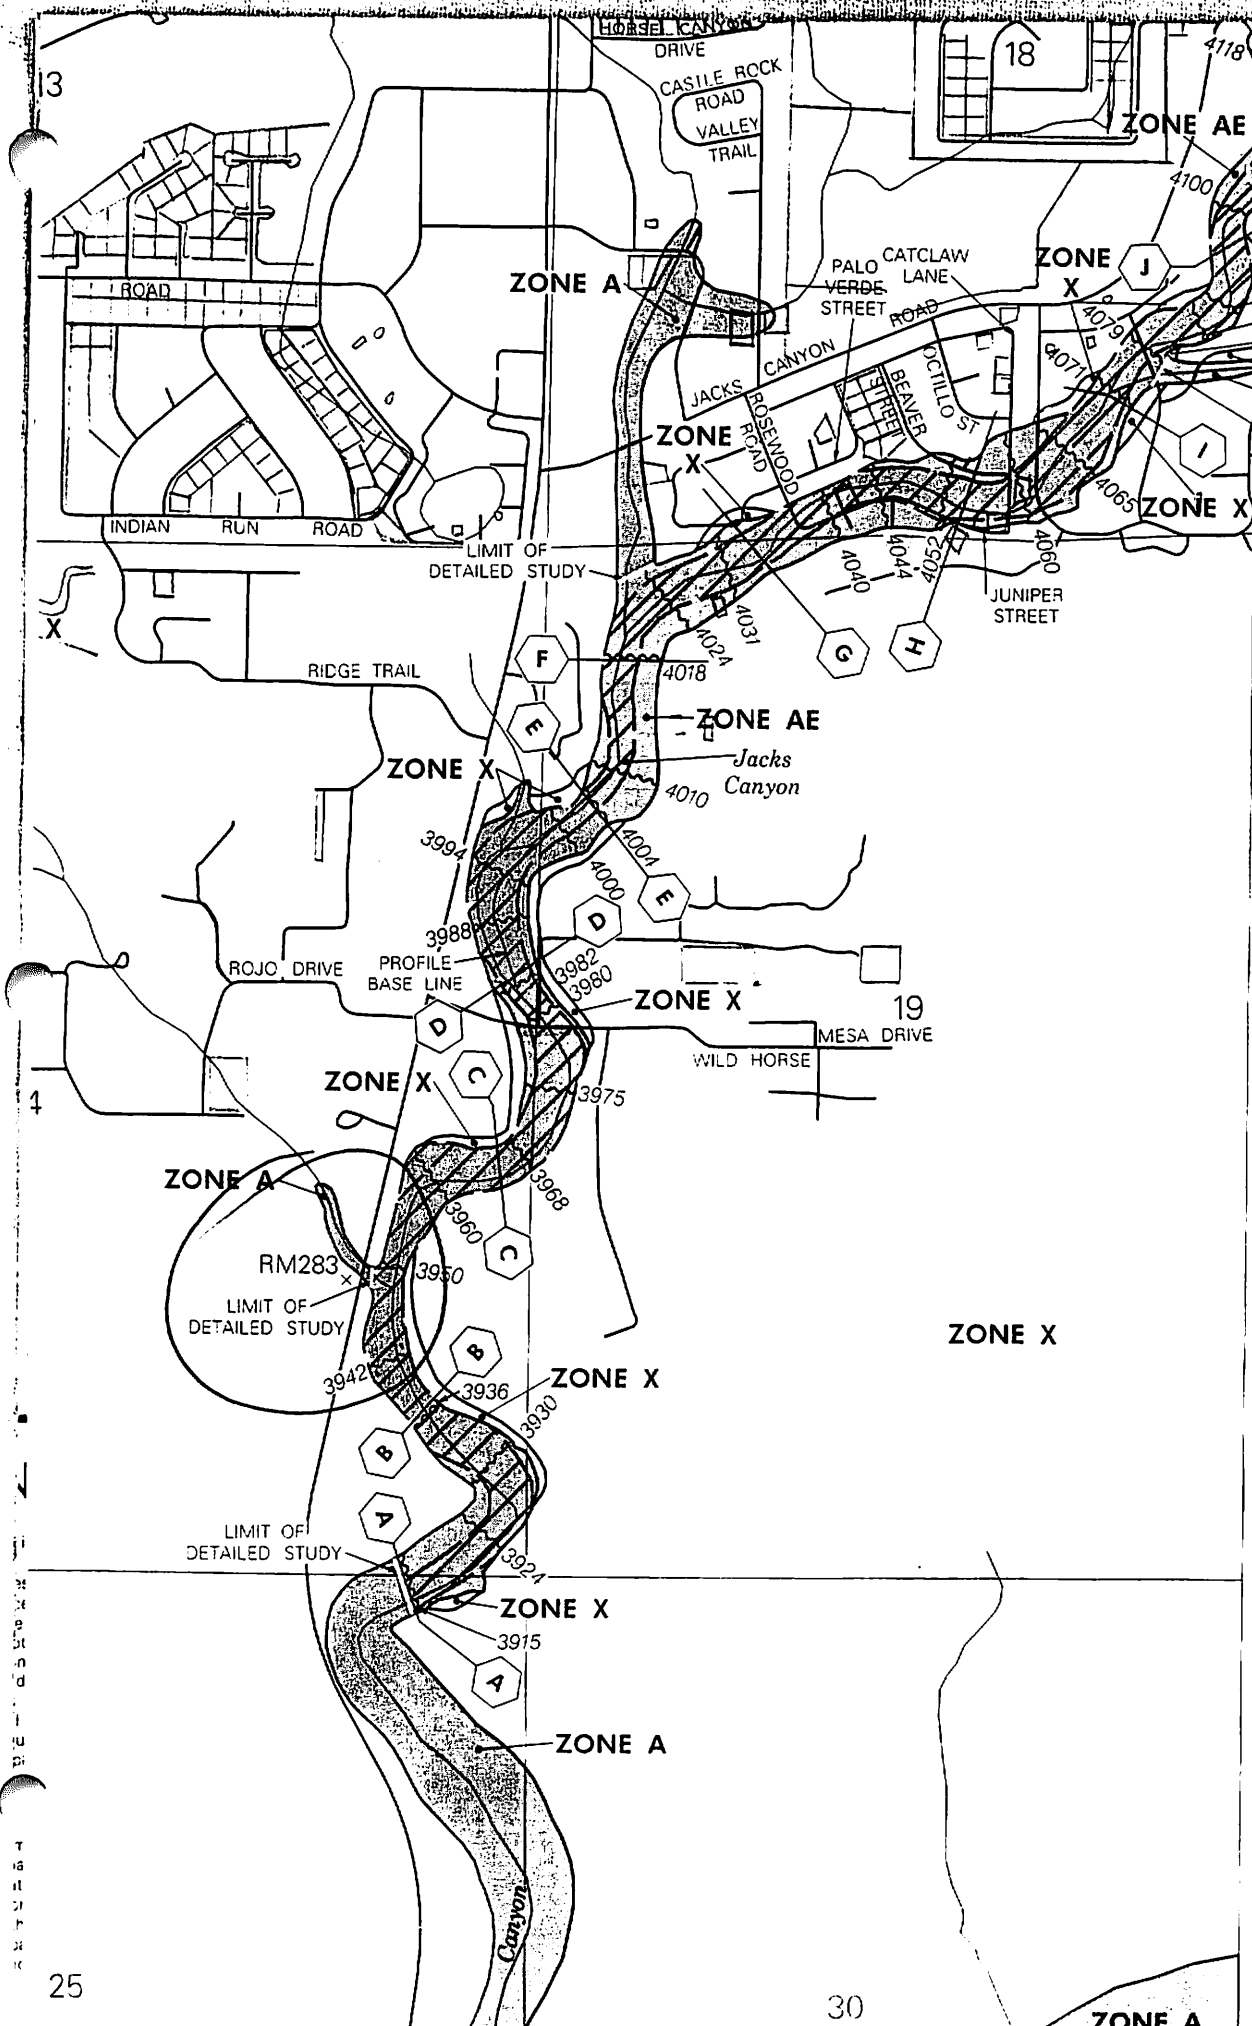

show limit
 This Res. und.
 For Sec
 For Mar
 Ret on zon
 To ca

JOINS PANEL 1490

ZONE AE
 ZONE X
 ZONE X
 4088
 4085
 ZONE X
 ZONE X
 ZONE A
 LIMIT OF DETAILED STUDY

18
 4118
 4100
 ZONE J
 ZONE X
 4079
 4077
 4065
 ZONE X

INDIAN RUN ROAD
 LIMIT OF DETAILED STUDY
 RIDGE TRAIL
 ZONE X
 F
 E
 JACKS Canyon
 4010
 ZONE AE
 3994
 4004
 4000
 E
 D
 ROJO DRIVE
 PROFILE BASE LINE
 3988
 3982
 3980
 ZONE X
 19
 MESA DRIVE
 WILD HORSE
 3975
 ZONE X
 3968
 3960
 C
 3950
 ZONE A
 RM283
 LIMIT OF DETAILED STUDY
 3942
 3936
 ZONE X
 3930
 3924
 LIMIT OF DETAILED STUDY
 ZONE X
 3915
 A
 ZONE A
 Canyon

13
 4
 25

30
 ZONE A