

ELEVATION REFERENCE MONUMENT

ERM: 293

Panel: 1743

Elevation (NAVD88): 4893.89

Elevation (NGVD29): 4891.16

Latitude: 34°37'35" N

Longitude: 112°18'13" W

Description: Aerial Mapping Company 1/2-inch rebar with aluminum cap, approximately 65 feet south of centerline dirt road, approximately 1,000 feet east of property line on old railroad grade, approximately 700 feet south of and approximately 950 feet east of approximate northwest corner of Section 6, T14N, R1E.

1743

NATIONAL FLOOD INSURANCE PROGRAM

FIRM ORIGINAL

FLOOD INSURANCE RATE MAP

**YAVAPAI COUNTY,
ARIZONA AND
INCORPORATED AREAS**

PANEL 1743 OF 3925

(SEE MAP INDEX FOR PANELS NOT PRINTED)

<u>CONTAINS</u> <u>COMMUNITY</u>	<u>NUMBER</u>	<u>PANEL</u>	<u>SUFFIX</u>
PRESCOTT VALLEY TOWN OF	04012	1743	F
YAVAPAI COUNTY, UNINCORPORATED AREAS	041033	1743	F

**MAP NUMBER
04025C1743 F**

**EFFECTIVE DATE:
JUNE 6, 2001**



Federal Emergency Management Agency

A

B

112°18'45"
34°39'22"


ELEVATION REFERENCE MARKS
REFERENCE ELEVATION
MARK (FEET NGVD) DESCRIPTION OF LOCATION


RM293 4891.16 Aerial Mapping Company 1/2-inch
 rebar with aluminum cap,
 approximately 65 feet south of
 centerline dirt road, approximately
 1,000 feet east of property line on
 old railroad grade, approximately
 700 feet south of and approximately
 950 feet east of approximate
 northwest corner of Section 6,
 T14N, R1E.

1

2

3

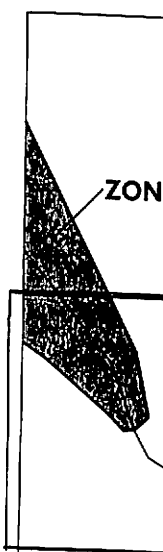

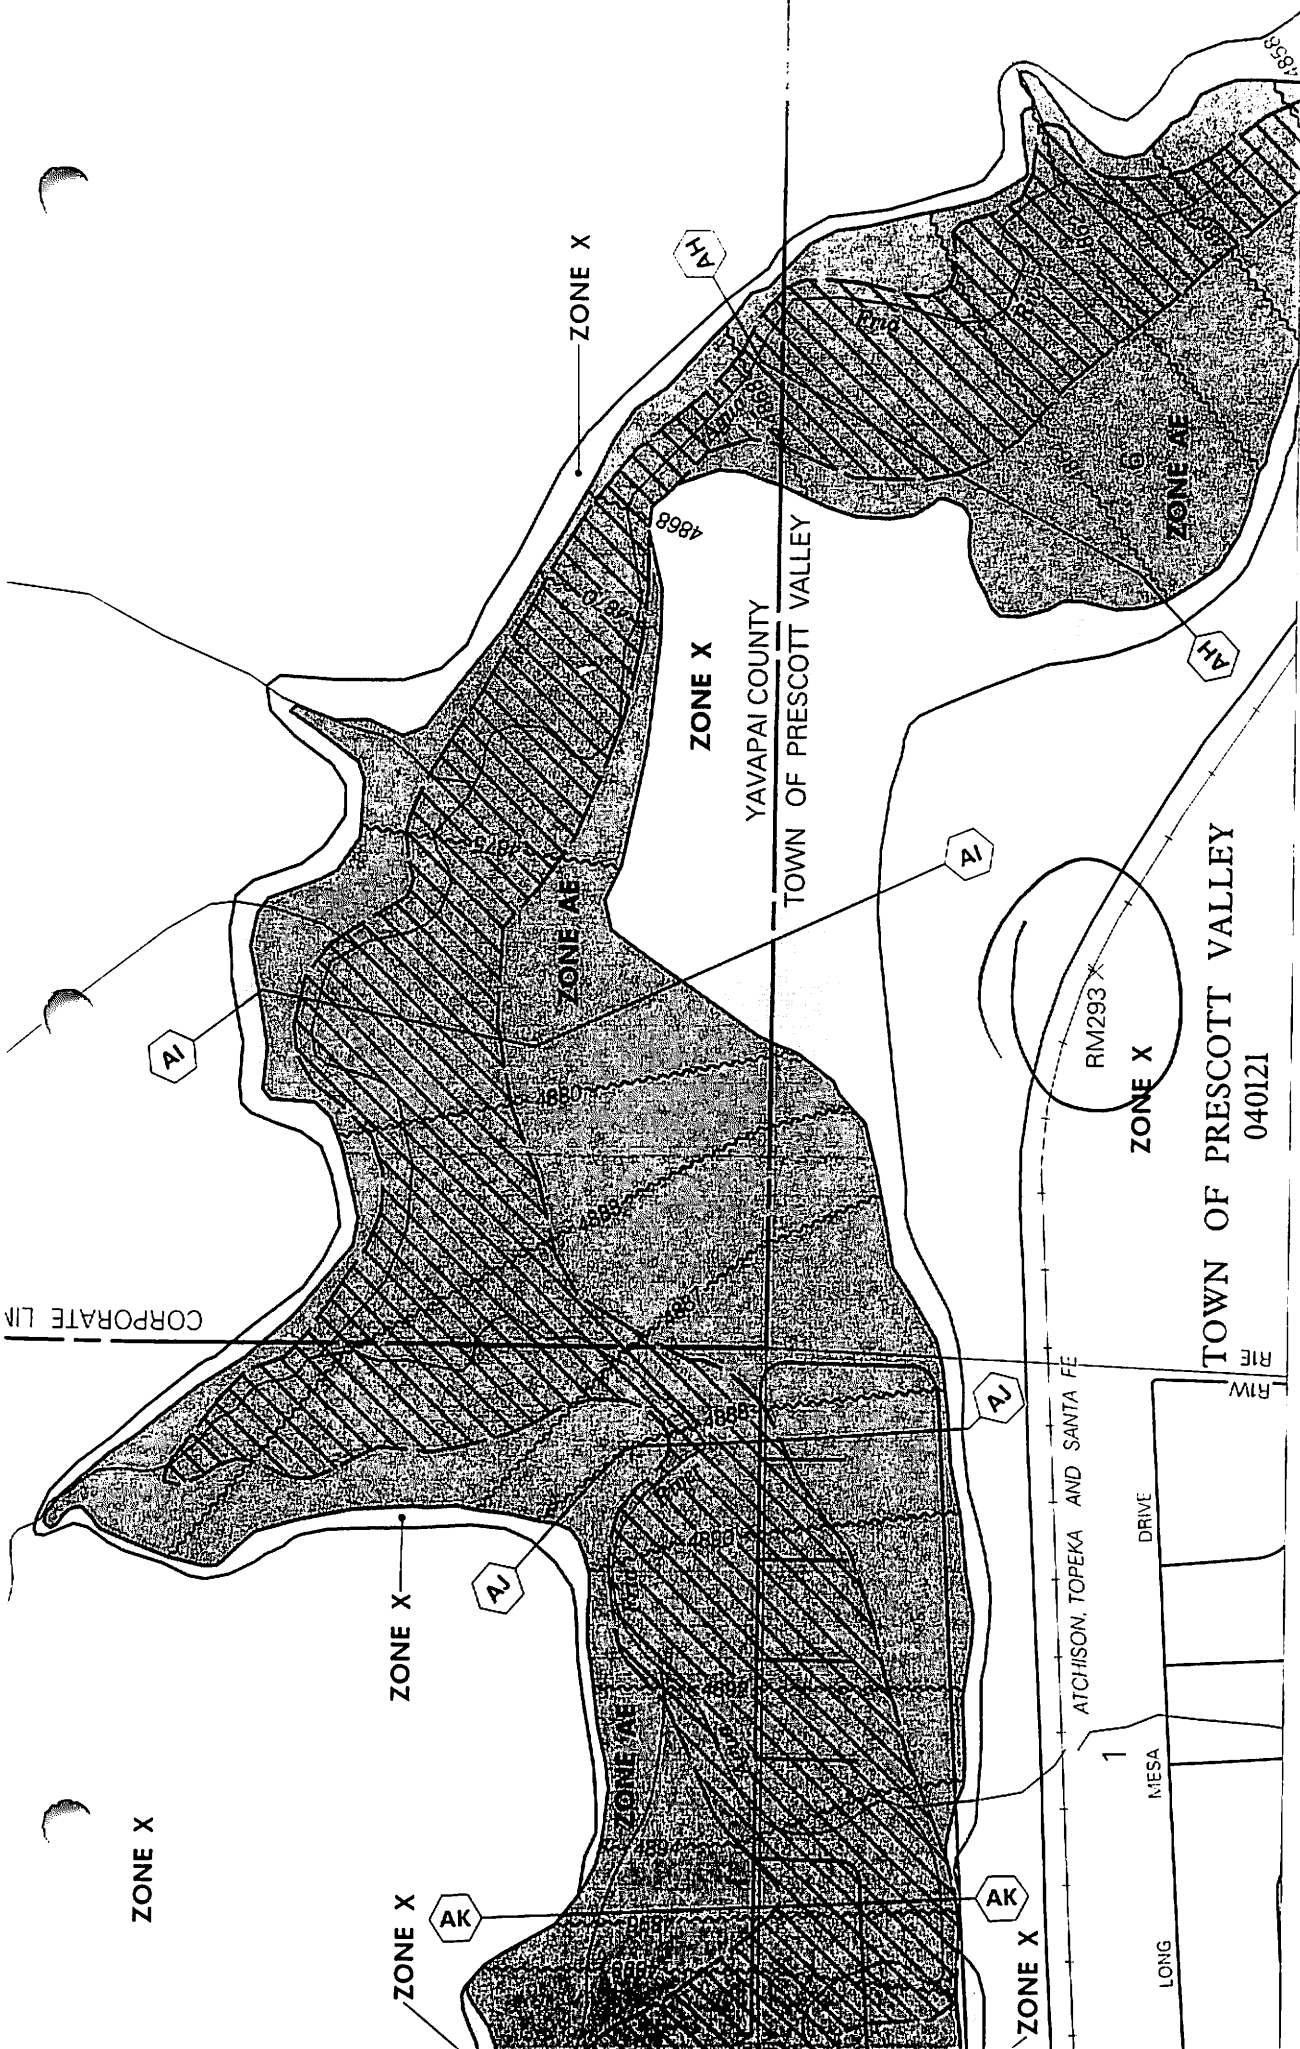

JOINS PANEL 2106

ZONE X

ZONE X

ZONE X

ZONE X

ZONE X

YAVAPAI COUNTY

TOWN OF PRESCOTT VALLEY

ZONE AF

ZONE X

TOWN OF PRESCOTT VALLEY

040121

RM293

ATCHISON, TOPEKA AND SANTA FE

DRIVE

MESA

LONG

RIVER

AI

AK

AK

4868

4868

AH

2

AI

AK

AH

4868