

ELEVATION REFERENCE MONUMENT

ERM: 109
Panel: 2215

Elevation (NAVD88): 3081.74
Elevation (NGVD29): 3079.40

Latitude: 34°32'38" N
Longitude: 111°51'23" W

Description: U.S. Army Corps of Engineers 5/8 inch rebar with aluminum cap stamped USCE VR 41 1977 LA DIST, 90 feet northwest of fence, 17 feet northeast of Fort McDowell Place.

ACE

2215

NATIONAL FLOOD INSURANCE PROGRAM

FIRM

FLOOD INSURANCE RATE MAP

**YAVAPAI COUNTY,
ARIZONA AND
INCORPORATED AREAS**

PANEL 2215 OF 3925

(SEE MAP INDEX FOR PANELS NOT PRINTED)

<u>CONTAINS</u> <u>COMMUNITY</u>	<u>NUMBER</u>	<u>PANEL</u>	<u>SUFFIX</u>
UNINCORPORATED AREAS	040093	2215	F

**MAP NUMBER
04025C2215 F**

**EFFECTIVE DATE:
JUNE 6, 2001**



Federal Emergency Management Agency


A


B

ELEVATION REFERENCE MARKS
 REFERENCE ELEVATION
 MARK (FEET NGVD) DESCRIPTION OF LOCATION

REFERENCE MARK	ELEVATION (FEET NGVD)	DESCRIPTION OF LOCATION
RM109	3079.40	U.S. Army Corps of Engineers 5/8-inch rebar with aluminum cap stamped USCE VR 41 1977 LA DIST, 90 feet northwest of fence, 17 feet northeast of Fort McDowell Place.
RM110	3072.74	U.S. Army Corps of Engineers 5/8-inch rebar with aluminum cap stamped USCE BM 5 1977 LA DIST, 13 feet southwest of highway, 14 feet southeast of powerpole, 7 feet northeast of fence.
RM115	3101.70	Aerial Mapping Company 1/2-inch rebar with aluminum cap stamped VR-BM 108, at the southwest quadrant of the intersection of Murdock Lane and Pioneer Drive, 0.5 foot north of the west cedar post fence corner, approximately 1,800 feet west and approximately 1,250 feet north of the southeast corner of Section 32, T14N, R5E.
RM116	3055.69	Aerial Mapping Company 1/2-inch rebar with aluminum cap stamped VR-BM 109, at the southeast fence corner of fence along the north side of Fir Street, approximately 350 feet east of Pearl Drive, approximately 1,900 feet east and approximately 1,300 feet south of the northwest corner of Section 7 T13N, R5E.
RM120	3086.67	From Camp Verde go southeast on General Crook Trail to the bridge over the Verde River. Station is located on the wall at the northwest corner of the bridge over the Verde River. Station is a brass cap.
RM124	3097.05	From the intersection of Salt Mine Road and Wood's Ditch, go south to the end of the dirt road and to the bridge over Wood's Ditch. Station is located at the east end of the north headwall. Station is a square bolt.
RM126	3098.75	From the intersection of Salt Mine Road and General Crook Trail, go west to Copper Canyon Wash and proceed south along Salt Mine Road approximately 1 mile to Lucky Canyon Wash. Station is located on the west bulkhead of a steel bridge. Station is the last river south in the center section of the bridge.
RM149	3044.40	U.S. Army Corps of Engineers 5/8-inch rebar with aluminum cap stamped USCE BM 14 1977 LA DIST, 28 feet southwest of Salt Mine Road, 62 feet north of fence.
RM150	3039.53	U.S. Army Corps of Engineers 5/8-inch rebar with aluminum cap stamped USCE BM 17 1977 LA DIST, 8 feet north-northeast from power pole at Y in dirt roads, 9 feet east of road.
RM151	3046.97	U.S. Army Corps of Engineers 5/8-inch rebar with aluminum cap stamped USCE RM 7 1977 LA DIST, 10 feet north-northeast from power pole at Y in dirt roads, 9 feet east of road.

III°52'30"
 34°33'45"

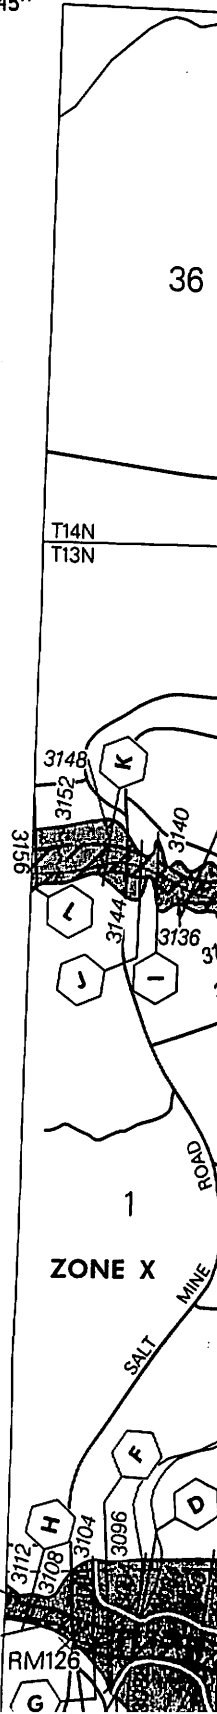

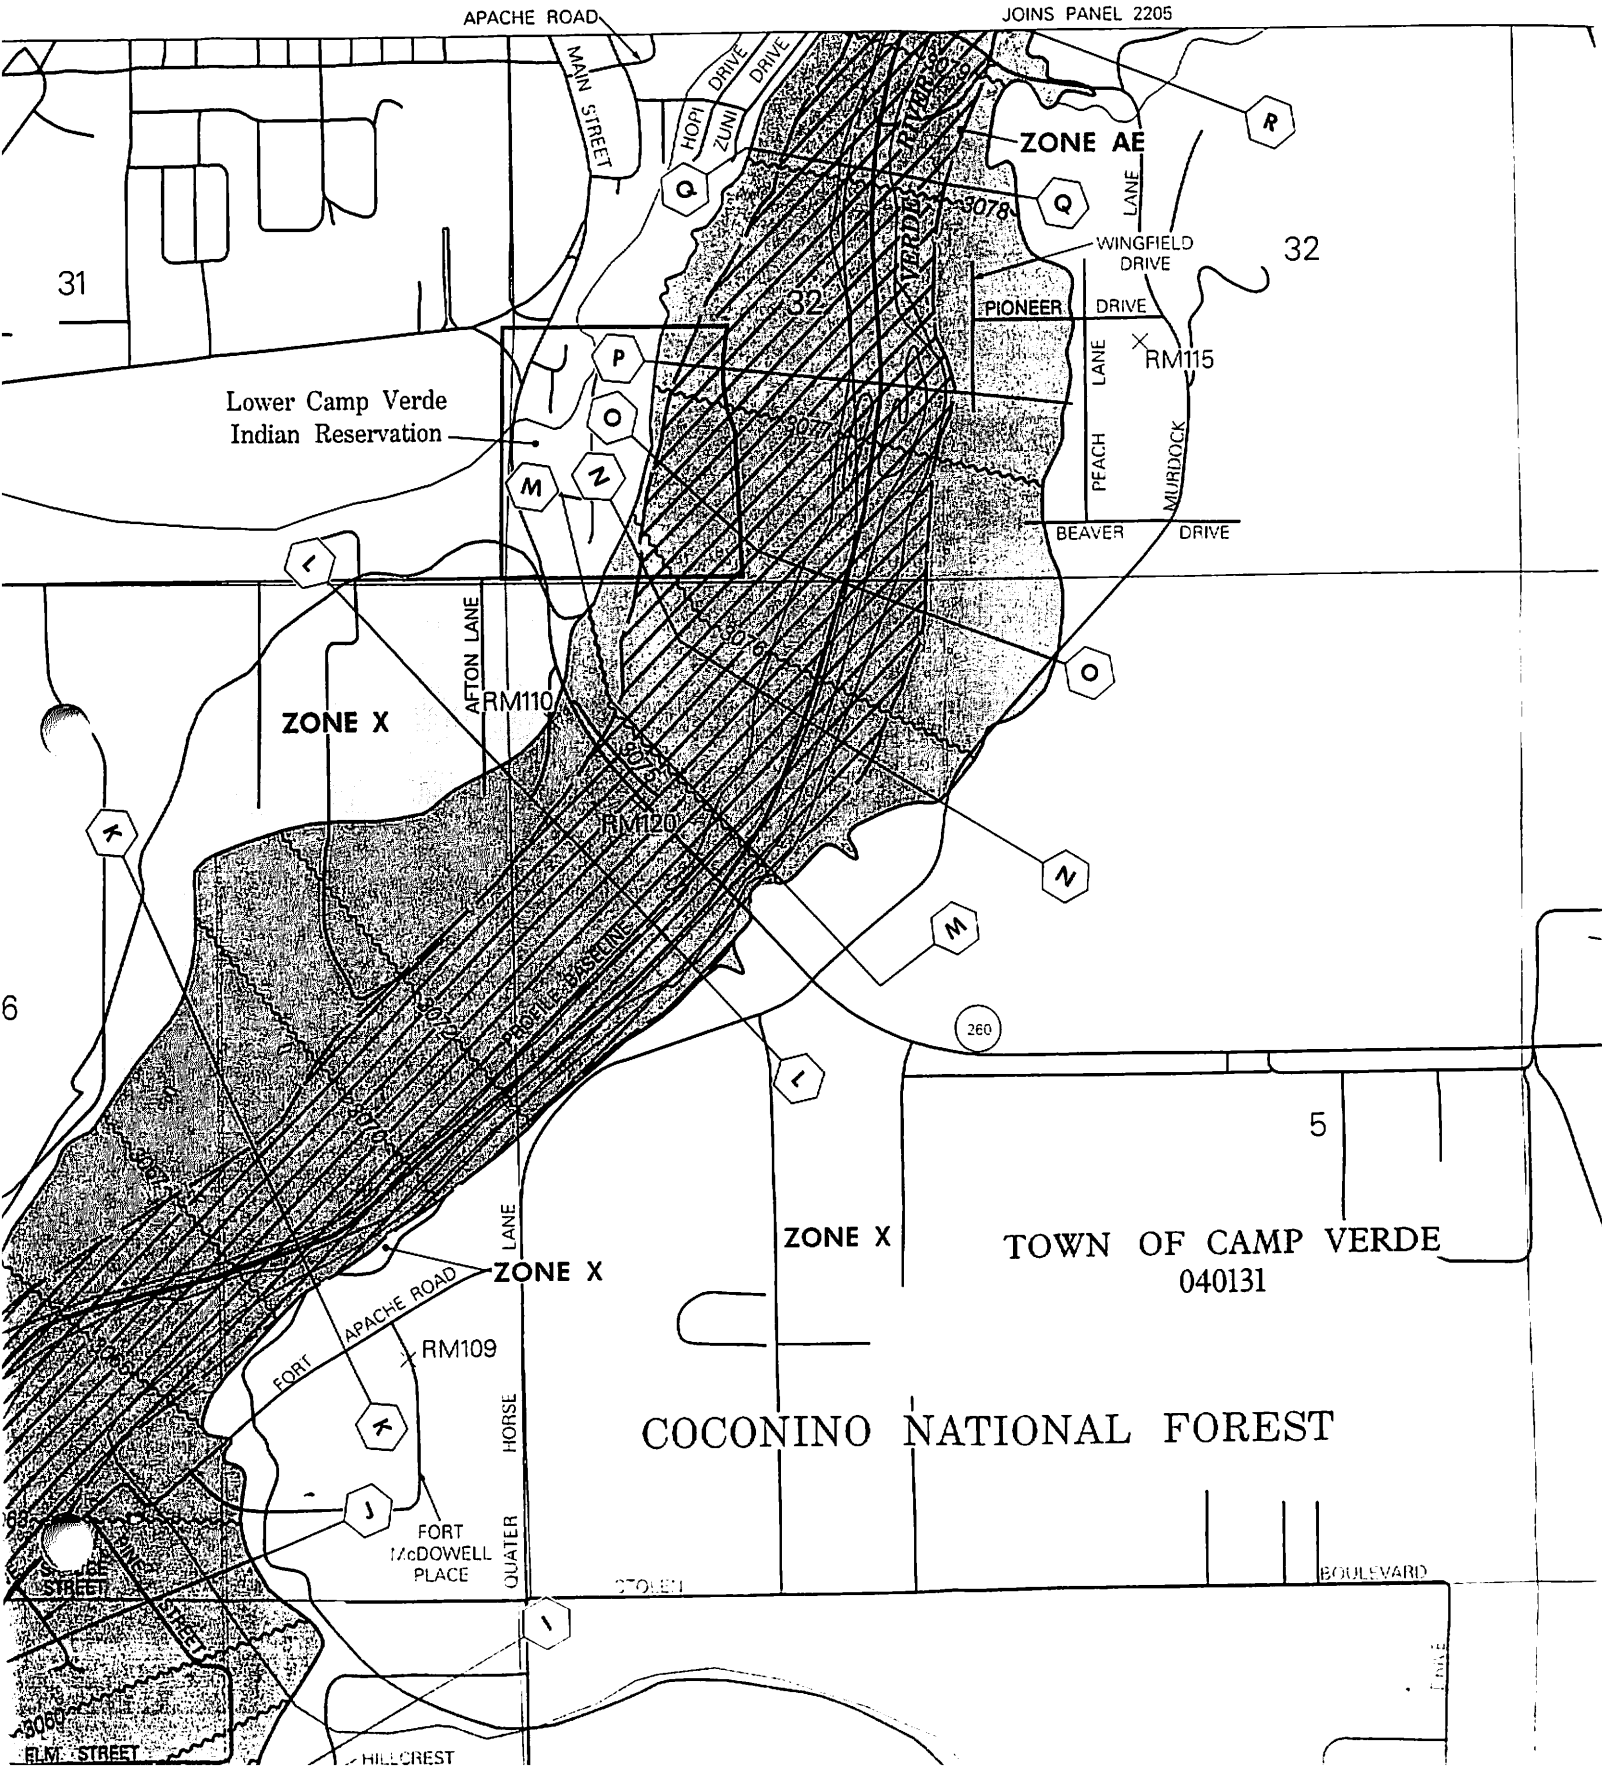

APACHE ROAD

JOINS PANEL 2205

31

32

Lower Camp Verde Indian Reservation

ZONE AE

3078

WINGFIELD DRIVE

PIONEER DRIVE

PEACH LANE

MURDOCK DRIVE

BEAVER DRIVE

ZONE X

AFTON LANE

RM110

RM120

260

6

5

ZONE X

TOWN OF CAMP VERDE
040131

ZONE X

COCONINO NATIONAL FOREST

RM109

FORT APACHE ROAD

HORSE QUATER PLACE

FORT McDOWELL PLACE

3079

BOULEVARD

ELM STREET

HILLCREST

3089