

PER TOM LUIZZO 9/3/2014:
ERM 2115_90 WAS DESTROYED.
A NEW ERM 2070_90B WAS SET IN IT'S PLACE.

ELEVATION REFERENCE MONUMENT

ERM: 90
Panel: 2115

Elevation (NAVD88): 5297.94
Elevation (NGVD29): 5295.00

Latitude: 34°33'02" N
Longitude: 112°22'32" W

Description: U.S. Geological Survey bronze cap on iron post stamped 5,287 PRSCT, approximately 2,600 feet north and approximately 800 feet east of southwest corner of Section 33, T14N, R1W, point is 1.06 feet above premark.

215

NATIONAL FLOOD INSURANCE PROGRAM

FIRM ORIGINAL
FLOOD INSURANCE RATE MAP
YAVAPAI COUNTY,
ARIZONA AND
INCORPORATED AREAS

PANEL 2115 OF 3925
(SEE MAP INDEX FOR PANELS NOT PRINTED)

<u>CONTAINS</u> <u>COMMUNITY</u>	<u>NUMBER</u>	<u>PANEL</u>	<u>SUFFIX</u>
PRESCOTT VALLEY TOWN OF	040121	2115	F
YAVAPAI COUNTY UNINCORPORATED AREAS	C40033	2115	F

MAP NUMBER
04025C2115 F


EFFECTIVE DATE:
JUNE 6, 2001



Federal Emergency Management Agency

A

B

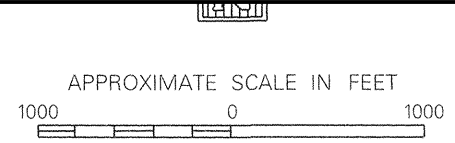

ELEVATION REFERENCE MARKS
REFERENCE ELEVATION MARK (FEET NGVD) DESCRIPTION OF LOCATION

RM90 5295.00 U.S. Geological Survey bronze cap on iron post stamped 5,287 PRSCT, approximately 2,600 feet north and approximately 800 feet east of southwest corner of Section 33, T14N, R1W, point is 1.06 feet above premark.

112°22'30"
 34°33'45"



NATIONAL FLOOD INSURANCE PROGRAM

FIRM
FLOOD INSURANCE RATE MAP

YAVAPAI COUNTY, ARIZONA AND INCORPORATED AREAS

PANEL 2115 OF 3925
 (SEE MAP INDEX FOR PANELS NOT PRINTED)

CONTAINS:

COMMUNITY	NUMBER	PANEL	SUFFIX
PRESCOTT VALLEY, TOWN OF	040121	2115	F
YAVAPAI COUNTY, UNINCORPORATED AREAS	040093	2115	F

MAP NUMBER
04025C2115 F

EFFECTIVE DATE:
JUNE 6, 2001



Federal Emergency Management Agency

This is an official copy of a portion of the above referenced flood map. It was extracted using F-MIT On-Line. This map does not reflect changes or amendments which may have been made subsequent to the date on the title block. For the latest product information about National Flood Insurance Program flood maps check the FEMA Flood Map Store at www.msc.fema.gov

1

2

B

C

112°22'30"
34°33'45"

JOINS PANE

CE MARKS
IPTION OF LOCATION

al Survey bronze cap on
stamped 5,287 PRSCT,
y 2,600 feet north and
y 800 feet east of
rner of Section 33,
oint is 1.06 feet above

