

ELEVATION REFERENCE MONUMENT

ERM: 169

Panel: 2905

Elevation (NAVD88): 3717.83

Elevation (NGVD29): 3715.57

Latitude: 34°19'04" N

Longitude: 112°07'02" W

Description: Aerial Mapping Company 1/2-inch rebar with aluminum cap, approximately 80 feet south-southwest of centerline Fremont Drive, approximately 2,800 feet south and approximately 1,700 feet west of approximate northeast corner of Section 23, T11N, R2E.

2905

NATIONAL FLOOD INSURANCE PROGRAM

FIRM ORIGINAL
FLOOD INSURANCE RATE MAP

**YAVAPAI COUNTY,
ARIZONA AND
INCORPORATED AREAS**

PANEL 2905 OF 3925

(SEE MAP INDEX FOR PANELS NOT PRINTED)

<u>CONTAINS</u> <u>COMMUNITY</u>	<u>NUMBER</u>	<u>PANEL</u>	<u>SUFFIX</u>
YAVAPAI COUNTY UNINCORPORATED AREAS	0402092	2905	F

**MAP NUMBER
04025C2905 F**

**EFFECTIVE DATE:
JUNE 6, 2001**



Federal Emergency Management Agency

11/12 2/3E A

B

Cordes Lake Topo

112°07'30"
34°22'30"

ELEVATION REFERENCE MARKS
 REFERENCE ELEVATION
 MARK (FEET NGVD) DESCRIPTION OF LOCATION


REFERENCE MARK	ELEVATION (FEET NGVD)	DESCRIPTION OF LOCATION
RM169	3715.57	Aerial Mapping Company 1/2-inch rebar with aluminum cap, approximately 80 feet southwest of centerline Fremont Drive, approximately 2,800 feet south and approximately 1,700 feet west of approximate northeast corner of Section 23, T11N, R2E.

1

T12N
T11N

ZONE X

2

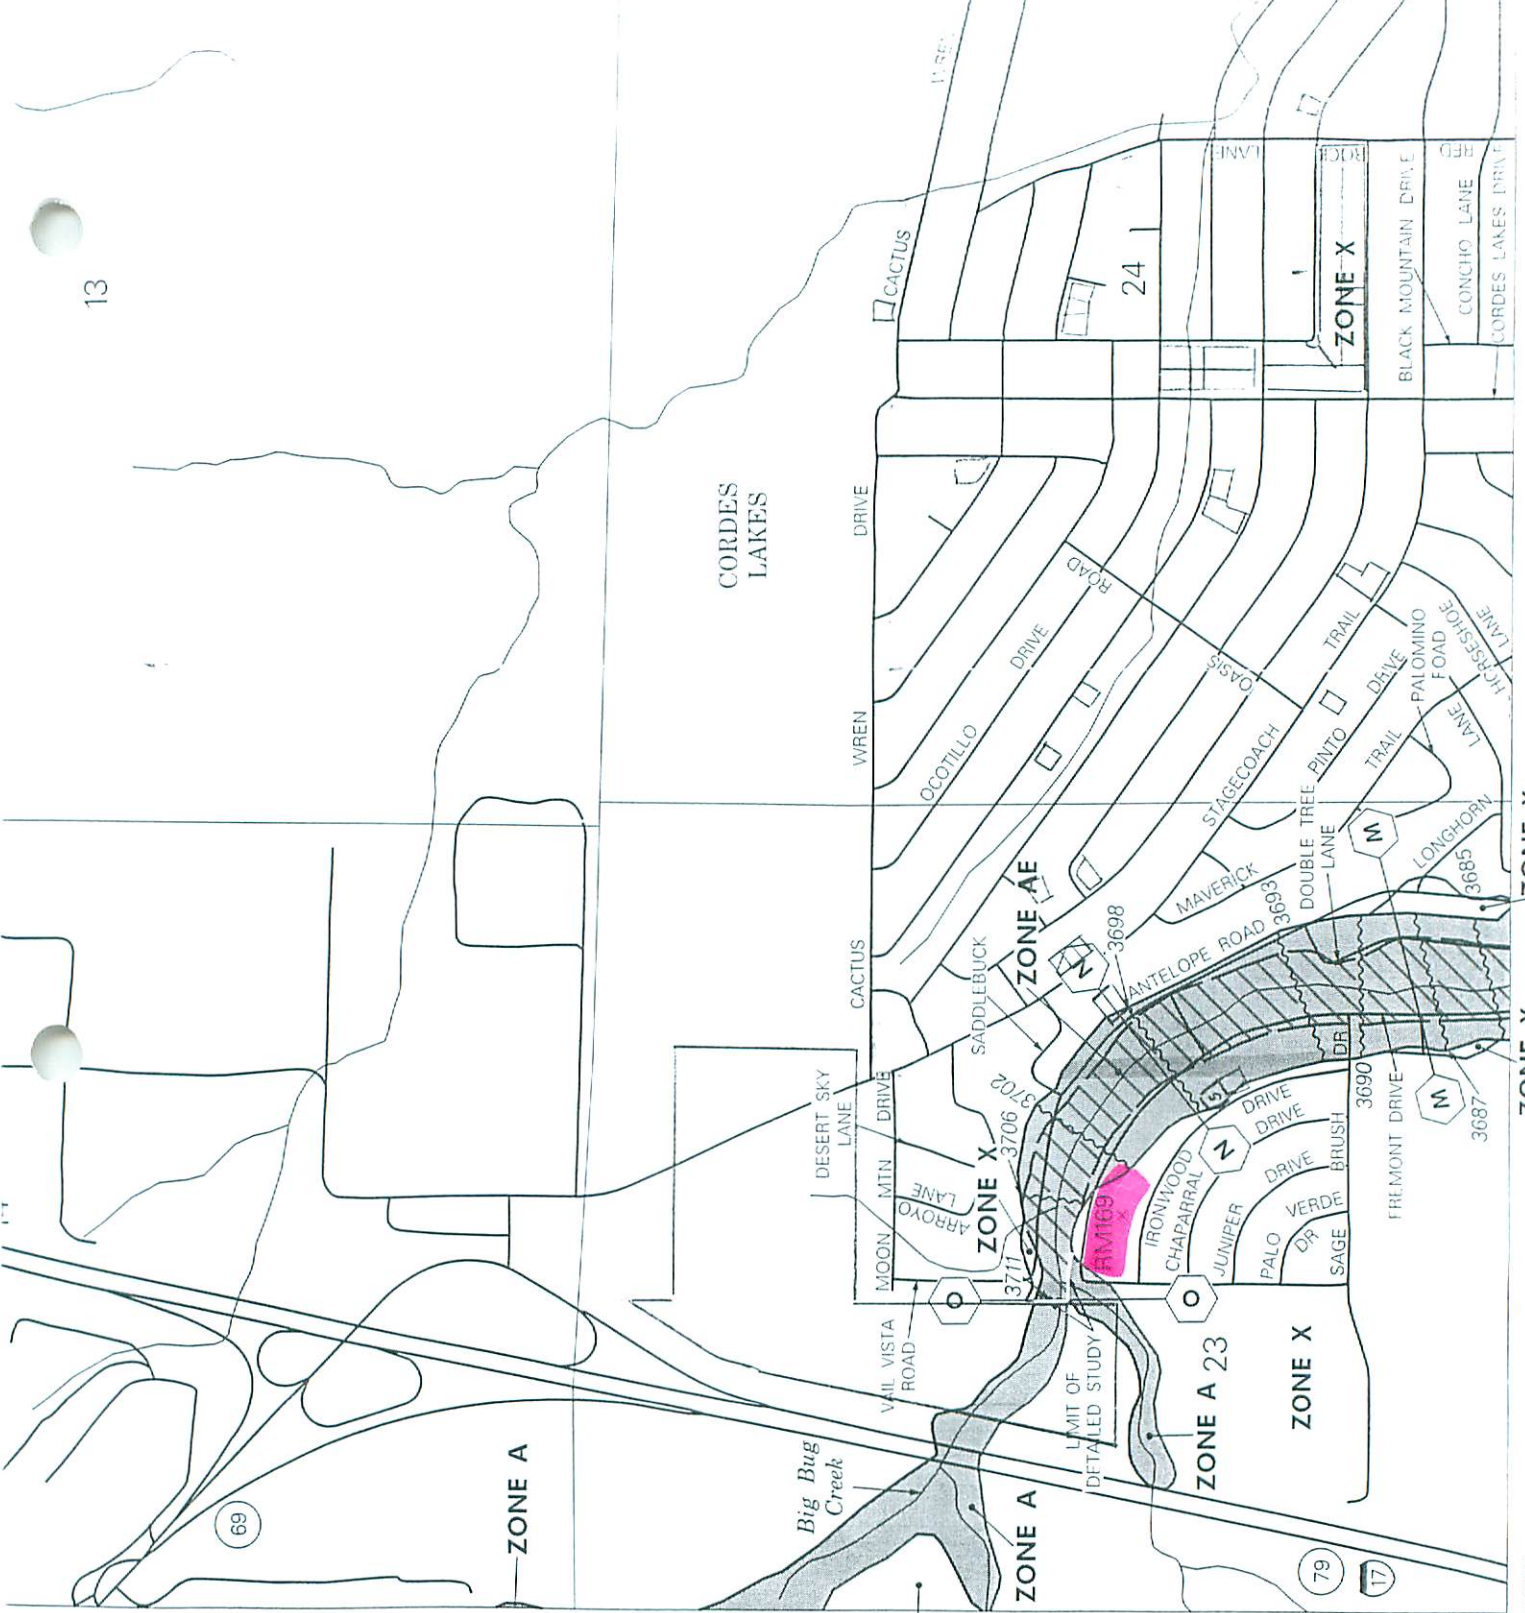

34°18'45"
112°07'30"

