

## ELEVATION REFERENCE MONUMENT

**ERM:** 168

**Panel:** 2915

**Elevation (NAVD88):** 3686.01

**Elevation (NGVD29):** 3683.76

**Latitude:** 34°18'27" N

**Longitude:** 112°06'55" W

**Description:** Aerial Mapping Company 1/2-inch rebar with aluminum cap, approximately 35 feet west of centerline Fremont Drive, approximately 45 feet north of wire fence, approximately 55 feet north-northwest of stock guard, approximately 1,250 feet south and approximately 950 feet west of approximate northeast corner of Section 26, T11N, R2E.

*Cordis*

2915

NATIONAL FLOOD INSURANCE PROGRAM

**FIRM**  **ORIGINAL**  
FLOOD INSURANCE RATE MAP

YAVAPAI COUNTY,  
ARIZONA AND  
INCORPORATED AREAS

PANEL 2915 OF 3925

(SEE MAP INDEX FOR PANELS NOT PRINTED)

CONTAINS  
COMMUNITY

NUMBER PANEL SUFFIX

YAVAPAI COUNTY  
UNINCORPORATED AREAS

040293

2915

F

MAP NUMBER  
04025C2915 F

EFFECTIVE DATE:  
JUNE 6, 2001



Federal Emergency Management Agency

16/11 2/3 E A

B

ELEVATION REFERENCE MARKS

REFERENCE MARK	ELEVATION (FEET NGVD)	DESCRIPTION OF LOCATION
----------------	-----------------------	-------------------------

RM167	3624.40	Aerial Mapping Company 1/2-inch rebar with aluminum cap, approximately 32 feet south of centerline of Fremont Drive, approximately 700 feet north and approximately 400 feet west of approximate southeast corner of Section 25, T11N, R2E.
RM168	3683.76	Aerial Mapping Company 1/2-inch rebar with aluminum cap, approximately 35 feet west of centerline Fremont Drive, approximately 45 feet north of wire fence, approximately 55 feet north-northwest of stock guard, approximately 1,250 feet south and approximately 950 feet west of approximate northeast corner of Section 26, T11N, R2E.

112°07'30"  
34°18'45"

17  
79

ZONE


UNIN

1

2

17

112°07'30"  
34°18'45"

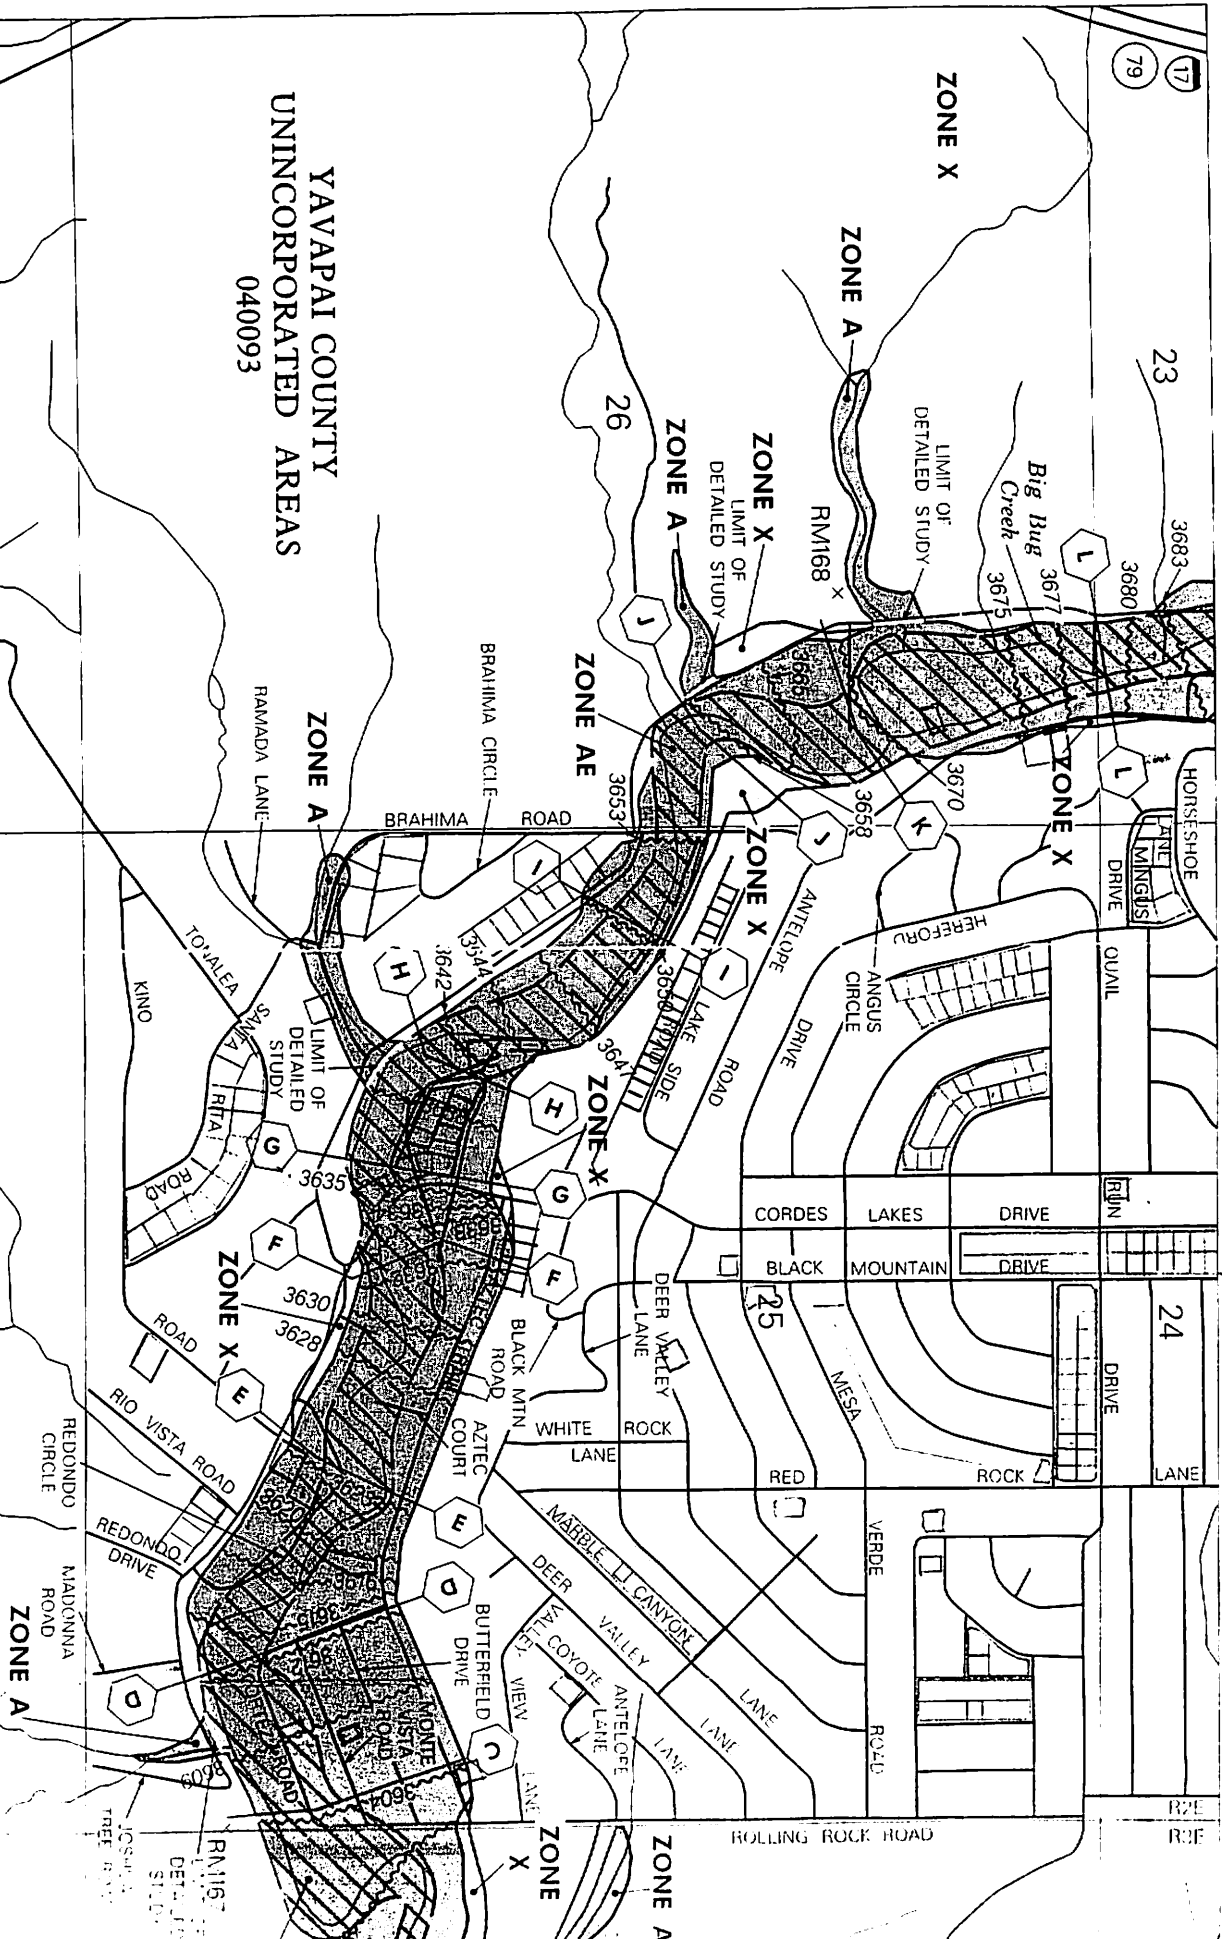

YAVAPAI COUNTY  
UNINCORPORATED AREAS  
040093

\* See Cordes Lakes

SEE CORDES LAKES A

JONES & BROWN