

ELEVATION REFERENCE MONUMENT

ERM: 19
Panel: 990

Elevation (NAVD88): 4408.07
Elevation (NGVD29): 4405.42

Latitude: 34°54'39" N
Longitude: 112°29'17" W

Description: From Paulden, Arizona, go north on Highway 89 approximately 0.6 miles to Big Chino Road, then west (left) on Big Chino Road approximately 1.3 miles to Patricia Road, Then north (right) on Patricia Road approximately 0.7 miles to monument.

990

NATIONAL FLOOD INSURANCE PROGRAM

FIRM  **ORIGINAL**
FLOOD INSURANCE RATE MAP

YAVAPAI COUNTY,
ARIZONA AND
INCORPORATED AREAS

PANEL 990 OF 3925
(SEE MAP INDEX FOR PANELS NOT PRINTED)

| <u>CONTAINS:</u> <u>COMMUNITY</u> | <u>NUMBER</u> | <u>PANEL</u> | <u>SUFFIX</u> |
|---|---------------|--------------|---------------|
| YAVAPAI COUNTY, UNINCORPORATED AREAS | 040093 | 0990 | F |

MAP NUMBER
04025C0990 F

EFFECTIVE DATE:
JUNE 6, 2001




Federal Emergency Management Agency

0"

ELEVATION REFERENCE MARKS
 REFERENCE ELEVATION
 MARK (FEET NGVD) DESCRIPTION OF LOCATION


| | | |
|------|---------|--|
| RM12 | 4371.24 | Yavapai County Flood Control District, 1/2-inch rebar with aluminum cap stamped RM49-2, LS 12218, located 2 feet north of northwest corner of wood and steel railroad bridge over Big Chino Washington, near the northeast corner of Section 5 in T17N, R2W. |
| RM18 | 4414.64 | From Paulden, Arizona, go north on Highway 89 approximately 0.6 mile to Big Chino Road, then west (left) on Big Chino Road approximately 1.3 miles to Patricia Road, then north (right) on Patricia Road approximately 0.7 mile to Bayberry Drive, then east (right) on Bayberry Drive approximately 0.6 mile to monument. |
| RM19 | 4405.42 | From Paulden, Arizona, go north on Highway 89 approximately 0.6 mile to Big Chino Road, then west (left) on Big Chino Road approximately 1.3 miles to Patricia Road, then north (right) on Patricia Road approximately 0.7 mile to monument. |
| RM20 | 4491.87 | From Paulden, Arizona, go north on Highway 89 approximately 0.6 mile to Big Chino Road, then west (left) on Big Chino Road approximately 1.3 miles to Patricia Road, then north (right) on Patricia Road approximately 1.8 miles to Ahonen Road, then east (right) on Ahonen Road approximately 0.7 mile to monument. |
| RM21 | 4393.82 | From Paulden, Arizona, go north on Highway 89 approximately 0.6 mile to Big Chino Road, then west (left) on Big Chino Road approximately 0.75 mile to Naples Street, then north (right) on Naples Street approximately 0.5 mile to Grand Canyon Road, then east (right) on Grand Canyon Road 0.1 mile to monument. |
| RM22 | 4393.79 | From Paulden, Arizona, go north on Highway 89 approximately 0.8 mile to Laguna Trail, then west (left) on Laguna Trail 0.3 mile to monument. |
| RM23 | 4400.46 | From Paulden, Arizona, go north on Highway 89 approximately 1.0 mile to monument. |
| RM24 | 4155.70 | From Paulden, Arizona, go north on Highway 89 approximately 1.8 miles, then west (left) on Bramble Drive approximately 0.1 mile to Enid Drive approximately 0.1 mile to Aspen Drive, then west (left) on Aspen Drive approximately 0.2 mile to monument. |
| RM25 | 4452.77 | From Paulden, Arizona, go north on Highway 89 approximately 1.1 miles to Verde Ranch Road, then east (right) on Verde Ranch Road approximately 0.5 mile to old railroad grade and monument. |
| RM26 | 4439.11 | From Paulden, Arizona, go north on Highway 89 approximately 0.6 mile to Big Chino Road, then west (left) on Big Chino Road approximately 0.75 mile to Naples Street, then north (right) on Naples Street approximately 0.9 mile to Bayberry Drive, then east (right) on Bayberry Drive approximately 0.6 mile to monument. |

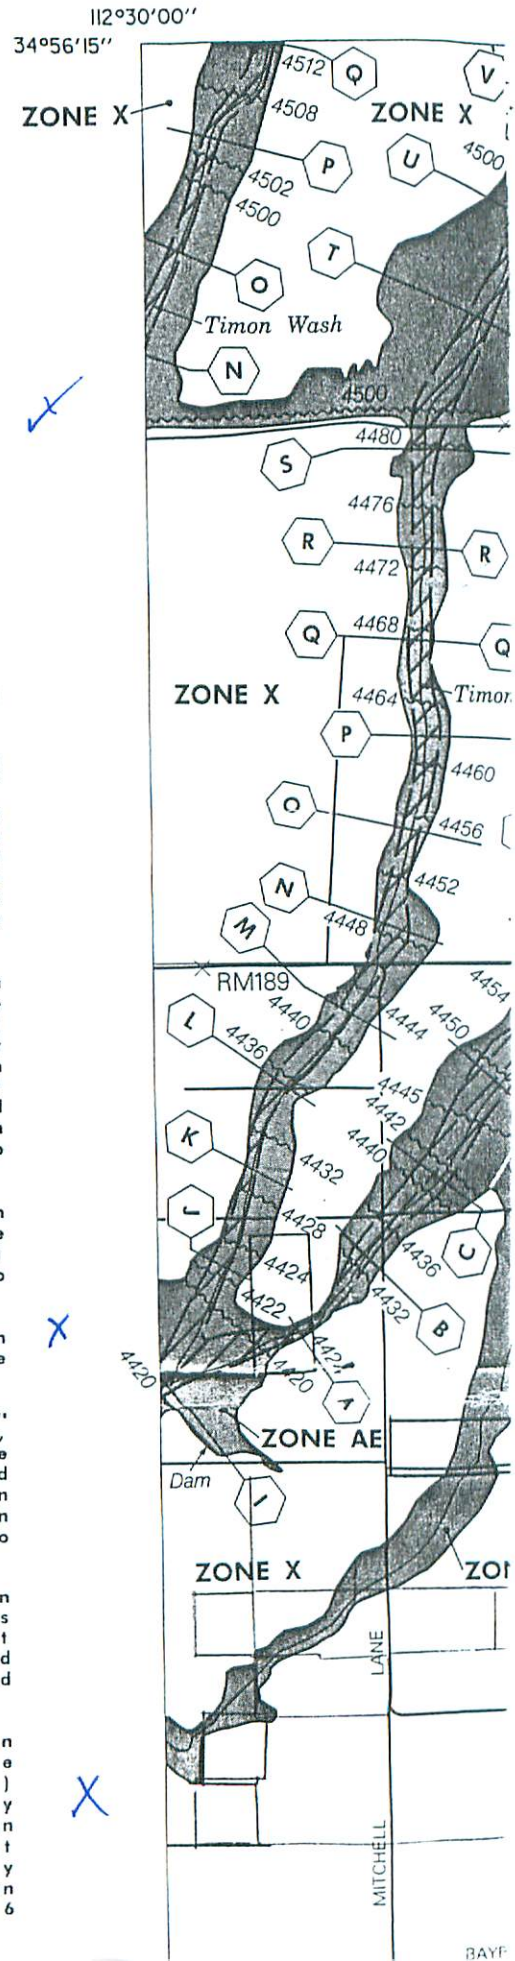

1

2

3

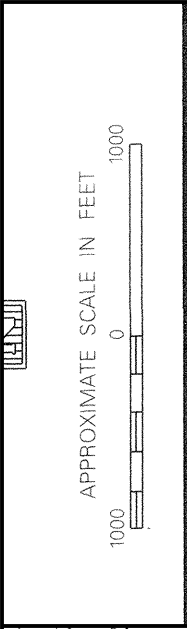

NATIONAL FLOOD INSURANCE PROGRAM


FIRM
FLOOD INSURANCE RATE MAP
 YAVAPAI COUNTY,
 ARIZONA AND
 INCORPORATED AREAS

PANEL 990 OF 3925
 (SEE MAP INDEX FOR PANELS NOT PRINTED)

| CONTAINS: | COMMUNITY | NUMBER | PANEL | SUFFIX |
|-------------------------------------|-----------|--------|-------|--------|
| YAVAPAI COUNTY UNINCORPORATED AREAS | | 040250 | 0990 | F |

MAP NUMBER
0402500990 F

EFFECTIVE DATE:
JUNE 6, 2001



Federal Emergency Management Agency

This is an official copy of a portion of the above referenced flood map. It was extracted using F-MIT On-Line. This map does not reflect changes or amendments which may have been made subsequent to the date on the title block. For the latest product information about National Flood Insurance Program flood maps, check the FEMA Flood Map Store at www.msc.fema.gov

