

## ELEVATION REFERENCE MONUMENT

**ERM:** 80  
**Panel:** 1705

**Elevation (NAVD88):** 4785.37

**Elevation (NGVD29):** 4782.67

**Latitude:** 34°44'18" N

**Longitude:** 112°29'33" W

**Description:** 1/2-inch rebar with an aluminum cap marked Vaughan 14216. From Chino Valley at the intersection of Highway 89 and Center Street, travel west 1.7 miles to Reed Road. South on Reed Road 1/2 mile to Road 1 south. West on Road 1 south 1/2 mile. Station is approximately 60 feet north of the centerline of the dirt road.

1705

**NATIONAL FLOOD INSURANCE PROGRAM**

**FIRM**

ORIGINAL

**FLOOD INSURANCE RATE MAP**

**YAVAPAI COUNTY,  
ARIZONA AND  
INCORPORATED AREAS**

**PANEL 1705 OF 3925**

(SEE MAP INDEX FOR PANELS NOT PRINTED)

CONTAINS  
COMMUNITY

NUMBER PANEL SUFFIX

CHINO VALLEY TOWN OF YAVAPAI COUNTY	040294	1705	F
INCORPORATED AREAS	040295	1705	F


**MAP NUMBER  
04025C1705 F**

**EFFECTIVE DATE:  
JUNE 6, 2001**



Federal Emergency Management Agency

REFERENCE MARK	ELEVATION (FEET NGVD)	DESCRIPTION OF LOCATION
RM7	4758.55	From Chino Valley at the intersection of Highway 89 and Center Street, travel west 2.3 miles to a dirt road heading south. Station is 40 feet south of Center Street, 50 feet east of the southbound dirt road. Station is a 1/2-inch rebar with an aluminum cap marked 14,216.
RM78	4808.67	From Chino Valley at the intersection of Highway 89 and Center Street, south 1.0 mile to Road 2-5. West 2.2 miles past Reed Road. Station is on the north side of the road, approximately 150 feet southeast of the brown 2-story house, and approximately 50 feet north of the centerline of Road 2-5. Station is a 1/2-inch rebar with an aluminum cap marked Vaughn 14216.
RM80	4782.67	From Chino Valley at the intersection of Highway 89 and Center Street, travel west 1.7 miles to Reed Road. South on Reed Road 1/2 mile to a dirt road on the west side. West on the dirt road 1/2 mile. Station is approximately 60 feet north of the centerline of the dirt road. Station is a 1/2-inch rebar with an aluminum cap marked Vaughn 14216.
RM233	4805.56	Standard Yavapai County Flood Control District 2 aluminum cap marked RLS 13941 #1. Located north of Road 4 south, west of Outlaw Road 332.22 feet, S87-01-00E of S1/4 Section 35; 2,400, 17 feet, S88-51-21 W of southwest Section; 2.7 feet north side of power pole, 97 feet south side of corner fence post #2, 4.37 feet south side of fence post #1.
RM234	4723.27	Standard Yavapai County Flood Control District 2 aluminum cap marked RLS 1394 #2 located 21 feet south of Road 1 south, 85 feet west of the centerline of Santa Cruz Wash, 2.2 feet south side of a power pole, 2.55 feet south side of a power pole, 2,654.30 feet, N89-52-29W of W1/4 of Section 26; 2,741.73 feet, N89-08-23E of east 1/4 of Section 26.

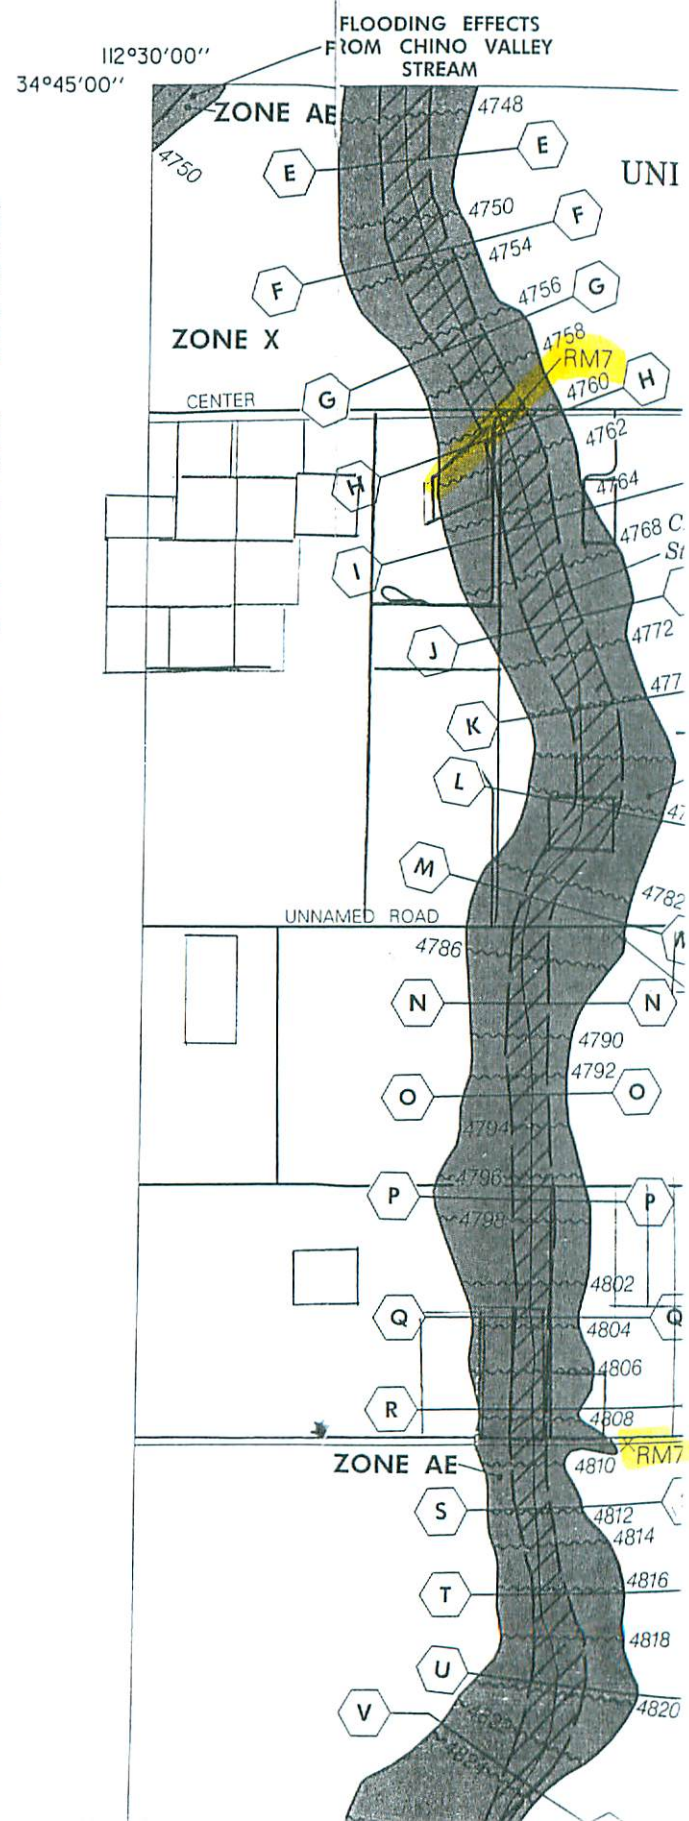

NCE MARKS  
 RIPION OF LOCATION

no Valley at the  
 n of Highway 89 and  
 treet, travel west  
 to a dirt road heading  
 tion is 40 feet south of  
 eet, 50 feet east of the  
 dirt road. Station is a  
 bar with an aluminum cap  
 16.

no Valley at the  
 n of Highway 89 and  
 eet, south 1.0 mile to  
 West 2.2 miles past Reed  
 ion is on the north side  
 , approximately 150 feet  
 of the brown 2-story  
 approximately 50 feet  
 e centerline of Road 2-  
 n is a 1/2-inch rebar  
 minium cap marked Vaughn

no Valley at the  
 n of Highway 89 and  
 eet, travel west 1.7  
 eed Road. South on Reed  
 ile to a dirt road on  
 ide. West on the dirt  
 mile. Station is  
 ly 60 feet north of the  
 of the dirt road.  
 a 1/2-inch rebar with an  
 p marked Vaughan 14216.

Yavapai County Flood  
 strict 2 aluminum cap  
 1394 #1. Located north  
 south, west of Outlaw  
 2 feet, S87-01-00E of  
 on 35; 2,400, 17 feet,  
 W of southwest Section;  
 rth side of power pole,  
 th side of corner fence  
 .37 feet south side of  
 #1.

Yavapai County Flood  
 strict 2 aluminum cap  
 1394 #2 located 21 feet  
 ad 1 south, 85 feet west  
 nterline of Santa Cruz  
 feet south side of a  
 2.55 feet south side of  
 le, 2,654.30 feet, N89-  
 W1/4 of Section 26;  
 eet, N89-08-23E of east  
 ion 26.

