

ELEVATION REFERENCE MONUMENT

ERM: 139

Panel: 2045

Elevation (NAVD88): 4531.98

Elevation (NGVD29): 4529.10

Latitude: 34°30'00" N

Longitude: 112°40'03" W

Description: Aerial Mapping Company 1/2-inch rebar with aluminum cap on top of a hill, approximately 150 feet northwest of a dirt road centerline, approximately 225 feet west-northwest of a sharp curve in said dirt road, approximately 2,100 feet west and approximately 1,400 feet south of the northeast corner of Section 3, T13N, R4W.

2045

NATIONAL FLOOD INSURANCE PROGRAM

FIRM  **ORIGINAL**
FLOOD INSURANCE RATE MAP

**YAVAPAI COUNTY,
ARIZONA AND
INCORPORATED AREAS**

PANEL 2045 OF 3925
(SEE MAP INDEX FOR PANELS NOT PRINTED)

<u>CONTAINS:</u> <u>COMMUNITY</u>	<u>NUMBER</u>	<u>PANEL</u>	<u>SUFFIX</u>
YAVAPAI COUNTY, UNINCORPORATED AREAS	040093	2045	F

**MAP NUMBER
04025C2045 F**

**EFFECTIVE DATE:
JUNE 6, 2001**



Federal Emergency Management Agency

3/14 3/40 A


B

112°41'15"
34°33'45"

ELEVATION REFERENCE MARKS

REFERENCE MARK	ELEVATION (FEET NGVD)	DESCRIPTION OF LOCATION
----------------	-----------------------	-------------------------


- | | | |
|-------|---------|--|
| RM138 | 4258.08 | U.S. Geological Survey pipe and brass cap cemented in a 3-foot diameter concrete pad, BM 4250 PRSCT at Skull Valley, approximately 250 feet southwest of the railroad crossing and the main highway, approximately 150 feet west of the Atkinson, Topeka and Santa Fe railway track centerline, approximately 50 feet west of a paved road centerline, in a front yard next to the Skull Valley General Store and Post Office. |
| RM139 | 4529.10 | Aerial Mapping Company 1/2-inch rebar with aluminum cap on top of a hill, approximately 150 feet northwest of a dirt road centerline, approximately 225 feet west-northwest of a sharp curve in said dirt road, approximately 2,100 feet west and approximately 1,400 feet south of the northeast corner of Section 3, T13N, R4W. |

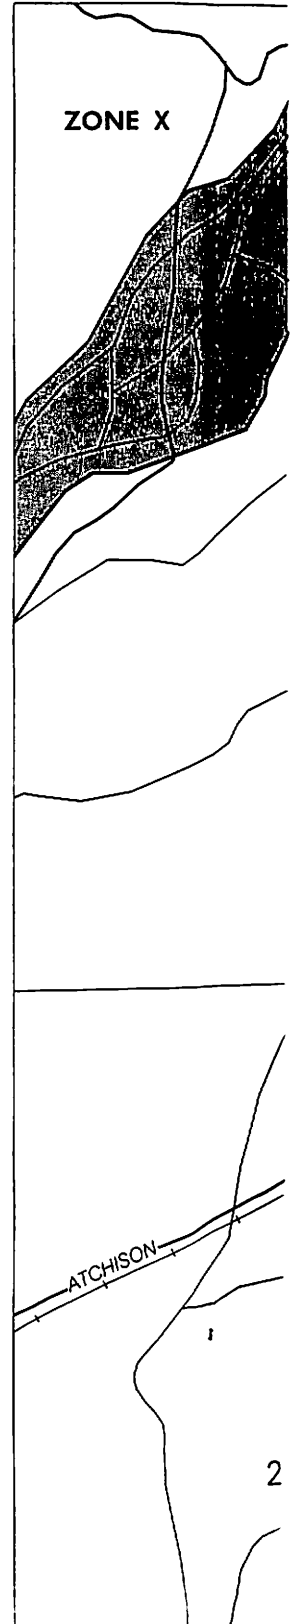

1

2

2

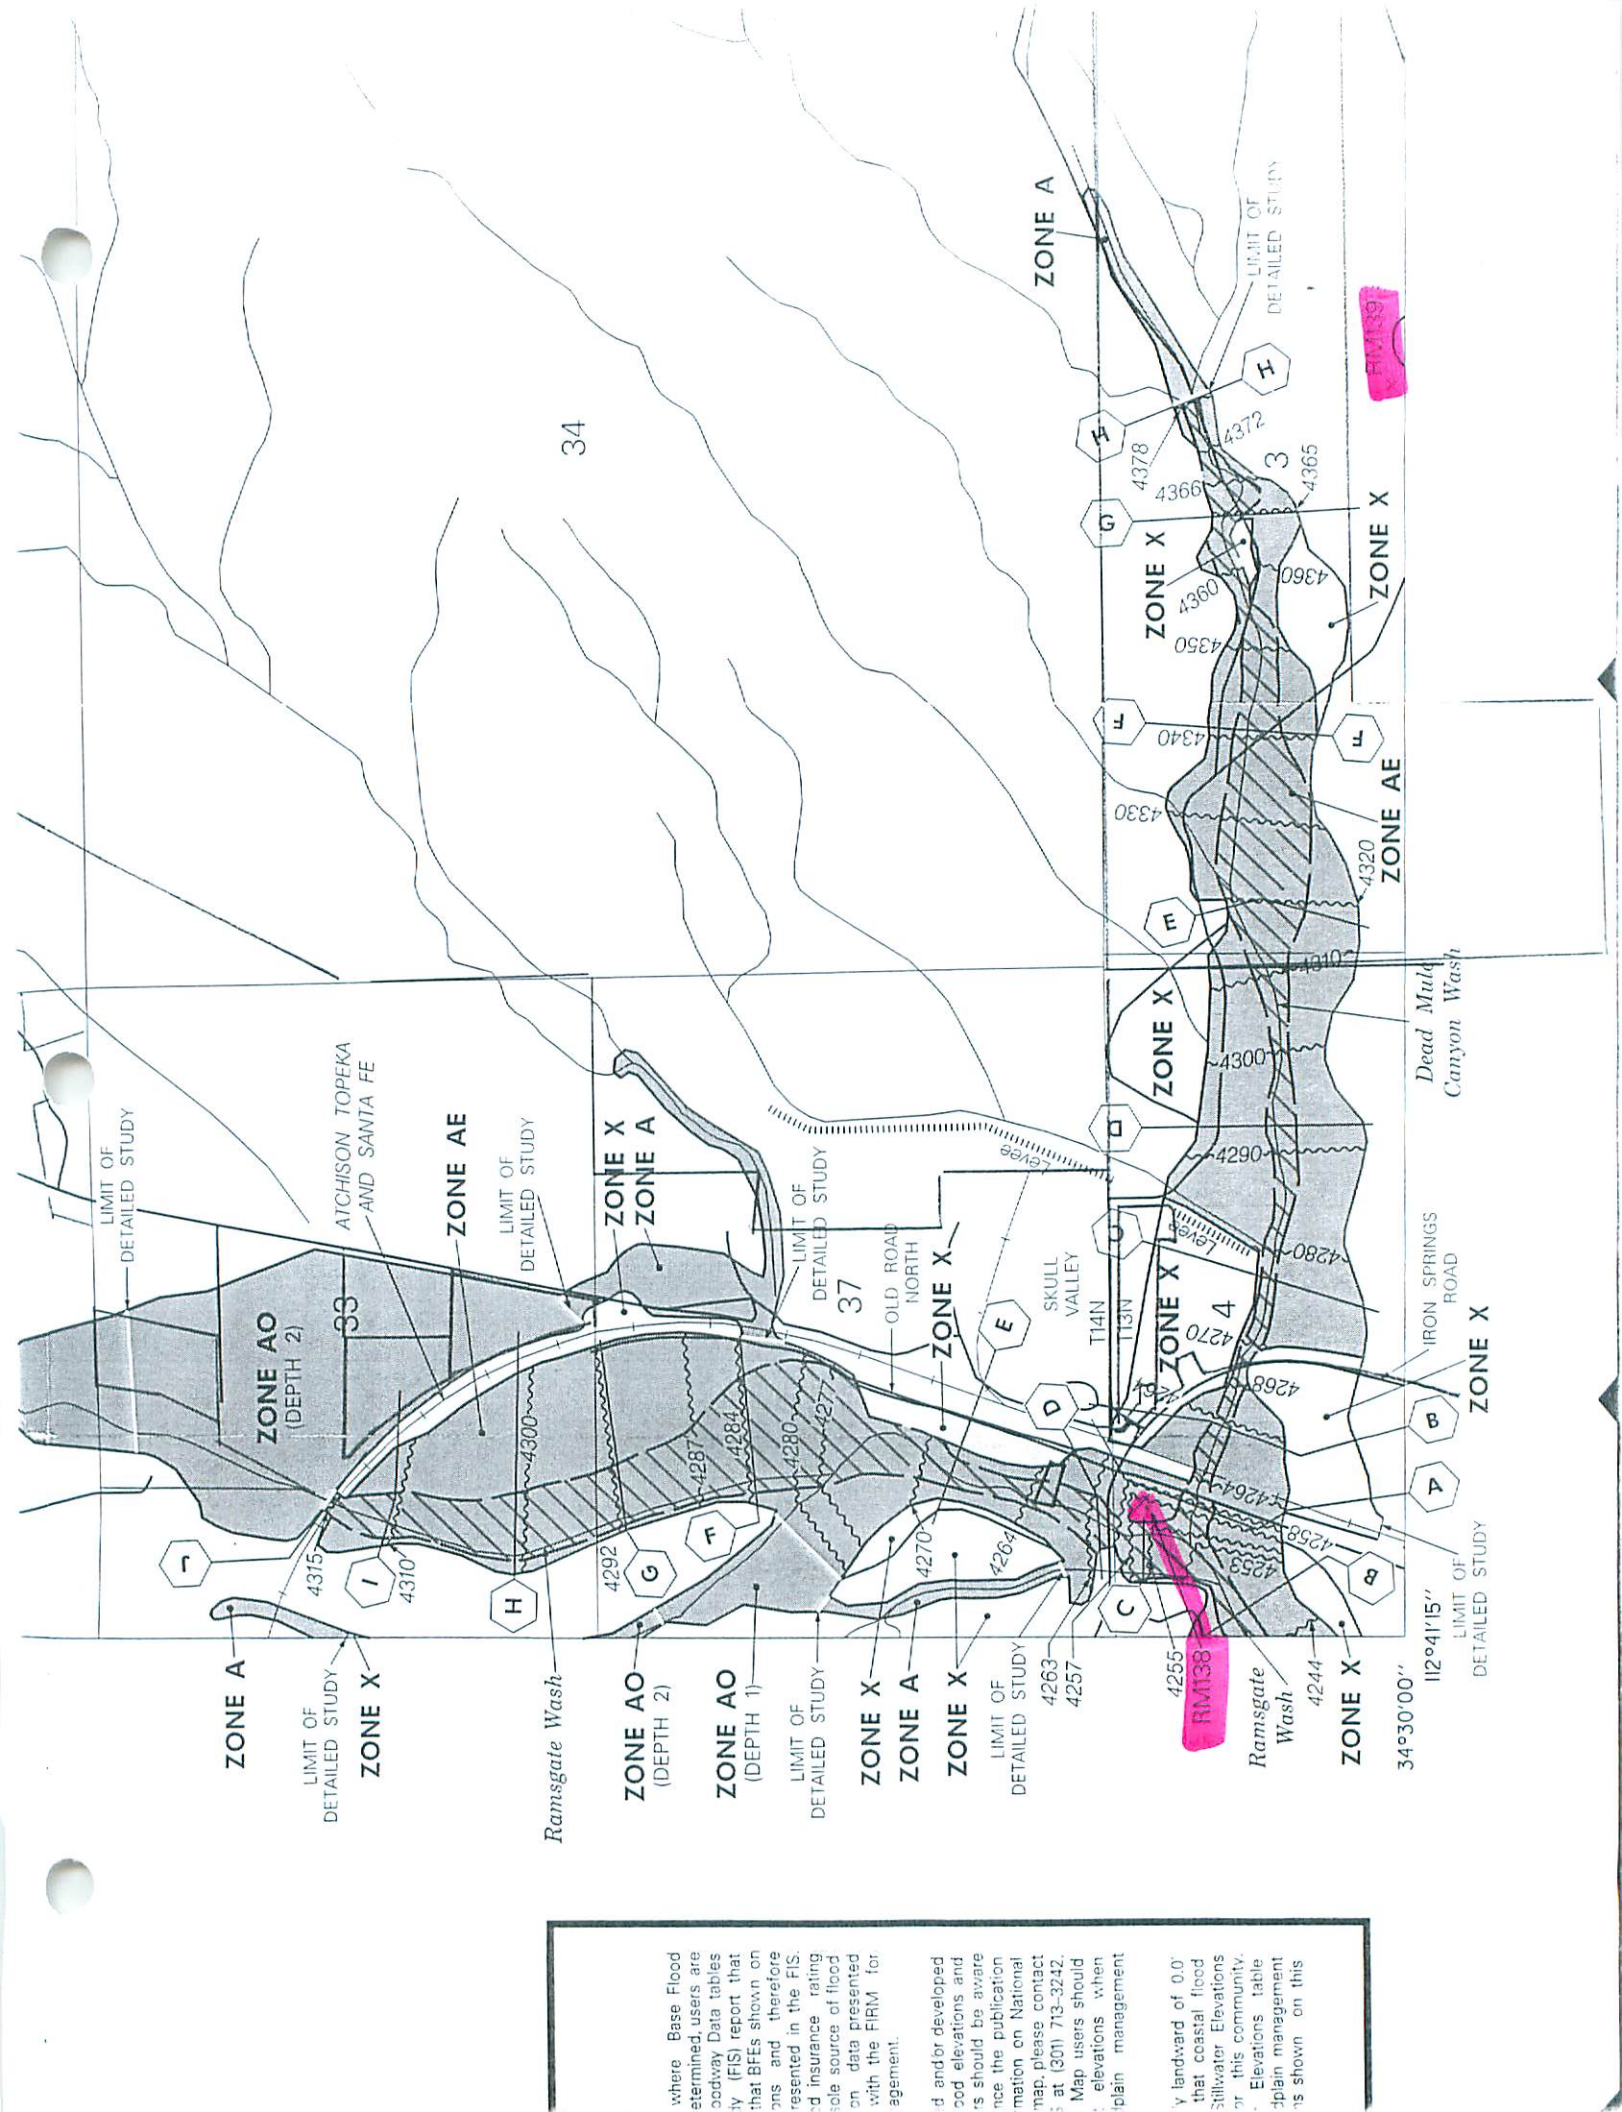

where Base Flood determined, users are roadway Data tables by (FIS) report that that BFEs shown on ons and therefore presented in the FIS. and insurance rating sole source of flood on data presented with the FIRM for agement.

and/or developed od elevations and is should be aware nce the publication tion on National map, please contact s at (301) 713-3242. Map users should elevations when plain management

ward of 0.0' that coastal flood Stillwater Elevations or this community. Elevations table plain management is shown on this