

## ELEVATION REFERENCE MONUMENT

**ERM:** 94

**Panel:** 2103

**Elevation (NAVD88):** 5092.10

**Elevation (NGVD29):** 5089.24

**Latitude:** 34°34'32" N

**Longitude:** 112°21'08" W

**Description:** Aerial Mapping Company 1/2-inch rebar with aluminum cap, approximately 1,260 feet north and approximately 2,870 feet west of southeast corner of Section 22, T14N, R1W, located approximately 75 feet north of main flowline, in small lake area, approximately 50 feet south of a large dirt pile, approximately 500 feet northwest of concrete dam, approximately 20 feet, from centerline of dirt trail.

2103

**NATIONAL FLOOD INSURANCE PROGRAM**

**FIRM ORIGINAL**  
**FLOOD INSURANCE RATE MAP**

**YAVAPAI COUNTY,  
ARIZONA AND  
INCORPORATED AREAS**

**PANEL 2103 OF 3925**

(SEE MAP INDEX FOR PANELS NOT PRINTED)

CONTAINS:  
COMMUNITY

|  | <u>NUMBER</u> | <u>PANEL</u> | <u>SUFFIX</u> |
|--|---------------|--------------|---------------|
| PRESOTT VALLEY TOWN OF<br>YAVAPAI COUNTY | 040101        | 2103         | F             |
| UNINCORPORATED AREAS                     | 040000        | 2103         | F             |

**MAP NUMBER  
04025C2103 F**

**EFFECTIVE DATE:  
JUNE 6, 2001**




Federal Emergency Management Agency


14N 1W A

B

112°22'30"  
34°35'37"

ELEVATION REFERENCE MARKS  
REFERENCE ELEVATION  
MARK (FEET NGVD) DESCRIPTION OF LOCATION

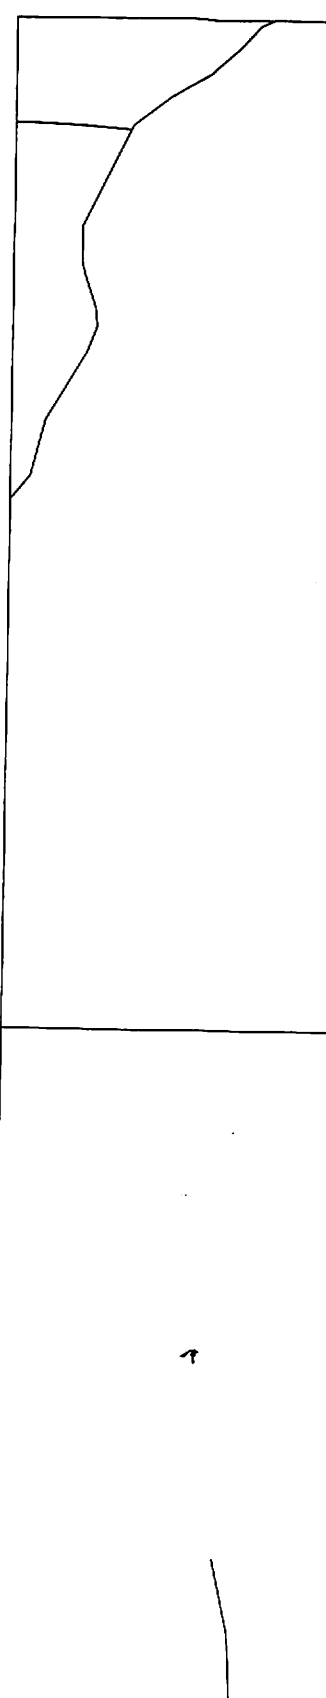- 1
- RM89 5196.60 Aerial Mapping Company 1/2-inch rebar with aluminum cap, approximately 2,100 feet north and 2,000 feet west of southeast corner of Section 28, T14N, R1W, located approximately 1,170 feet east of Y intersection in dirt road (follow North Fork) and approximately 145 feet north of flow line of Lynx Creek.
- RM94 5089.24 Aerial Mapping Company 1/2-inch rebar with aluminum cap, approximately 1,260 feet north and approximately 2,870 feet west of southeast corner of Section 22, T14N, R1W, located approximately 75 feet north of main flowline, in small lake area, approximately 50 feet south of a large dirt pile, approximately 500 feet northwest of concrete dam, approximately 20 feet from centerline of dirt trail.
- 2
- 

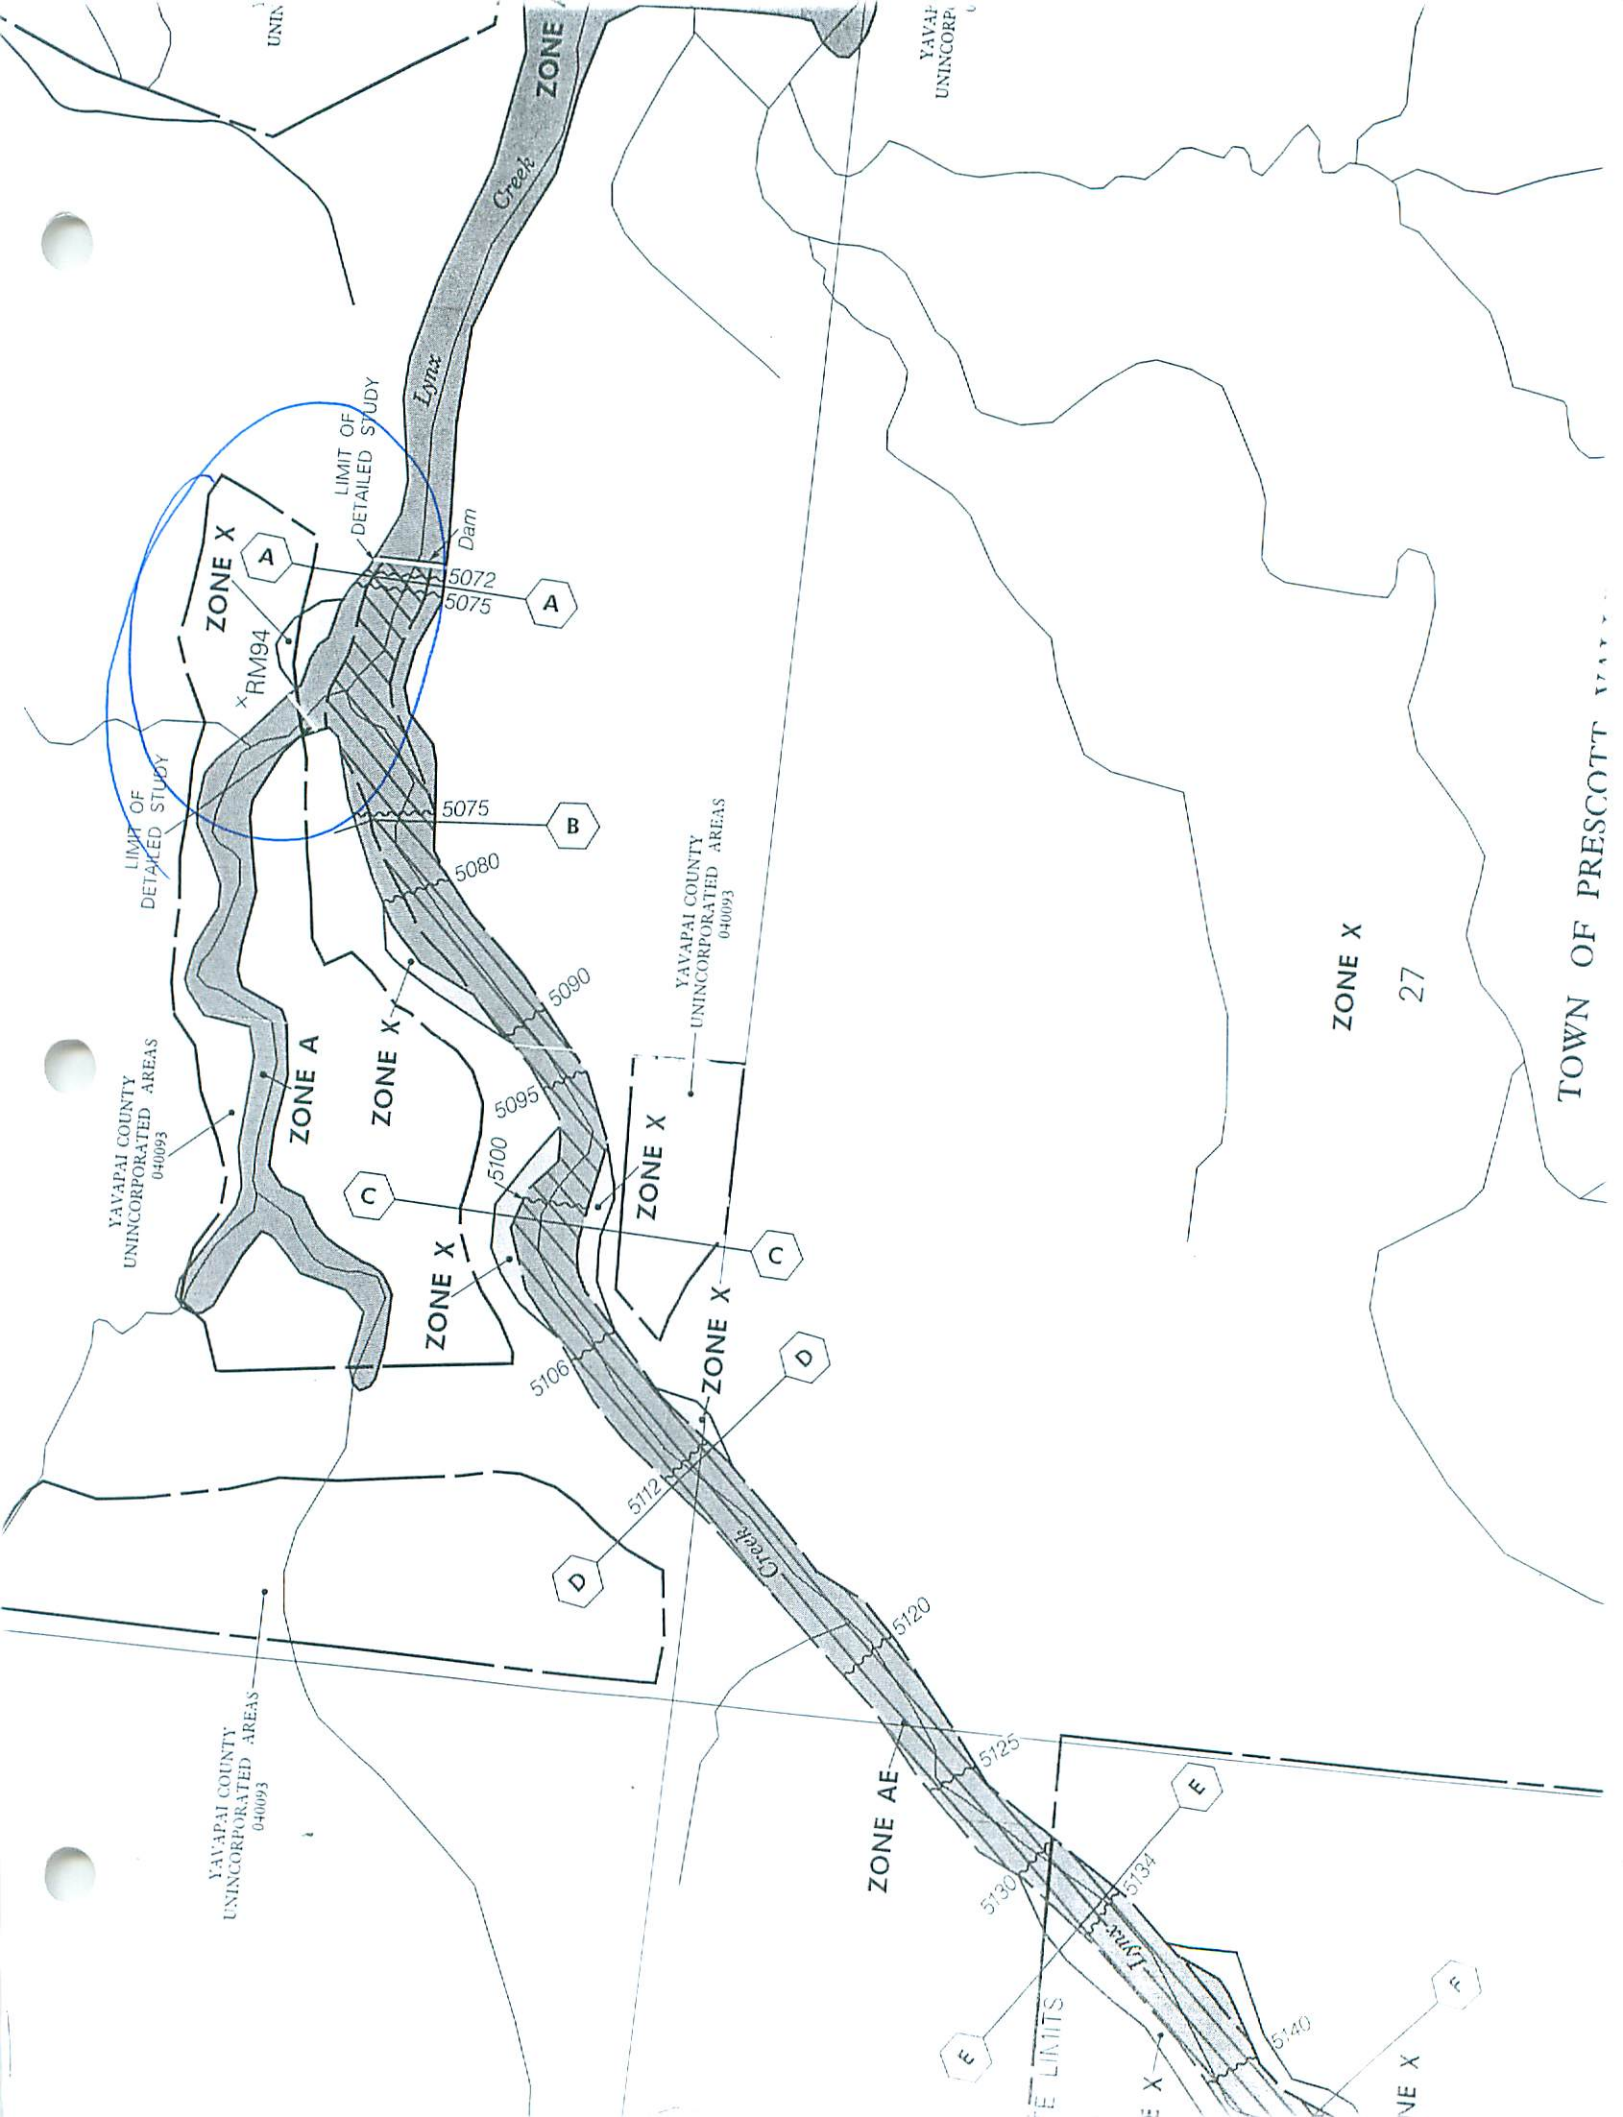

UNIN

YAVAPAI UNINCORP.

Creek  
Lynx  
Creek  
Lynx

Dam

ZONE X

A

LIMIT OF DETAILED STUDY

5072

5075

A

LIMIT OF DETACHED STUDY

RM94

5075

B

5080

5090

5095

5100

5106

5112

5120

5125

5130

5134

5140

YAVAPAI COUNTY UNINCORPORATED AREAS 040093

ZONE A

ZONE X

C

ZONE X

ZONE X

ZONE X

ZONE X

ZONE X

ZONE X

YAVAPAI COUNTY UNINCORPORATED AREAS 040093

ZONE X

C

D

D

YAVAPAI COUNTY UNINCORPORATED AREAS 040093

ZONE AE

E LIMITS

E X

NE X

ZONE X

27

TOWN OF PRESCOTT