

## ELEVATION REFERENCE MONUMENT

**ERM:** 146  
**Panel:** 2140

**Elevation (NAVD88):** 4575.48  
**Elevation (NGVD29):** 4572.82

**Latitude:** 34°31'46" N  
**Longitude:** 112°13'36" W

**Description:** 1/2-inch rebar with an aluminum cap marked Vaughn 14216. From the intersection of Highway 69 and Highway 169, east approximately 0.9 mile to an asphalt turnout on the north side of Highway 169. Station is at the center of the paved area approximately 30 feet north of the centerline of Highway 169.

HCE

2140

**NATIONAL FLOOD INSURANCE PROGRAM**

**FIRM**

**FLOOD INSURANCE RATE MAP**

**YAVAPAI COUNTY,  
ARIZONA AND  
INCORPORATED AREAS**

**PANEL 2140 OF 3925**

(SEE MAP INDEX FOR PANELS NOT PRINTED)

CONTAINS

COMMUNITY

NUMBER

PANEL

SUFFIX

YAVAPAI COUNTY  
ON INCORPORATED AREAS

040091

2140

F

**MAP NUMBER  
04025C2140 F**

**EFFECTIVE DATE:  
JUNE 6, 2001**



Federal Emergency Management Agency

A

B

112°15'00"  
34°33'45"

ELEVATION REFERENCE MARKS  
 REFERENCE MARK (FEET NGVD) DESCRIPTION OF LOCATION

RM95 4594.77 Aerial Mapping Company 1/2-inch rebar with aluminum cap, approximately 50 feet east of Highway 69, on approximate Township line, approximately 300 feet west of approximate south 1/4 corner of Section 34, T14N, R1E.

WAS 83  
(COND)


RM142 4483.66 Aerial Mapping Company 1/2-inch rebar with aluminum cap, approximately 30 feet west of Holiday Drive, approximately 18 feet southeast of fence corner, approximately 850 feet north and approximately 2,000 feet west of approximate southeast corner of Section 14, T13N, R1E.

RM143 4524.11 Aerial Mapping Company 1/2-inch rebar with aluminum cap, approximately 30 feet west of dirt road, approximately 20 feet northwest of power pole, approximately 100 feet southwest of intersection with farm road, approximately 400 feet north and approximately 1,000 feet east of approximate southwest corner of Section 11, T13N, R1E.

RM144 ~~4585.87~~ 4582.87 U.S. Geological Survey station Dewey 1969, as described; standard disk on soil pipe approximately 20 feet west of centerline dirt road to Henderson Cemetery, approximately 850 feet north and approximately 1,800 feet east of approximate southwest corner of Section 2, T13N, R1E.

RM145 4618.21 From the intersection of Highway 69 and Highway 169, east on Highway 169 1.3 miles to a dirt road on the north side. North 2 miles to a residence on the right. West approximately 200 feet through a barbed wire fence corral to a brass cap that is 0.8 foot east of the north/south fence. Station is the 1/4 corner of Sections 1 and 2, T13N, R1E. Station is a 1/2-inch rebar with an aluminum cap marked Vaughn 14216.

RM146 4572.82 From the intersection of Highway 69 and Highway 169, east approximately 0.9 mile to an asphalt turnout on the north side of Highway 169. Station is at the center of the paved area approximately 30 feet north of the centerline of Highway 169. Station is a 1/2-inch rebar with an aluminum cap marked Vaughn 14216.

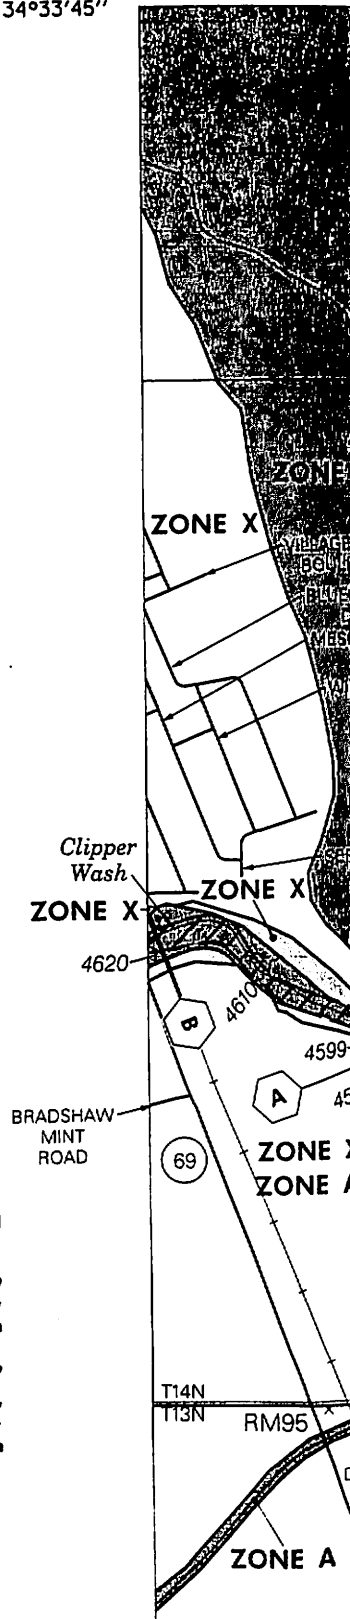

1

2

1969

