

ELEVATION REFERENCE MONUMENT

ERM: 120

Panel: 2215

Elevation (NAVD88): 3088.99

Elevation (NGVD29): 3086.67

Latitude: 34°33'06" N

Longitude: 111°51'08" W

Description: A brass cap. From Camp Verde go southeast on General Crook Trail to the bridge over the Verde River. Station is located on the wall at the northwest corner of the bridge over the Verde River.

ACE

2215

NATIONAL FLOOD INSURANCE PROGRAM

FIRM

FLOOD INSURANCE RATE MAP

**YAVAPAI COUNTY,
ARIZONA AND
INCORPORATED AREAS**

PANEL 2215 OF 3925

(SEE MAP INDEX FOR PANELS NOT PRINTED)

<u>CONTAINS</u> <u>COMMUNITY</u>	<u>NUMBER</u>	<u>PANEL</u>	<u>SUFFIX</u>
UNINCORPORATED AREAS	040093	2215	F

**MAP NUMBER
04025C2215 F**

**EFFECTIVE DATE:
JUNE 6, 2001**



Federal Emergency Management Agency

A


B



III°52'30"
34°33'45"

ELEVATION REFERENCE MARKS

REFERENCE MARK	ELEVATION (FEET NGVD)	DESCRIPTION OF LOCATION
RM109	3079.40	U.S. Army Corps of Engineers 5/8-inch rebar with aluminum cap stamped USCE VR 41 1977 LA DIST, 90 feet northwest of fence, 17 feet northeast of Fort McDowell Place.
RM110	3072.74	U.S. Army Corps of Engineers 5/8-inch rebar with aluminum cap stamped USCE BM 5 1977 LA DIST, 13 feet southwest of highway, 14 feet southeast of powerpole, 7 feet northeast of fence.
RM115	3101.70	Aerial Mapping Company 1/2-inch rebar with aluminum cap stamped VR-BM 108, at the southwest quadrant of the intersection of Murdock Lane and Pioneer Drive, 0.5 foot north of the west cedar post fence corner, approximately 1,800 feet west and approximately 1,250 feet north of the southeast corner of Section 32, T14N, R5E.
RM116	3055.69	Aerial Mapping Company 1/2-inch rebar with aluminum cap stamped VR-BM 109, at the southeast fence corner of fence along the north side of Fir Street, approximately 350 feet east of Pearl Drive, approximately 1,900 feet east and approximately 1,300 feet south of the northwest corner of Section 7 T13N, R5E.
RM120	3086.67	From Camp Verde go southeast on General Crook Trail to the bridge over the Verde River. Station is located on the wall at the northwest corner of the bridge over the Verde River. Station is a brass cap.
RM124	3097.05	From the intersection of Salt Mine Road and Wood's Ditch, go south to the end of the dirt road and to the bridge over Wood's Ditch. Station is located at the east end of the north headwall. Station is a square bolt.
RM126	3098.75	From the intersection of Salt Mine Road and General Crook Trail, go west to Copper Canyon Wash and proceed south along Salt Mine Road approximately 1 mile to Lucky Canyon Wash. Station is located on the west bulkhead of a steel bridge. Station is the last river south in the center section of the bridge.
RM149	3044.40	U.S. Army Corps of Engineers 5/8-inch rebar with aluminum cap stamped USCE BM 14 1977 LA DIST, 28 feet southwest of Salt Mine Road, 62 feet north of fence.
RM150	3039.53	U.S. Army Corps of Engineers 5/8-inch rebar with aluminum cap stamped USCE BM 17 1977 LA DIST, 8 feet north-northeast from power pole at Y in dirt roads, 9 feet east of road.
RM151	3046.97	U.S. Army Corps of Engineers 5/8-inch rebar with aluminum cap stamped USCE RM 7 1977 LA DIST, 10 feet north-northeast from power pole at Y in dirt roads, 9 feet east of road.

- 1
- 2
- 2

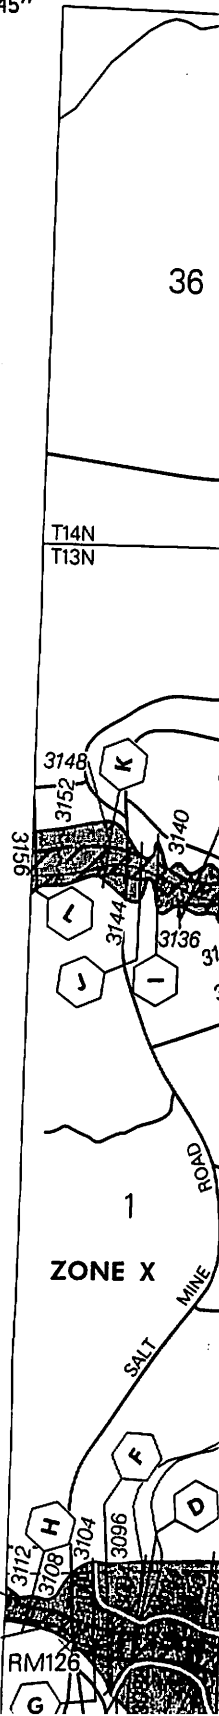

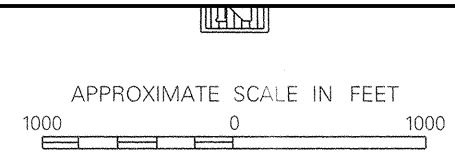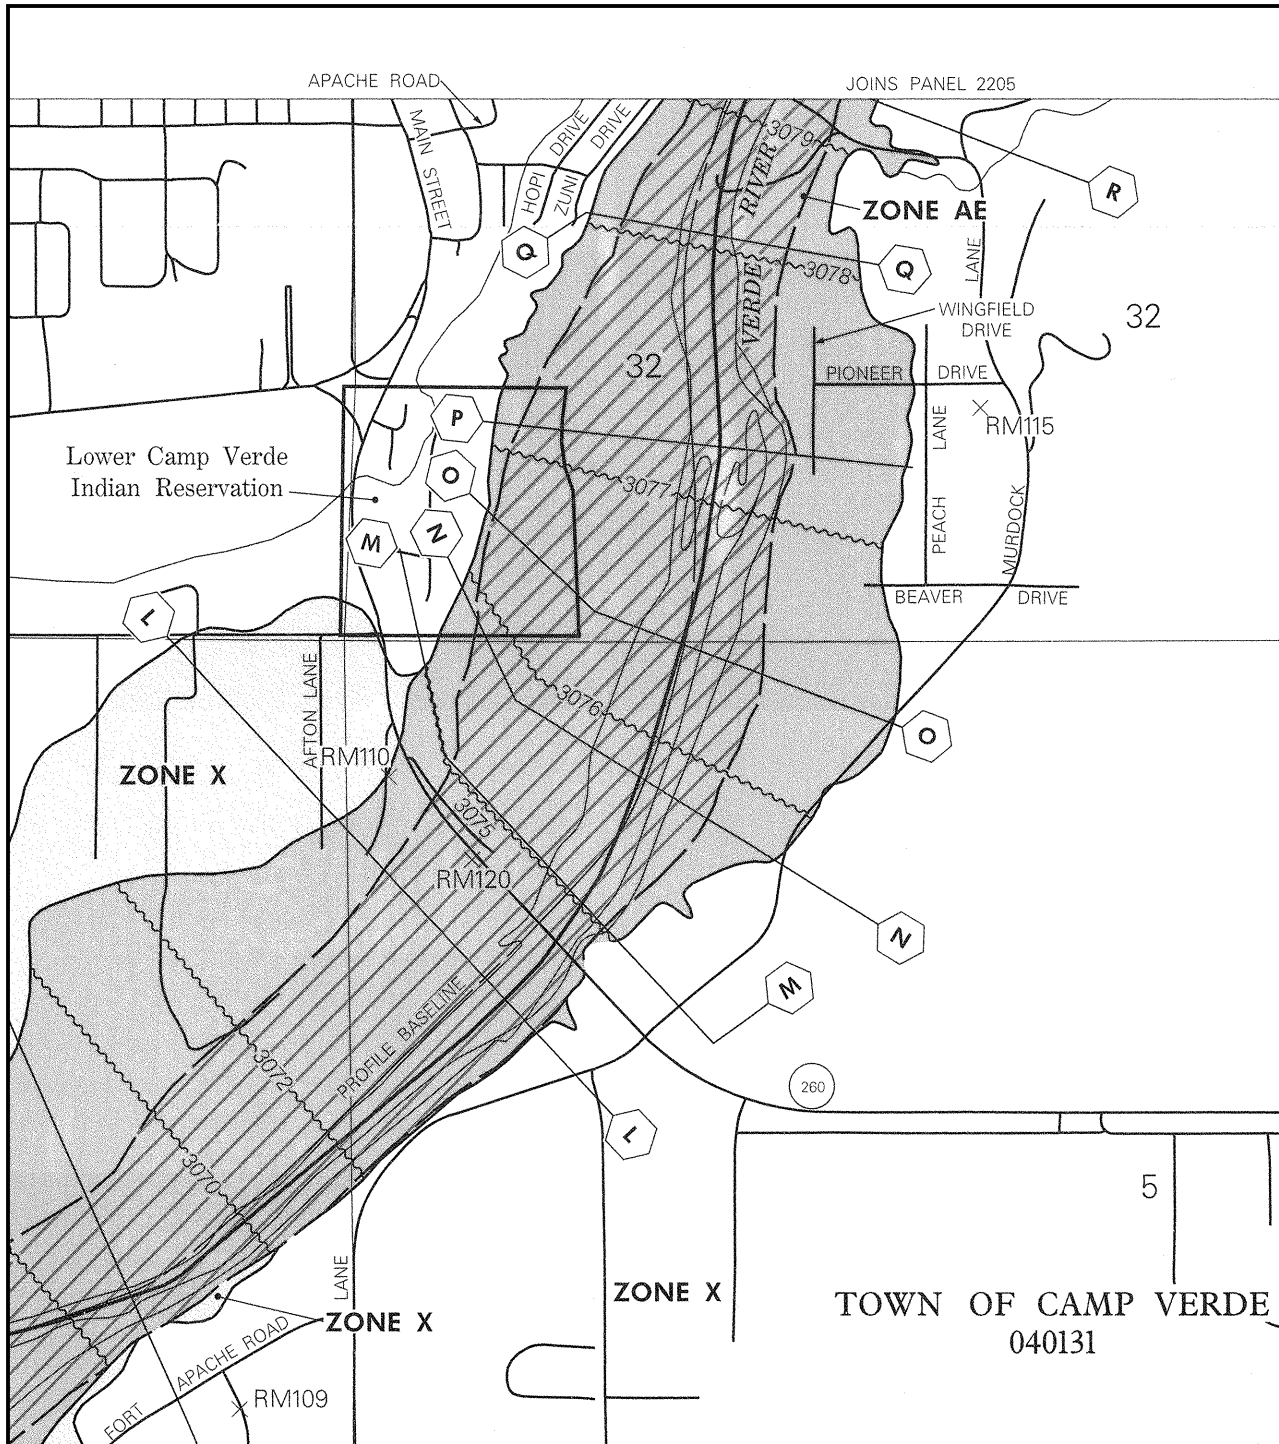

NATIONAL FLOOD INSURANCE PROGRAM

**FIRM
FLOOD INSURANCE RATE MAP**

**YAVAPAI COUNTY,
ARIZONA AND
INCORPORATED AREAS**

PANEL 2215 OF 3925
(SEE MAP INDEX FOR PANELS NOT PRINTED)

CONTAINS:

COMMUNITY	NUMBER	PANEL	SUFFIX
CAMP VERDE, TOWN OF	040131	2215	F
YAVAPAI COUNTY UNINCORPORATED AREAS	040093	2215	F

**MAP NUMBER
04025C2215 F**

**EFFECTIVE DATE:
JUNE 6, 2001**



Federal Emergency Management Agency

This is an official copy of a portion of the above referenced flood map. It was extracted using F-MIT On-Line. This map does not reflect changes or amendments which may have been made subsequent to the date on the title block. For the latest product information about National Flood Insurance Program flood maps check the FEMA Flood Map Store at www.msc.fema.gov