

## ELEVATION REFERENCE MONUMENT

**ERM:** 178

**Panel:** 3520

**Elevation (NAVD88):** 2472.17

**Elevation (NGVD29):** 2469.97

**Latitude:** 34°01'04" N

**Longitude:** 112°46'33" W

**Description:** Aerial Mapping Company 1/2-inch rebar with aluminum cap, approximately 1,100 feet west and approximately 1,300 feet north of northwest corner of Section 27, T8N, R5W, lays on top of mountain in Section 21 southeast corner, approximately 50 feet north of round concrete table top in cleared area.

3520

**NATIONAL FLOOD INSURANCE PROGRAM**

**FIRM**

ORIGINAL

**FLOOD INSURANCE RATE MAP**

**YAVAPAI COUNTY,  
ARIZONA AND  
INCORPORATED AREAS**

**PANEL 3520 OF 3925**

(SEE MAP INDEX FOR PANELS NOT PRINTED)

<u>CONTAINS</u> <u>COMMUNITY</u>	<u>NUMBER</u>	<u>PANEL</u>	<u>SUFFIX</u>
YAVAPAI COUNTY UNINCORPORATED AREAS	040093	3520	F

**MAP NUMBER  
04025C3520 F**

**EFFECTIVE DATE:  
JUNE 6, 2001**



Federal Emergency Management Agency

**A****B**112°48'45"  
34°03'45"

**ELEVATION REFERENCE MARKS**

REFERENCE MARK	ELEVATION (FEET NGVD)	DESCRIPTION OF LOCATION
----------------	-----------------------	-------------------------

RM178	2469.97	Aerial Mapping Company 1/2-inch rebar with aluminum cap, approximately 1,100 feet west and approximately 1,300 feet north of northwest corner of Section 27, T8N, R5W, lays on top of mountain in Section 21 southeast corner, approximately 50 feet north of round concrete table top in cleared area.
RM179	2296.88	Aerial Mapping Company 1/2-inch rebar with aluminum cap, approximately 2,000 feet south and approximately 400 feet west of northwest corner of Section 21, T8N, R5W, approximately 0.55 mile northwest of 606 along road, approximately 30 feet southwest of dirt road centerline, point lays in very faint road to southwest shown on quad map.
RM180	2378.82	U. S. Department of the Interior, Bureau of Land Management brass cap being the southeast corner of Section 8, T8N, R5W, with steel post and 4-inch by 4-inch wooden witness post.

ZONE A


6

ZONE A

7

1

2

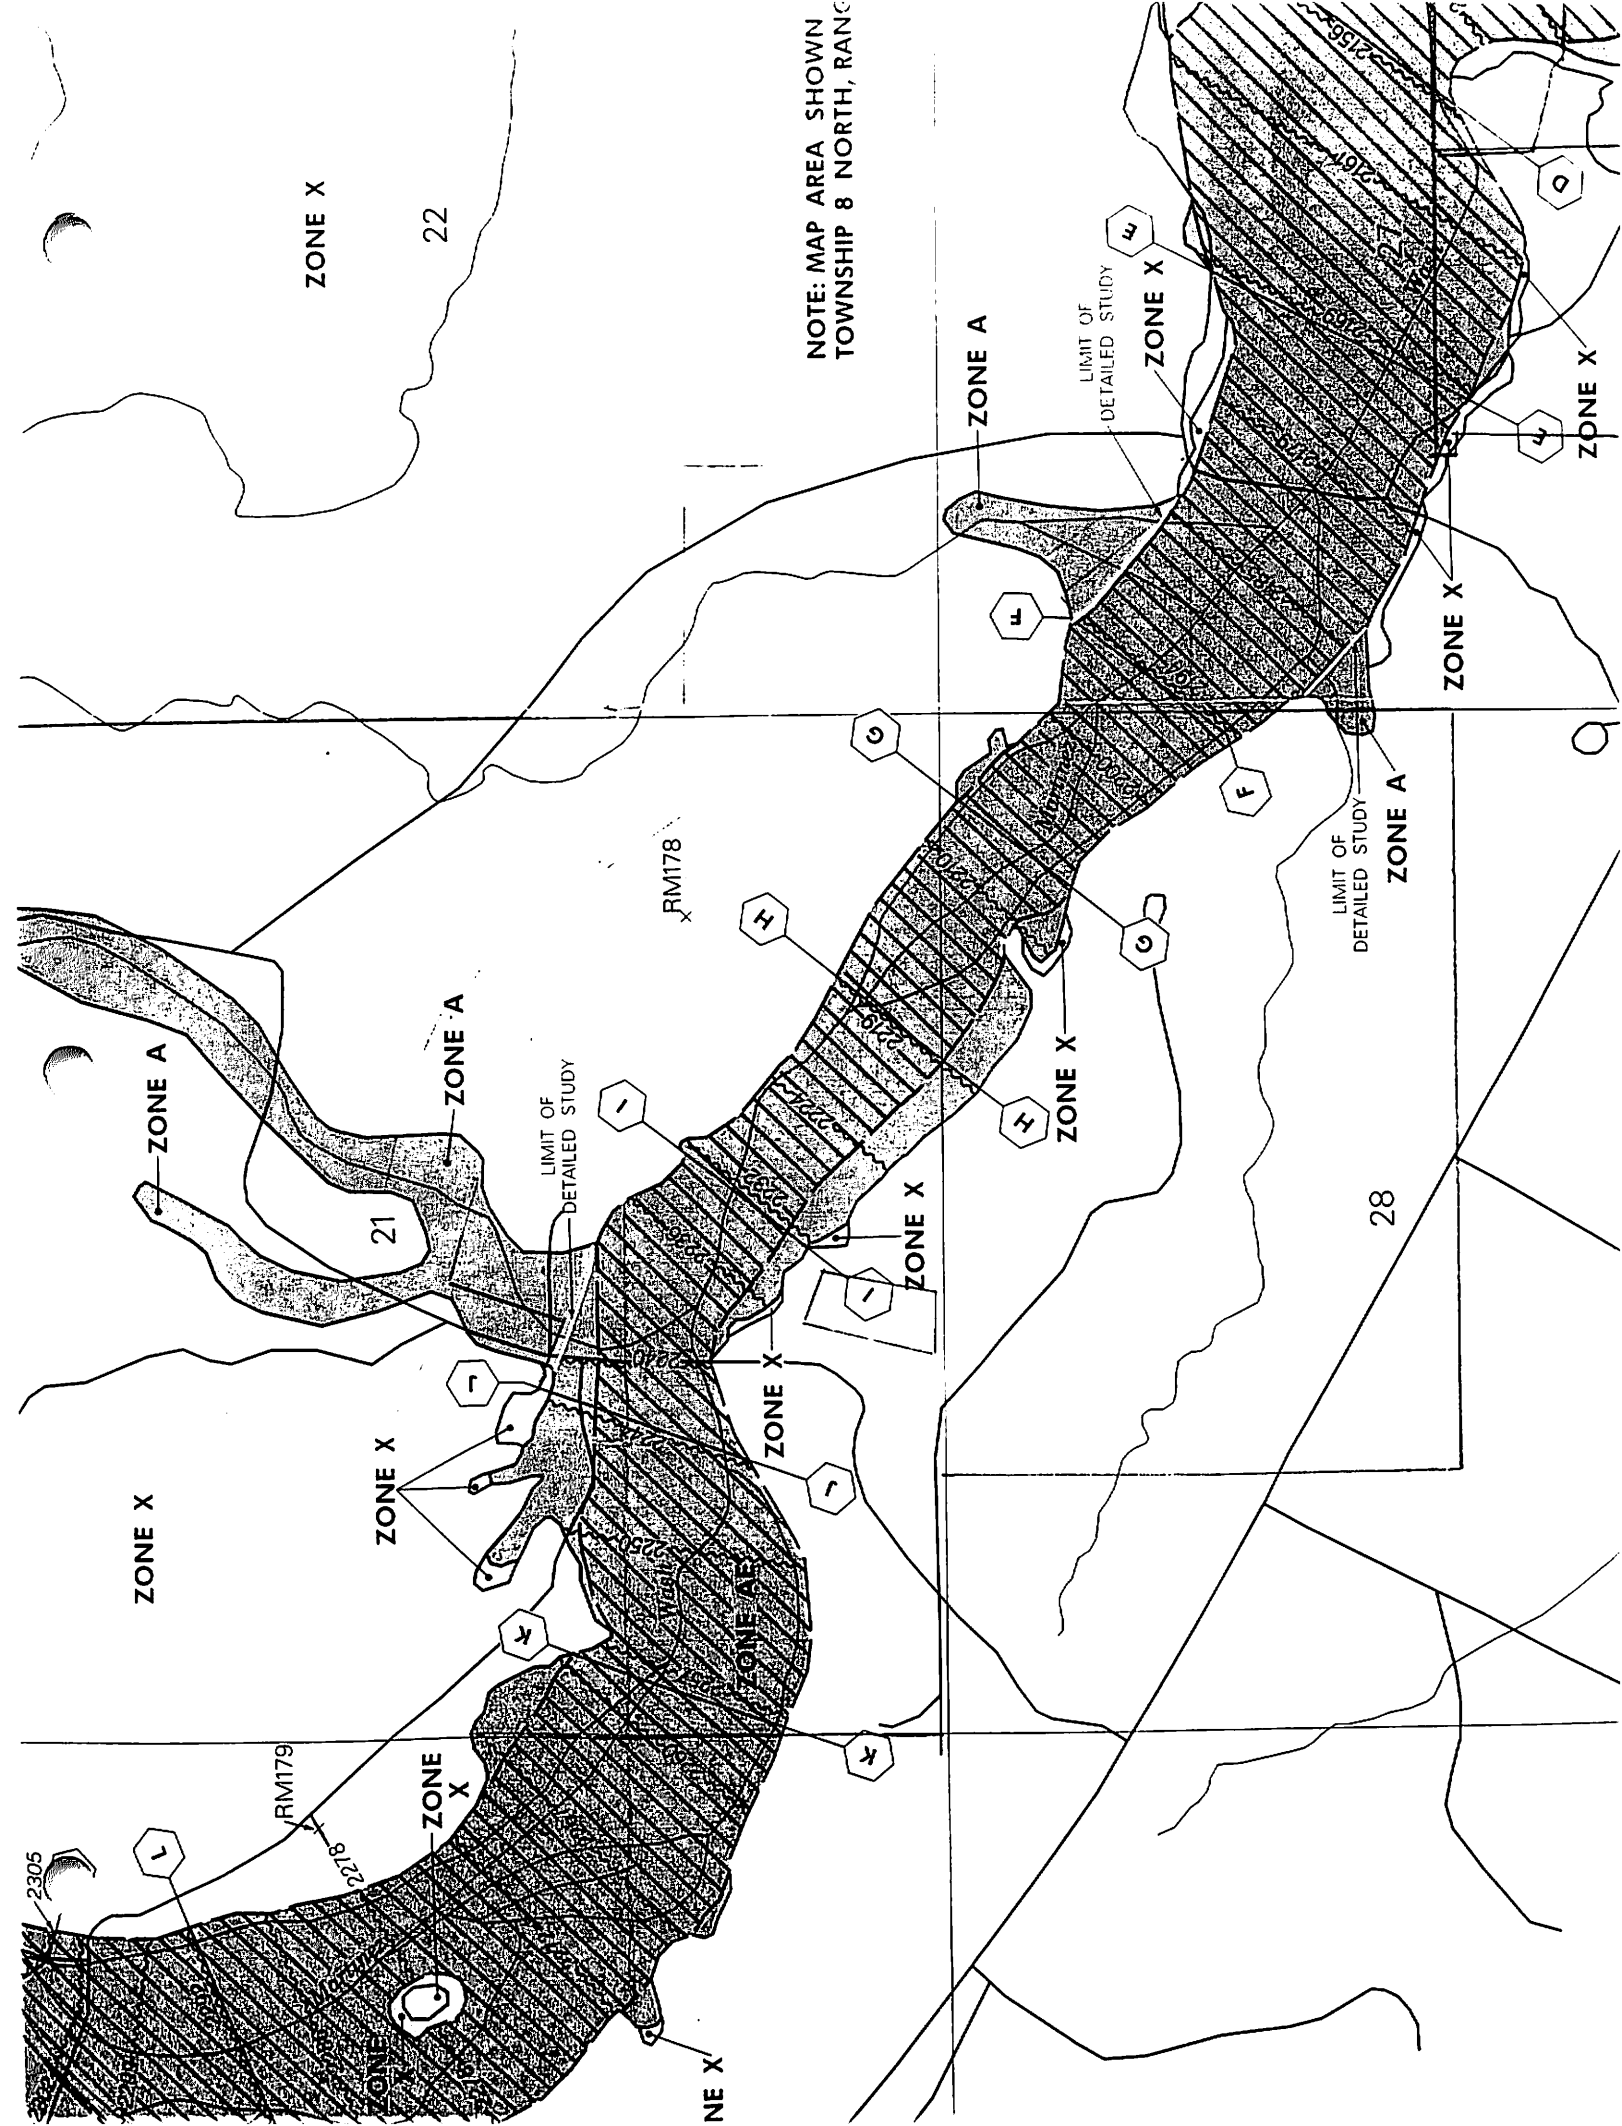

NOTE: MAP AREA SHOWN  
TOWNSHIP 8 NORTH, RANGE

ZONE X

22

ZONE A

LIMIT OF  
DETAILED STUDY

ZONE X

ZONE X

ZONE X

ZONE A

LIMIT OF  
DETAILED STUDY

RM178

ZONE A

LIMIT OF  
DETAILED STUDY

21

ZONE X

ZONE X

28

ZONE X

ZONE X

ZONE X

ZONE A

RM179

ZONE X

NE X

2305

2278