

ELEVATION REFERENCE MONUMENT

ERM: 188

Panel: 980

Elevation (NAVD88): 4544.28

Elevation (NGVD29): 4541.55


Latitude: 34°56'20" N

Longitude: 112°30'00" W

Description: From Paulden, Arizona, north on Highway 89 approximately 0.6 mile to Big Chino Road, then west (left) on Big Chino Road approximately 1.3 miles to Patricia Road, north (right) on Patricia Road approximately 2.7 miles to Barbara Road. West (left) on Barbara Road approximately 0.75 mile to monument.



APPROXIMATE SCALE IN FEET

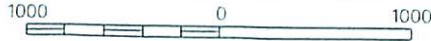

980

NATIONAL FLOOD INSURANCE PROGRAM

FIRM *ORIGINAL*
FLOOD INSURANCE RATE MAP

**YAVAPAI COUNTY,
ARIZONA AND
INCORPORATED AREAS**

PANEL 980 OF 3925

(SEE MAP INDEX FOR PANELS NOT PRINTED)

CONTAINS:

<u>COMMUNITY</u>	<u>NUMBER</u>	<u>PANEL</u>	<u>SUFFIX</u>
------------------	---------------	--------------	---------------

YAVAPAI COUNTY, UNINCORPORATED AREAS	040093	0980	F
---	--------	------	---

None

**MAP NUMBER
04025C0980 F**

**EFFECTIVE DATE:
JUNE 6, 2001**



Federal Emergency Management Agency

A

B

112°30'00"
35°00'00"


ELEVATION REFERENCE MARKS

REFERENCE MARK	ELEVATION (FEET NGVD)	DESCRIPTION OF LOCATION
585-7 RM16	4540.20	From Paulden, Arizona, north on Highway 89 approximately 0.6 mile to Big Chino Road, then west (left) on Big Chino Road approximately 1.3 miles to Patricia Road. North (right) on Patricia Road approximately 2.7 miles to monument.
585-8 RM17	4602.84	From Paulden, Arizona, north on Highway 89 approximately 0.6 mile to Big Chino Road, west (left) on Big Chino Road approximately 1.3 miles to Patricia Road. North (right) on Patricia Road approximately 2.7 miles to Barbara Road, then east (right) on Barbara Road approximately 0.6 mile to monument.
585-3 RM188	4541.55	From Paulden, Arizona, north on Highway 89 approximately 0.6 mile to Big Chino Road, then west (left) on Big Chino Road approximately 1.3 miles to Patricia Road, north (right) on Patricia Road approximately 2.7 miles to Barbara Road. West (left) on Barbara Road approximately 0.75 mile to monument.

All missing

T19N

T18N

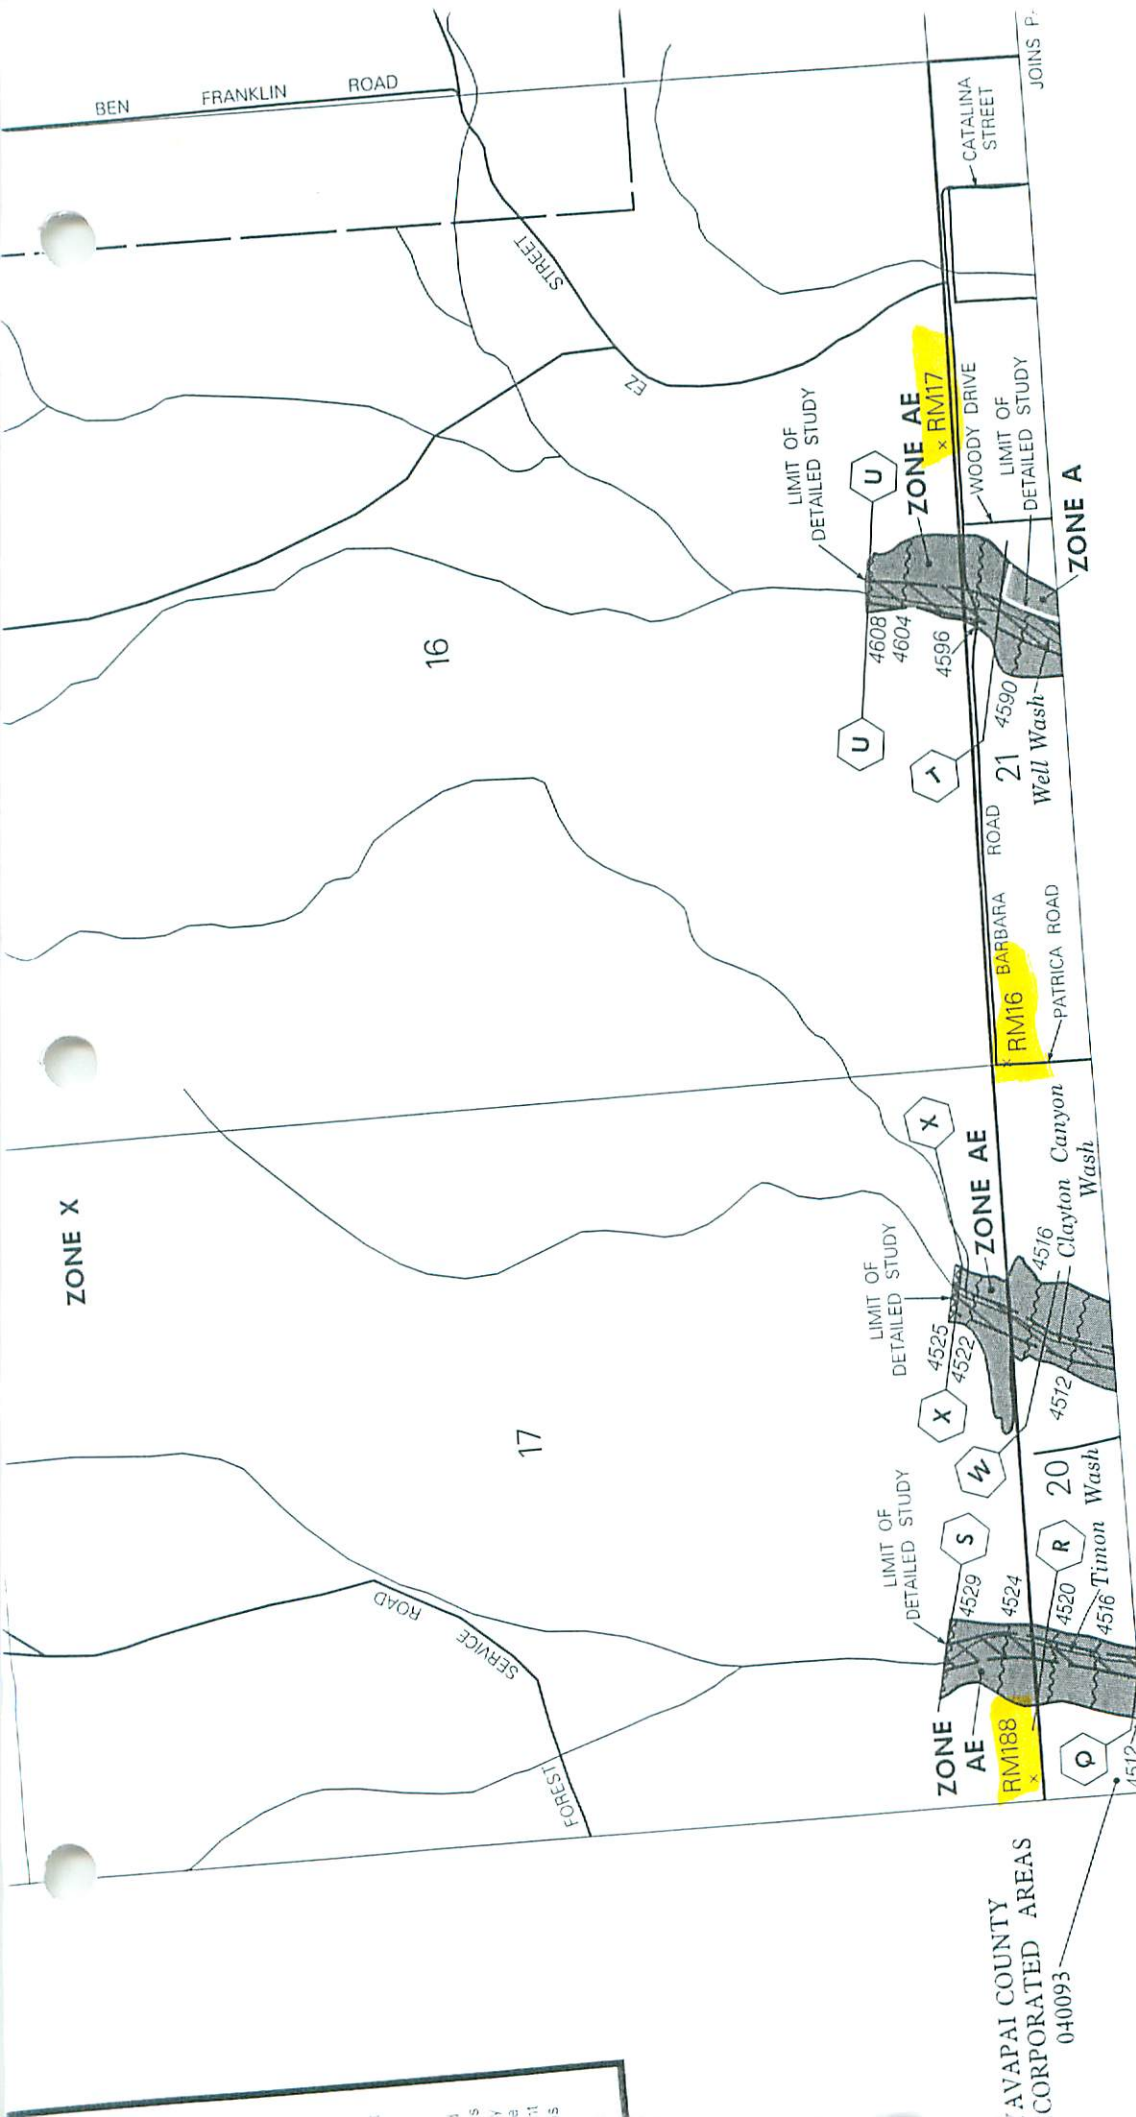

AVAPAI COUNTY
CORPORATED AREAS
040093

34°56'15"
112°30'00"

Particularly from
c. features outside
position should be
any information on
party purchase or
Zones A, AE, A1-
be protected by
ss sections and
were based on
of the E-4-