

## ELEVATION REFERENCE MONUMENT

**ERM:** 2

**Panel:** 2500

**Elevation (NAVD88):** 0.00


**Elevation (NGVD29):** ??

**Latitude:** 34°27'20.52000" N

**Longitude:** 112°17'05.52001" W

**Description:** Station is located approximately 1.2 miles westerly along Poland Road from the intersection of Highway 69 & Poland Road. Station is on the east side of Poland Road.



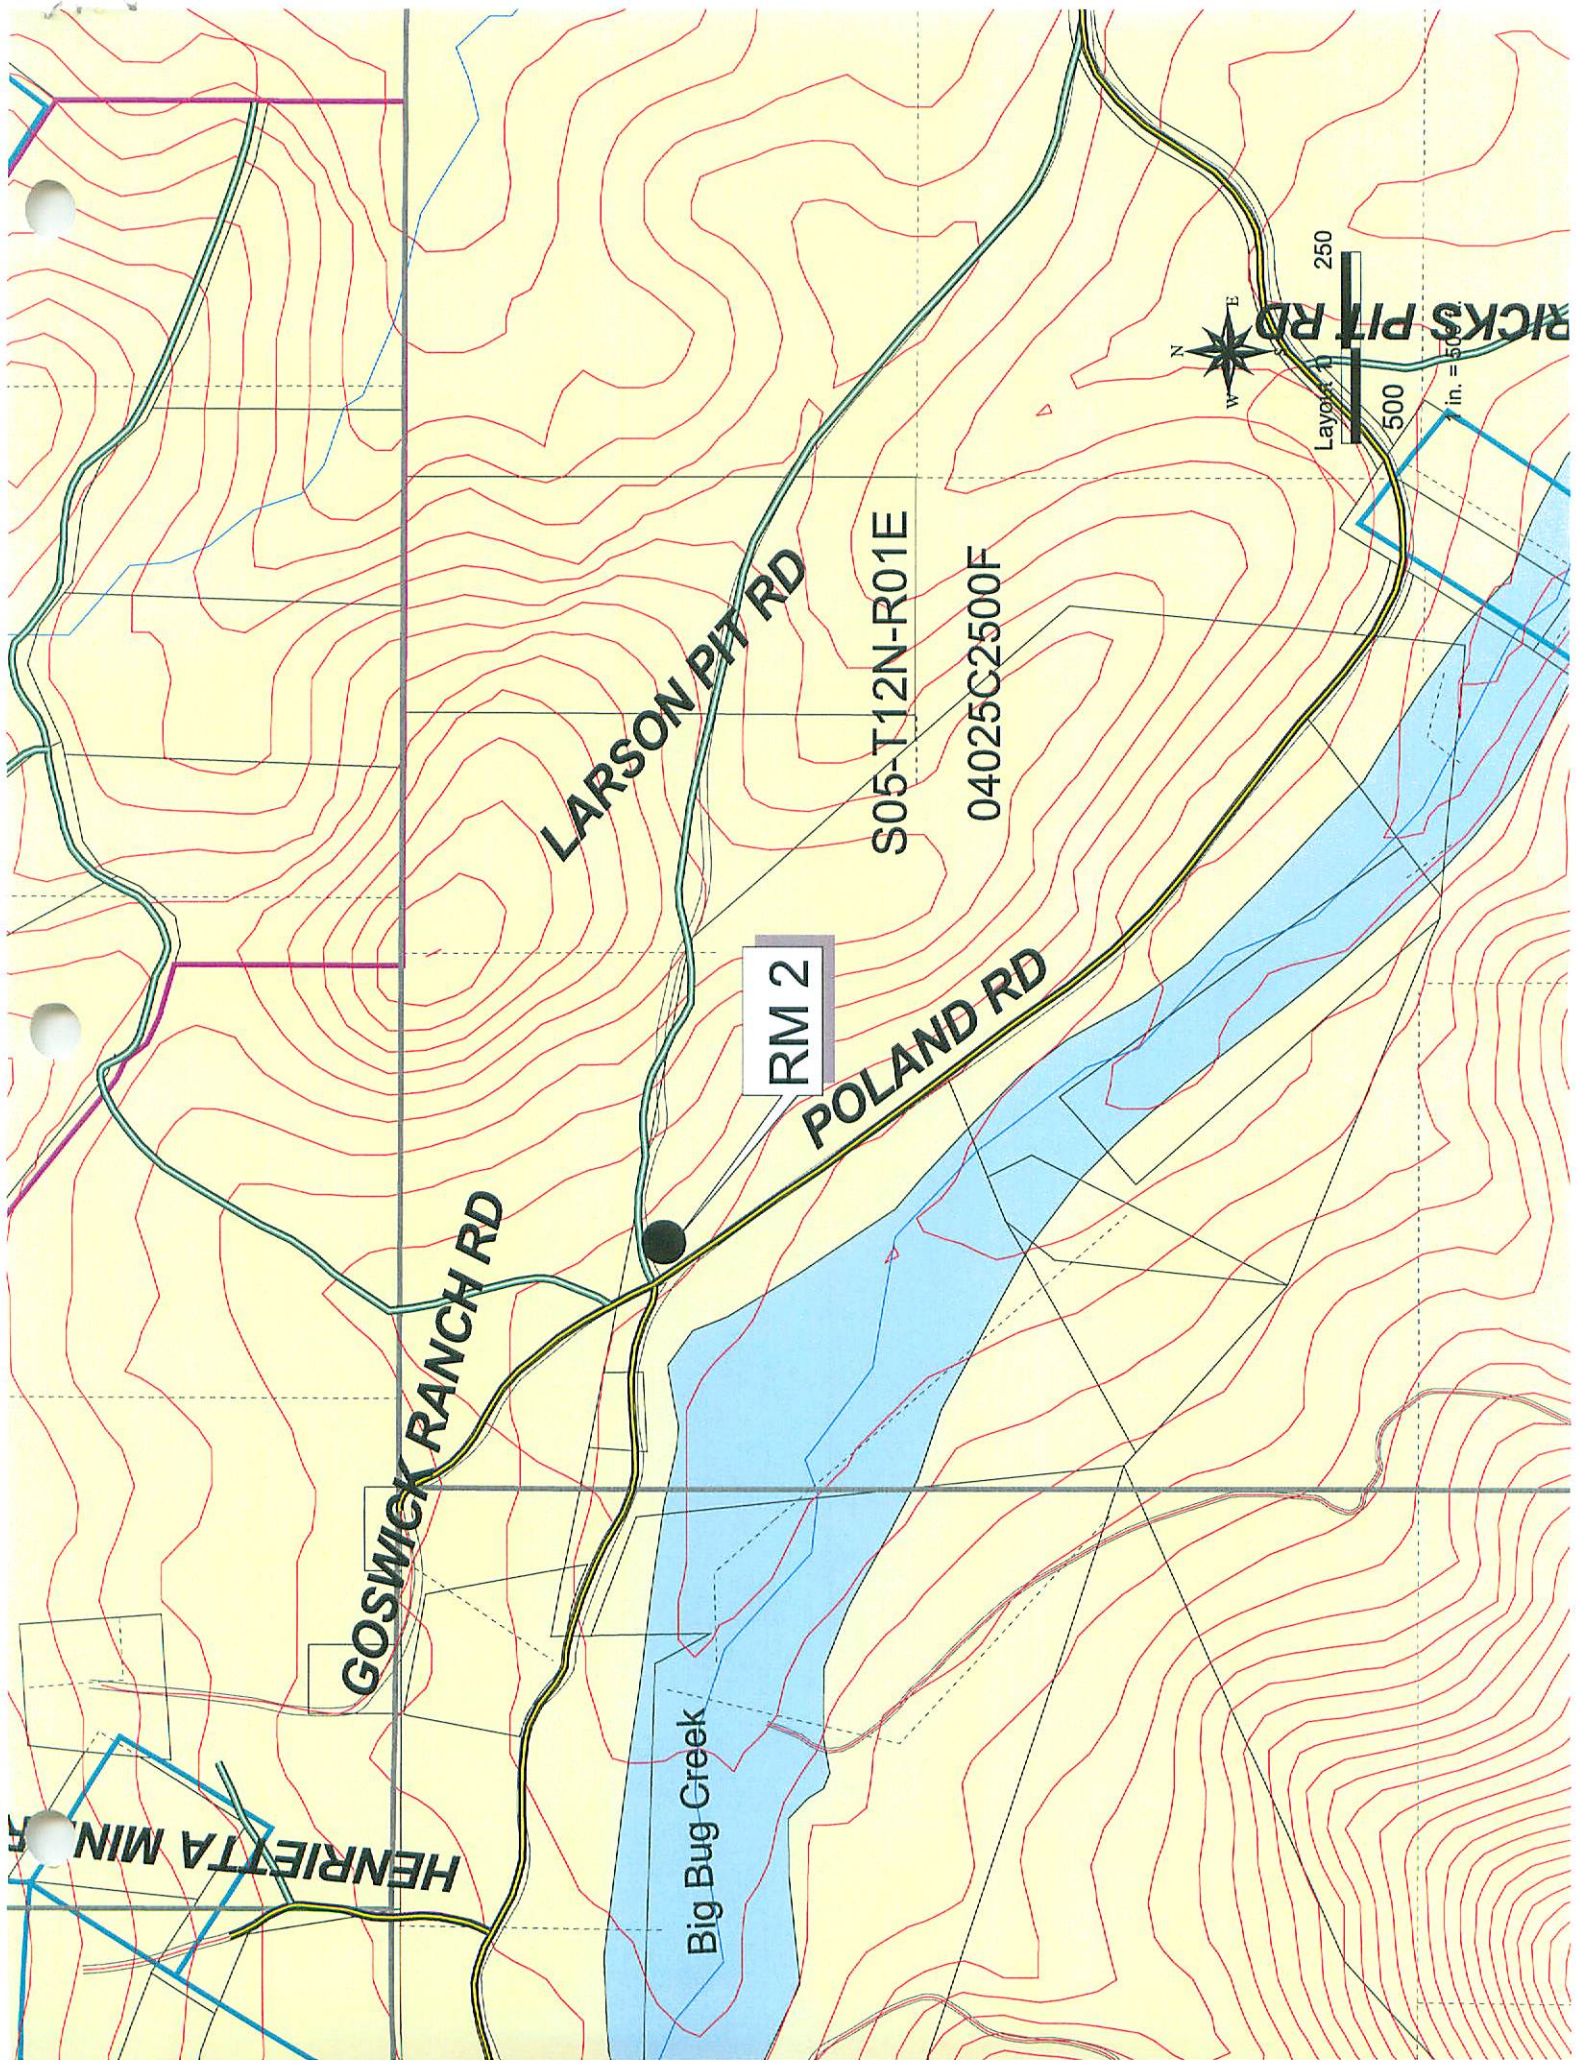

HENRIETTA MINER

GOSWICK RANCH RD

LARSON PIT RD

RM 2

POLAND RD

Big Bug Creek

S05-T12N-R01E

04025G2500F



250  
500  
in. = 500'

RICKS PIT RD