

ELEVATION CERTIFICATE

Important: Read the instructions on pages 1 - 7.

SECTION A - PROPERTY OWNER INFORMATION

BUILDING OWNER'S NAME <i>Guy and Amy Graham</i>		For Insurance Company Use: Policy Number	
BUILDING STREET ADDRESS (including Apt., Unit, Suite, and/or Bldg. No.) OR P.O. ROUTE AND BOX NO. <i>2650 W. Granite Park Place</i>		Company NAIC Number	
CITY <i>Prescott</i>	STATE <i>Arizona</i>	ZIP CODE	
PROPERTY DESCRIPTION (Lot and Block Numbers, Tax Parcel Number, Legal Description, etc.) <i>APN # 102-18-028</i>			
BUILDING USE (e.g., Residential, Non-residential, Addition, Accessory, etc. Use Comments area if necessary.) <i>Residential</i>			
LATITUDE/LONGITUDE (OPTIONAL) (##° - ##' - ##.###" or ##.#####°)	HORIZONTAL DATUM: <input type="checkbox"/> NAD 1927 <input type="checkbox"/> NAD 1983	SOURCE: <input type="checkbox"/> GPS (Type): _____ <input type="checkbox"/> USGS Quad Map <input type="checkbox"/> Other: _____	

SECTION B - FLOOD INSURANCE RATE MAP (FIRM) INFORMATION

B1. NFIP COMMUNITY NAME & COMMUNITY NUMBER <i>Yavapai County 040093</i>		B2. COUNTY NAME <i>Yavapai County</i>		B3. STATE <i>Arizona</i>	
B4. MAP AND PANEL NUMBER <i>04025C 1695</i>	B5. SUFFIX <i>F</i>	B6. FIRM INDEX DATE <i>6/6/01</i>	B7. FIRM PANEL EFFECTIVE/REVISED DATE <i>6/6/01</i>	B8. FLOOD ZONES <i>unshaded X</i>	B9. BASE FLOOD ELEVATION(S)

B10. Indicate the source of the Base Flood Elevation (BFE) data or base flood depth entered in B9.
 FIS Profile FIRM Community Determined Other (Describe): _____

B11. Indicate the elevation datum used for the BFE in B9: NGVD 1929 NAVD 1988 Other (Describe): _____

B12. Is the building located in a Coastal Barrier Resources System (CBRS) area or Otherwise Protected Area (OPA)? Yes No
Designation Date: _____

SECTION C - BUILDING ELEVATION INFORMATION (SURVEY REQUIRED)


C1. Building elevations are based on: Construction Drawings* Building Under Construction* Finished Construction
*A new Elevation Certificate will be required when construction of the building is complete.

C2. Building Diagram Number *8* (Select the building diagram most similar to the building for which this certificate is being completed - see pages 6 and 7. If no diagram accurately represents the building, provide a sketch or photograph.)

C3. Elevations - Zones A1-A30, AE, AH, A (with BFE), VE, V1-V30, V (with BFE), AR, AR/A, AR/AE, AR/A1-A30, AR/AH, AR/AO
Complete Items C3.a-i below according to the building diagram specified in Item C2. State the datum used. If the datum is different from the datum used for the BFE in Section B, convert the datum to that used for the BFE. Show field measurements and datum conversion calculation. Use the space provided or the Comments area of Section D or Section G, as appropriate, to document the datum conversion.
Datum _____ Conversion/Comments _____

Elevation reference mark used _____ Does the elevation reference mark used appear on the FIRM? Yes No

<input type="checkbox"/> a) Top of bottom floor (including basement or enclosure) _____ ft.(m)	License Number, Embossed Seal, Signature, and Date
<input type="checkbox"/> b) Top of next higher floor _____ ft.(m)	
<input type="checkbox"/> c) Bottom of lowest horizontal structural member (V zones only) _____ ft.(m)	
<input type="checkbox"/> d) Attached garage (top of slab) _____ ft.(m)	
<input type="checkbox"/> e) Lowest elevation of machinery and/or equipment servicing the building (Describe in a Comments area.) _____ ft.(m)	
<input type="checkbox"/> f) Lowest adjacent (finished) grade (LAG) _____ ft.(m)	
<input type="checkbox"/> g) Highest adjacent (finished) grade (HAG) _____ ft.(m)	
<input type="checkbox"/> h) No. of permanent openings (flood vents) within 1 ft. above adjacent grade _____	
<input type="checkbox"/> i) Total area of all permanent openings (flood vents) in C3.h _____ sq. in. (sq. cm)	

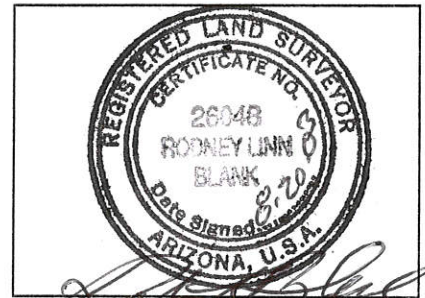

SECTION D - SURVEYOR, ENGINEER, OR ARCHITECT CERTIFICATION

This certification is to be signed and sealed by a land surveyor, engineer, or architect authorized by law to certify elevation information. I certify that the information in Sections A, B, and C on this certificate represents my best efforts to interpret the data available. I understand that any false statement may be punishable by fine or imprisonment under 18 U.S. Code, Section 1001.

CERTIFIER'S NAME <i>Rodney L. Blank</i>		LICENSE NUMBER <i>R.S.L 26048</i>	
TITLE <i>Pres.</i>	COMPANY NAME <i>Contract Surveying, Inc</i>		
ADDRESS <i>707 El Camino Colorado</i>	CITY <i>Prescott</i>	STATE <i>AZ</i>	ZIP CODE <i>86301</i>
SIGNATURE <i>Rodney L. Blank</i>	DATE <i>8/16/07</i>	TELEPHONE <i>(928) 778-0636</i>	

IMPORTANT: In these spaces, copy the corresponding information from Section A.		For Insurance Company Use:	
BUILDING STREET ADDRESS (Including Apt., Unit, Suite, and/or Bldg. No.) OR P.O. ROUTE AND BOX NO.		Policy Number	
CITY	STATE	ZIP CODE	Company NAIC Number

2650 W. GRANITE PARK PARK RESUIT AZ 85039

SECTION D - SURVEYOR, ENGINEER, OR ARCHITECT CERTIFICATION (CONTINUED)

Copy both sides of this Elevation Certificate for (1) community official, (2) insurance agent/company, and (3) building owner.

COMMENTS SEE ATTACHMENT BY R.C.S. ROADWAY BANK.

Check here if attachments

SECTION E - BUILDING ELEVATION INFORMATION (SURVEY NOT REQUIRED) FOR ZONE AO AND ZONE A (WITHOUT BFE)

For Zone AO and Zone A (without BFE), complete Items E1. through E4. If the Elevation Certificate is intended for use as supporting information for a LOMA or LOMR-F, Section C must be completed.

- E1. Building Diagram Number _____ (Select the building diagram most similar to the building for which this certificate is being completed - see pages 6 and 7. If no diagram accurately represents the building, provide a sketch or photograph.)
- E2. The top of the bottom floor (including basement or enclosure) of the building is _____ ft.(m) _____ in.(cm) _____ above or _____ below (check one) the highest adjacent grade. (Use natural grade, if available.)
- E3. For Building Diagrams 6-8 with openings (see page 7), the next higher floor or elevated floor (elevation b) of the building is _____ ft.(m) _____ in.(cm) above the highest adjacent grade.
- E4. The top of the platform of machinery and/or equipment servicing the building is _____ ft. (m) _____ in. (cm) _____ above or _____ below (check one) the highest adjacent grade. (Use natural grade, if available.)
- E5. For Zone AO only: If no flood depth number is available, is the top of the bottom floor elevated in accordance with the community's floodplain management ordinance? Yes No Unknown. The local official must certify this information in Section G.

SECTION F - PROPERTY OWNER (OR OWNER'S REPRESENTATIVE) CERTIFICATION

The property owner or owner's authorized representative who completes Sections A, B, C (Items C3.h and C3.i only), and E for Zone A (without a FEMA-issued or community-issued BFE) or Zone AO must sign here. The statements in Sections A, B, C, and E are correct to the best of my knowledge.

PROPERTY OWNER'S OR OWNER'S AUTHORIZED REPRESENTATIVE'S NAME _____

ADDRESS	CITY	STATE	ZIP CODE
SIGNATURE	DATE	TELEPHONE	

COMMENTS _____

Check here if attachments

SECTION G - COMMUNITY INFORMATION (OPTIONAL)

The local official who is authorized by law or ordinance to administer the community's floodplain management ordinance can complete Sections A, B, C (or E), and G of this Elevation Certificate. Complete the applicable item(s) and sign below.

- G1. The information in Section C was taken from other documentation that has been signed and embossed by a licensed surveyor, engineer, or architect who is authorized by state or local law to certify elevation information. (Indicate the source and date of the elevation data in the Comments area below.)
- G2. A community official completed Section E for a building located in Zone A (without a FEMA-issued or community-issued BFE) or Zone AO.
- G3. The following information (Items G4-G9) is provided for community floodplain management purposes.

G4. PERMIT NUMBER	G5. DATE PERMIT ISSUED	G6. DATE CERTIFICATE OF COMPLIANCE/OCCUPANCY ISSUED
-------------------	------------------------	---

G7. This permit has been issued for: New Construction Substantial Improvement

G8. Elevation of as-built lowest floor (including basement) of the building is: _____ . _____ ft.(m) Datum: _____

G9. BFE or (in Zone AO) depth of flooding at the building site is: _____ . _____ ft.(m) Datum: _____

LOCAL OFFICIAL'S NAME	TITLE
COMMUNITY NAME	TELEPHONE
SIGNATURE	DATE

COMMENTS _____

Check here if attachments


GRANITE FOOTHILLS

S 41°45'48" W
219.07

WILLIAMSON VALLEY ROAD

F/GRADE 5229.0 +/-

28

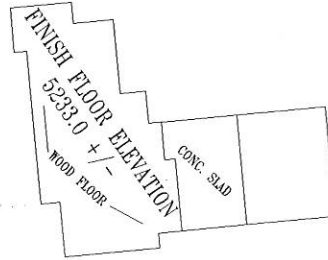

F/GRADE 5232.6.0 +/-

F/GRADE 5230.0 +/-

27

N 0°52'19" W
292.23

278.52

N 0°52'19" W

29

S 87°38'27" W

207.00



SCALE: 1" = 60'

2650 GRANITE PARK PLACE

NOTE: STRUCTURE IS STICK FRAME, NEW CONSTRUCTION ON CONCRETE SLAB AND OR WOOD, MIN.F/F= 5229.30 +/-
 BENCHMARK AS PER FINAL PLAT OF GRANITE PARK RANCH, RECORD 34 & PAGE 34 OF MAPS. Y.C.R.O.
 RM 62 ELEVATION 5257.77 U.S. G&S BRASS CAP SEC. 25, T15N, R2W.

CONTRACT SURVEYING, INC.
 ROD BLANK R. L. S.
 707 EL CAMINO CORVO LN.
 PRESCOTT, ARIZONA 86301
 928-778-0636

(FEMA) ELEVATION CERIFICATE OF FINISH FLOOR

GRANITE PARK RANCH, LOT #28

YAVAPAI, COUNTY ARIZONA

SCALE: 1" = 60'	DATE: 8-20-03	FILE #: GRANPK28	JOB #:
FOR: EVERGREEN HOMES, (GRAHAMN OWNER)			PARCEL #: 102-18-028

ELEVATION OF FLOODPLAIN PROPERTY

When Completed Return To: YAVAPAI COUNTY DEVELOPMENT SERVICES - FLOODPLAIN UNIT

500 S. Marina St., Prescott, AZ, 86303 (928) 771-3197 FAX (928) 771-3427 Office: Prescott X
10 S. 6th St., Cottonwood, AZ 86326 (928) 639-8151 FAX (928) 639-8118 Cottonwood

DATE AUGUST 20, 2003

ASSESSOR'S PARCEL NUMBER 102-18-028

SUBDIVISION NAME UNIT/PHASE AND LOT NUMBER GRANITE PARK PARK # 28

OWNER GUY & AMY GRAHAM

SITUS ADDRESS 2650 W. GRANITE PARK PLACE PRESCOTT AZ 86301

BASE BENCHMARK: Number BM 62 Elevation 5257.77

PROPERTY BENCHMARK GRANITE PARK PARK # 34/34 ^{BK 06.}

DESCRIPTION OF PROPERTY BENCHMARK U.S. GENERAL AND SURVEY BEARS CORNER, 3" DIA. PIPE. BEING S/E CORNER OF SEC. 25, T15N, R3W

GROUND ELEVATIONS AT BUILDING SITE 5230.00 +/-
(Please provide a minimum of three (3) elevation points, representative of the site)

Sketch of Lot
(include location of property benchmark and building site elevations)

Remarks (SBE)
(ATTACHMENT)



R. L. Blair

(Seal)

Signed R. L. Blair
Company Name CONTRACT SURVEYING, INC.
Address 707 EC CAMP COCKE LN.
PRESCOTT, AZ 86301
Telephone 928-770-0636

FOR YAVAPAI COUNTY FLOOD CONTROL DISTRICT USE: Date: 8/20/03

Base Flood Elevation + 1.0' = Regulatory Elevation

* ELEVATION DETERMINATIONS ARE BASED ON BEST AVAILABLE DATA WHEN CALCULATED. ELEVATIONS ARE SUBJECT TO CHANGE WHEN NEW OR REVISED FLOOD STUDIES OR DATA IS SUPPLIED TO THE DISTRICT.